

DURABLE 4" WHITE LINE
 STA 0+030 ~ 0+182 LT & RT (EDGE--SOLID)
 STA 0+030 ~ 0+121 LT (LANE LINE--SOLID)
 STA 0+121 ~ 0+144 LT (LANE LINE--DOTTED)

DURABLE 4" YELLOW LINE
 STA 0+030 ~ 0+182 LT & RT (EDGE--SOLID)

DURABLE LETTER OR SYMBOL
 STA 0+119 LT (LT. ARROW)


TEMPORARY LETTER OR SYMBOL
 STA 0+115 LT (LT. ARROW)

STEEL BEAM GUARDRAIL
 STA ~~0+056~~ ~ 0+182 RT
 0+076

REHABILITATION OF DI
 0+060 CL
 0+136 CL

MAUFACTURED TERMINAL SECTION (FLARED)
 STA ~~0+045~~ ~ 0+056 RT
 0+065 - 0+076

REMOVE & DISPOSE GUARDRAIL
 STA ~~0+045~~ ~ 0+182 RT
 0+065

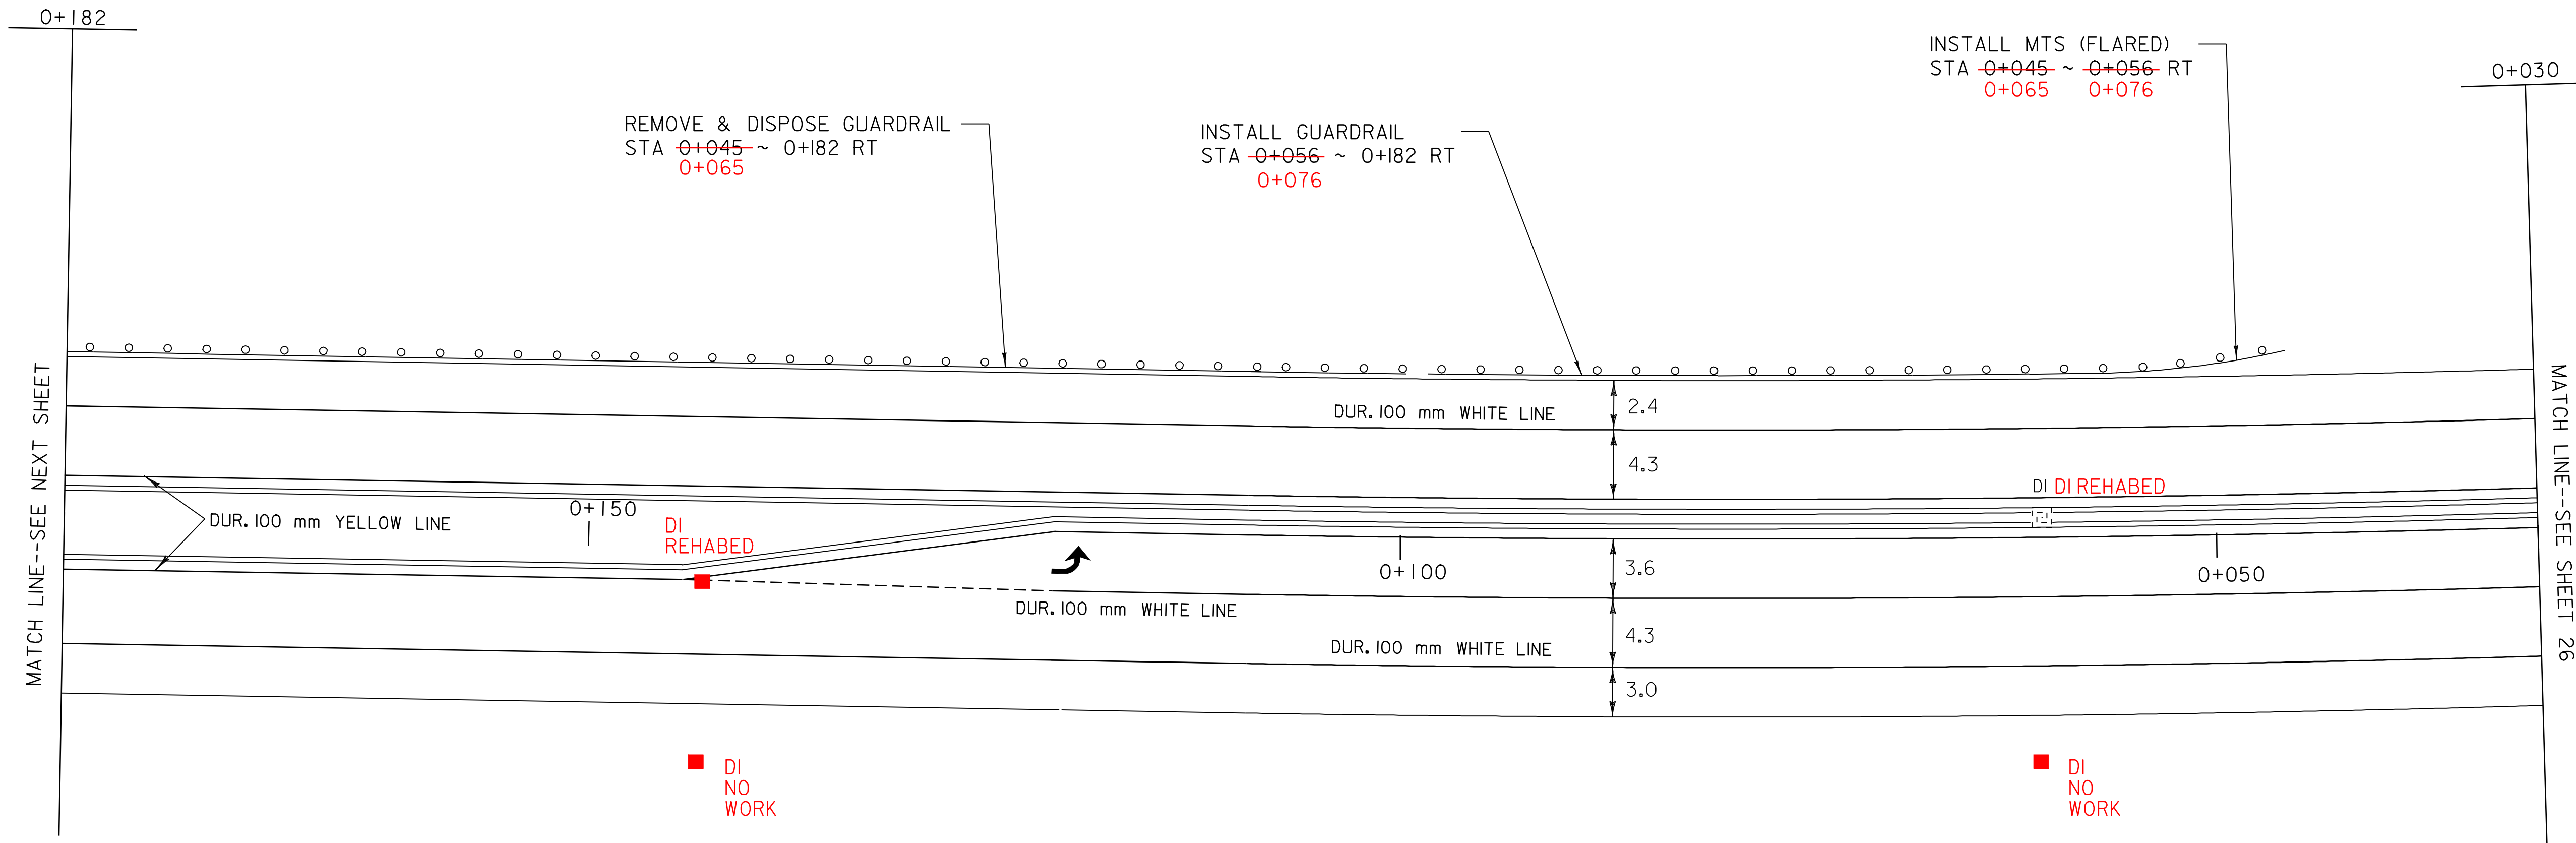

VT RTE 58 LAYOUT # 21	PROJECT NAME: BARTON-IRASBURG PROJECT NUMBER: STP 2107(I)S
	FILE NAME: pave/98c096/pc096.dgn PROJECT LEADER: MW DESIGNED BY: JLR pc096i21.i