

DURABLE LETTERS
ETHAN ALLEN RD STOP

DURABLE 200mm YELLOW LINE
0+220 - 0+235 CL

DURABLE 600mm WHITE LINE
ETHAN ALLEN RD


REMOVING SIGNS
AS SHOWN - 6-7

DURABLE 4" WHITE LINE
STA 0+182 ~ 0+258 LT & RT (EDGE--ISLAND--SOLID)

DURABLE 4" YELLOW LINE
STA 0+182 ~ 0+212 LT & RT (EDGE--ISLAND--SOLID)
STA 0+182 ~ 0+258 C.L. (DBL. SOLID)

STEEL BEAM GUARD RAIL
STA 0+182 ~ 0+278 RT

REMOVE & DISPOSE GUARD RAIL
STA 0+182 ~ 0+278 RT

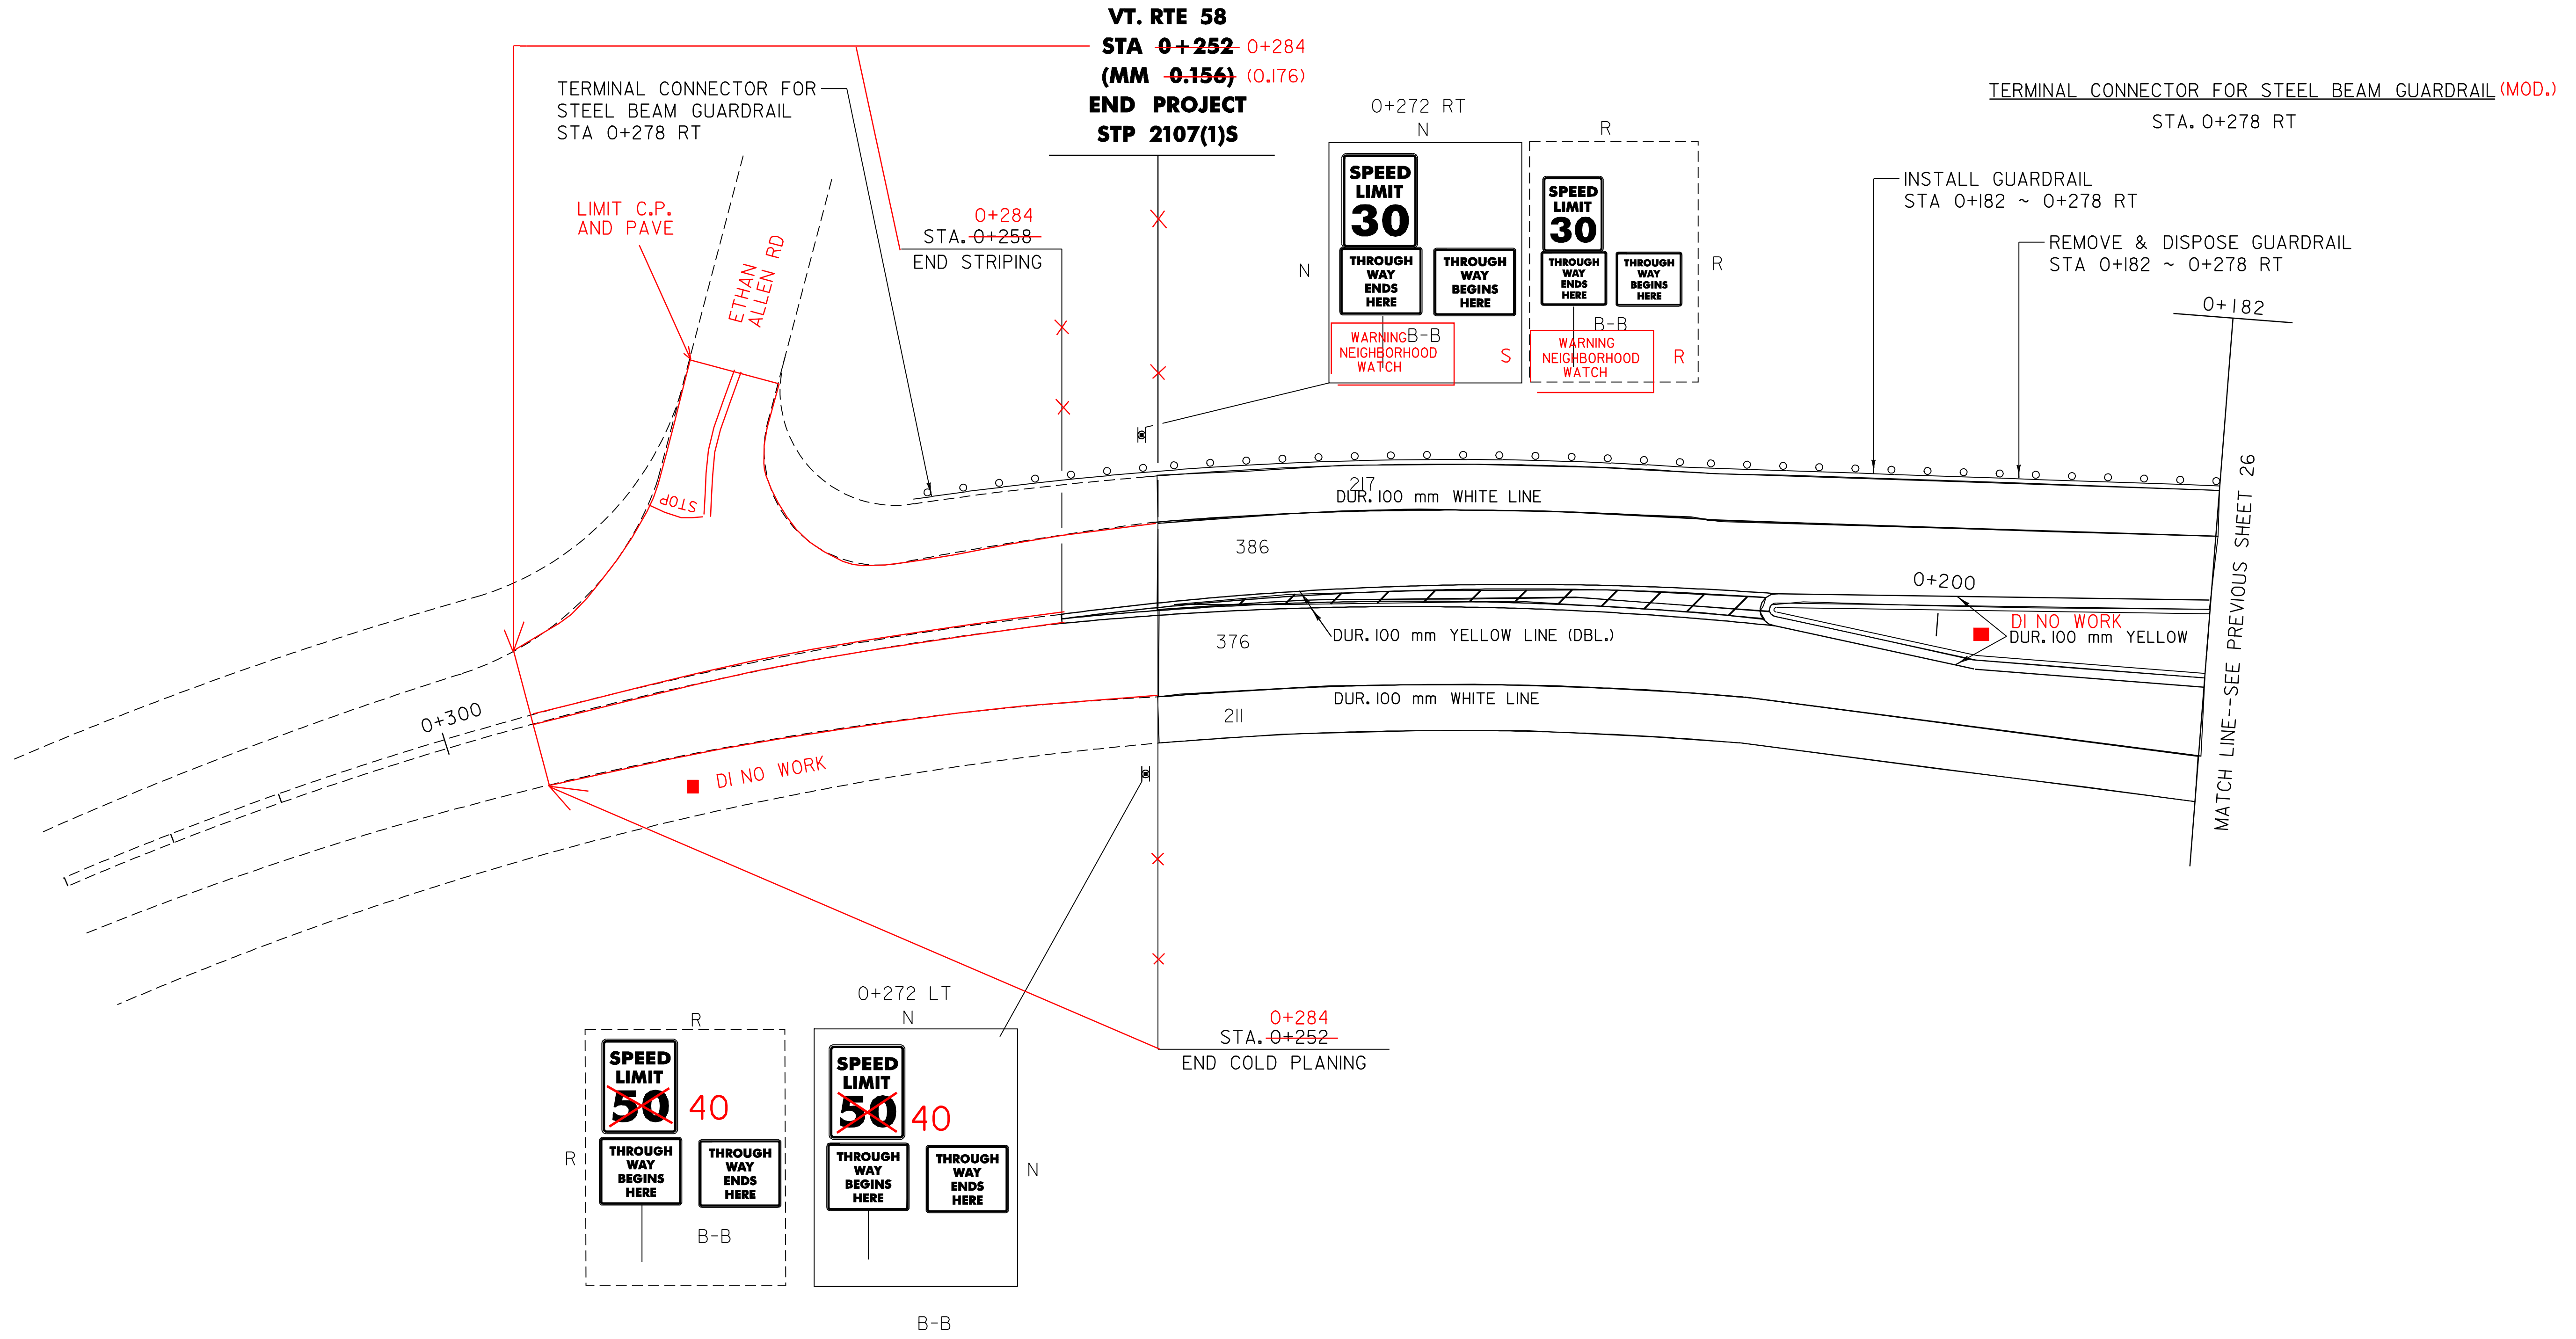

VT RTE 58 LAYOUT # 22	PROJECT NAME: BARTON-IRASBURG	PLOT DATE: 21-MAY-2007 13:12
	PROJECT NUMBER: STP 2107(1)S	DRAWN BY:
	FILE NAME: pave/98c096/pc096a.dgn	CHECKED BY: JLR
	PROJECT LEADER: MW	SHEET 33 OF 49
	DESIGNED BY: JLR	
	pc096122.i	