



**BR #165 @ STA 10+710.06
(MM 6.655)**

NOT TO SCALE

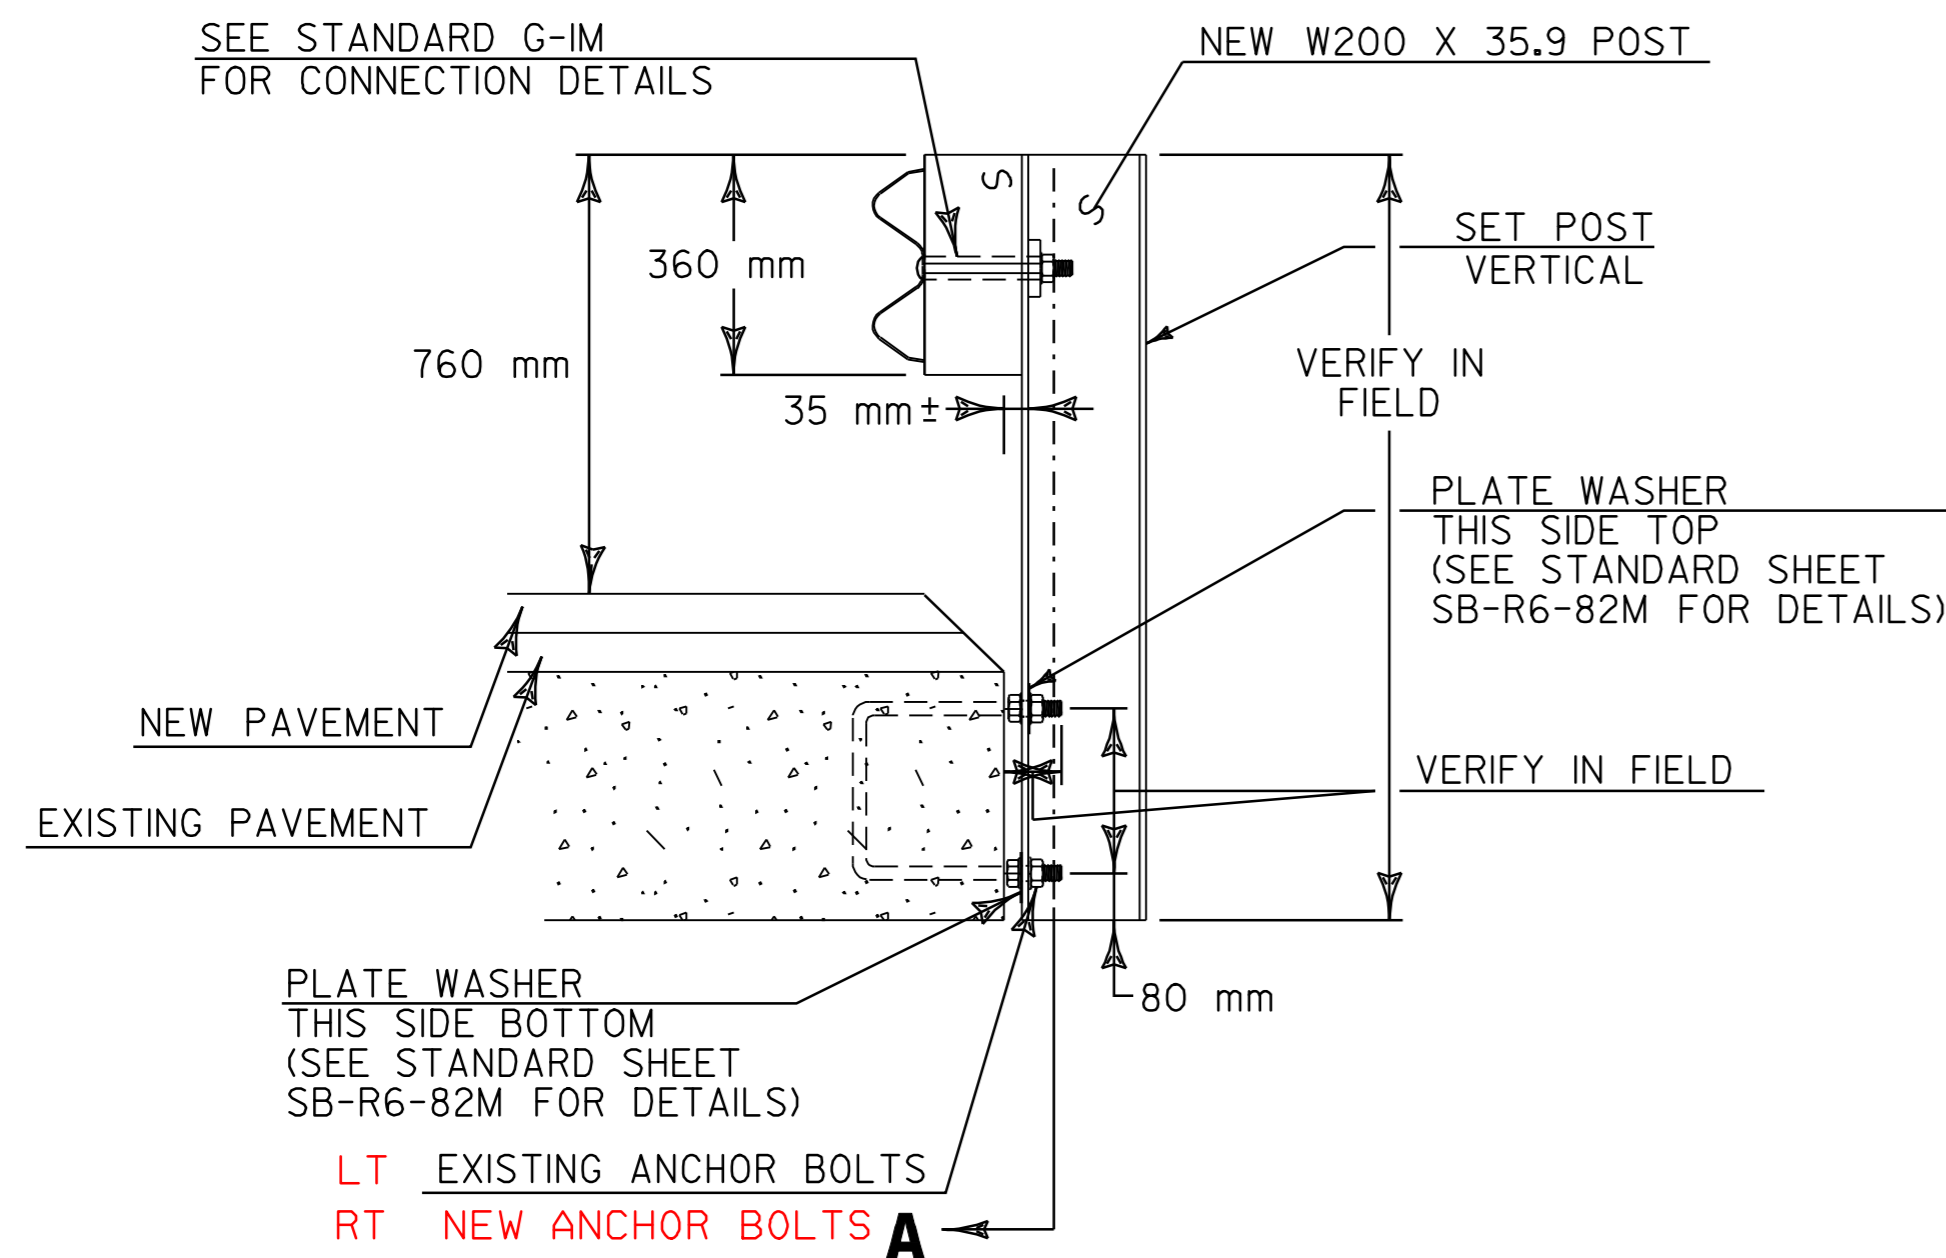

BR 165 BRIDGE POST DETAIL
NOT TO SCALE

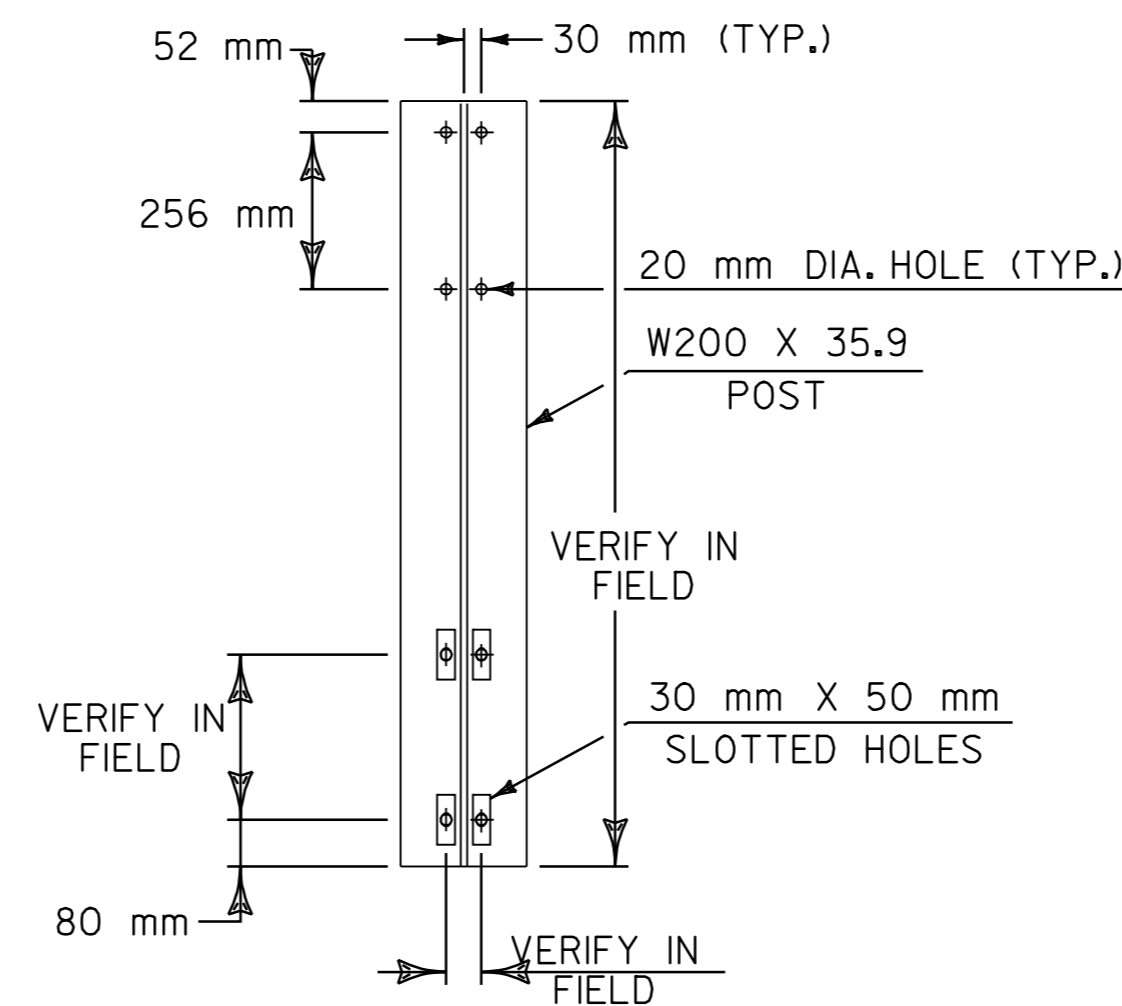

SECTION A-A

NOTE: ALL DIMENSIONS IN MILLIMETERS EXCEPT AS INDICATED

DATUM	_____
VERTICAL	_____
HORIZONTAL	_____

BRIDGE DETAIL SHEET #2	PROJECT: BARTON-IRASBURG	PROJECT NO.: STP 2107(I)S
	DESIGN FILE NAME: <u>pave/98c096/pc096.dgn</u>	
	IPARM FILE NAME: <u>pc096br2.i</u>	PLOT DATE: <u>21-MAY-2007 13</u>
	SURVEYED BY: <u>CLD ENGINEERS INC</u>	SURVEY DATE: <u>6/99</u>
	SQUAD LEADER: <u>WRH</u>	DRAWN BY: <u>ZE_NLL</u>
		SHEET: <u>45</u> OF <u>49</u>