

INDEX OF SHEETS


SEE SHEET 2

STATE OF VERMONT
AGENCY OF TRANSPORTATION



PROPOSED IMPROVEMENT
TOWNS OF
ST. ALBANS, SWANTON & HIGHGATE
COUNTY OF FRANKLIN
VT ROUTE 207 AND US ROUTE 7

PROJECT LOCATION
STP 2114(1)S AND STP 2335(1)S

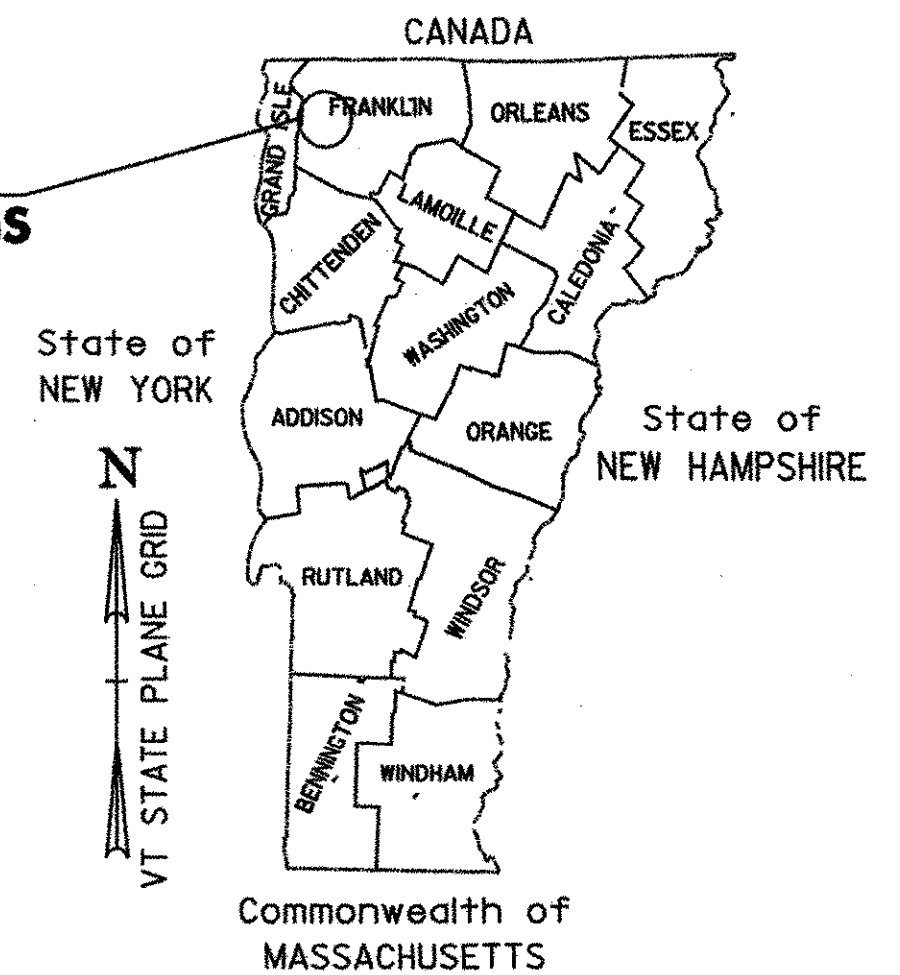

RECORD PLANS

CONTRACTOR: PIKE INDUSTRIES - BERLIN, VT

RESIDENT ENGINEER: D. WARNER

CONSTRUCTION BEGAN: JUNE 1, 2004

CONSTRUCTION COMPLETE: OCTOBER 20, 2004

RECORD PLANS BY: D. WARNER

I HEREBY CERTIFY THAT ALL THE CONSTRUCTION REQUIRED BY THIS SET OF DRAWINGS HAS BEEN ACCOMPLISHED AS INDICATED HEREIN.

BY *D. Warner* RESIDENT ENGINEER
DATE *12/12/05*

NOTE: Any further information concerning final quantities, amounts or other details relative to this project may be found at Central Files in the electronic archives.

ST. ALBANS - HIGHGATE STP 2114(1)S

BEGINNING IN THE TOWN OF ST. ALBANS ON VT ROUTE 207 AT THE INTERSECTION OF U.S. ROUTE 7, STA. 0+006.44 (MM 0.004) AND EXTENDING NORTHERLY ALONG VT ROUTE 207 FOR A DISTANCE OF 11,574.40 M (7.192 MILES) TO STA. 3+199.38 (MM 1.988) AT THE INTERSECTION OF VT ROUTE 78 IN THE TOWN OF HIGHGATE.

PROJECT DATA	LENGTH (M)	LENGTH (MILES)
TOWN OF ST. ALBANS VT ROUTE 207 STA. 0+006.44 TO STA. 0+677.53 MM 0.004 TO MM 0.421	671.09	0.417
TOWN OF SWANTON VT ROUTE 207 STA. 0+000.0 TO STA. 7+703.93 MM 0.000 TO MM 4.787	7,703.93	4.787
TOWN OF HIGHGATE VT ROUTE 207 STA. 0+000.0 TO STA. 3+199.38 MM 0.000 TO MM 1.988	3,199.38	1.988
TOTAL PROJECT LENGTH	11,574.40	7.192
TOTAL ROADWAY LENGTH	11,574.40	7.192

WORK TO BE PERFORMED UNDER THIS PROJECT INCLUDES COLD PLANING, LEVELING AND RESURFACING OF THE EXISTING HIGHWAY, COLD PLANING AND RESURFACING BRIDGES, NEW PAVEMENT MARKINGS, GUARD RAIL, DITCHING AND INCIDENTAL ITEMS.

ST. ALBANS - SWANTON STP 2335(1)S

BEGINNING IN THE TOWN OF ST. ALBANS ON US ROUTE 7 AT STA. 1+881.32 (MM 1.169) AND EXTENDING NORTHERLY ALONG US ROUTE 7 FOR A DISTANCE OF 1,332.54 M (0.828 MILES) TO STA. 3+213.86 (MM 1.997) IN THE TOWN OF ST. ALBANS. THE PROJECT RESUMES IN THE TOWN OF ST. ALBANS ON US ROUTE 7 AT STA. 3+514.81 (MM 2.184) AND EXTENDS NORTHERLY ALONG US ROUTE 7 FOR A DISTANCE OF 9,308.50 M TO STA. 8+154.55 (MM 5.067) IN THE TOWN OF SWANTON.

PROJECT DATA	LENGTH (M)	LENGTH (MILES)
TOWN OF ST. ALBANS US ROUTE 7 STA. 1+881.32 TO STA. 3+213.86 MM 1.169 TO MM 1.997	1,332.54	0.828
TOWN OF ST. ALBANS US ROUTE 7 STA. 3+514.81 TO STA. 4+667.26 MM 2.184 TO MM 2.901	1,152.45	0.717
TOWN OF SWANTON US ROUTE 7 STA. 0+000.0 TO STA. 8+154.55 MM 0.000 TO MM 5.067	8,154.55	5.067
TOTAL PROJECT LENGTH	10,639.54	6.612
TOTAL ROADWAY LENGTH	10,940.49	6.799

WORK TO BE PERFORMED UNDER THIS PROJECT INCLUDES COLD PLANING, LEVELING AND RESURFACING OF THE EXISTING HIGHWAY, NEW PAVEMENT MARKINGS, GUARD RAIL, DITCHING AND INCIDENTAL ITEMS.

CONVENTIONAL SYMBOLS

COUNTY LINE	
TOWN LINE	
LIMITS OF ACCESS	
POINT OF ACCESS	
FENCE LINE	
STONE WALL	
TRAVELED WAY	
GUARD RAIL	
RAILROAD	
SURVEY LINE	
CULVERT	
POWER POLE	
TELEPHONE POLE	
TREES	
CONTROL OF ACCESS	
PROPERTY LINE	
R.O.W. TAKING LINE	
SLOPE RIGHTS	
TOP OF CUT	
TOE OF SLOPE	
UNDERGROUND TELE LINES	
UNDERGROUND CABLE BOX	

END STP 2335(1)S
US ROUTE 7
SWANTON
STA. 8+154.55 (MM 5.067)



RESUME STP 2335(1)S
US ROUTE 7
ST. ALBANS TOWN
STA. 3+514.81 (MM 2.184)

STOP STP 2335(1)S
US ROUTE 7
ST. ALBANS TOWN
STA. 3+213.86 (MM 1.997)

BEGIN STP 2335(1)S
US ROUTE 7
ST. ALBANS TOWN
STA. 1+881.32 (MM 1.169)

END STP 2114(1)S
VT ROUTE 207
HIGHGATE
STA. 3+199.38 (MM 1.988)

BEGIN STP 2114(1)S
VT ROUTE 207
ST. ALBANS
STA. 0+006.44 (MM 0.004)

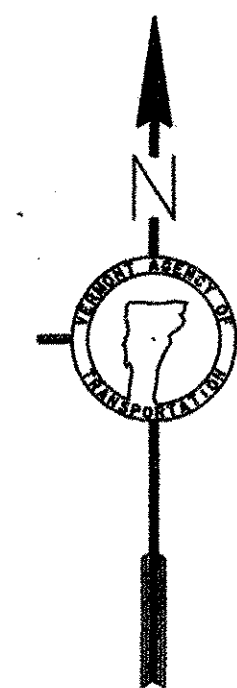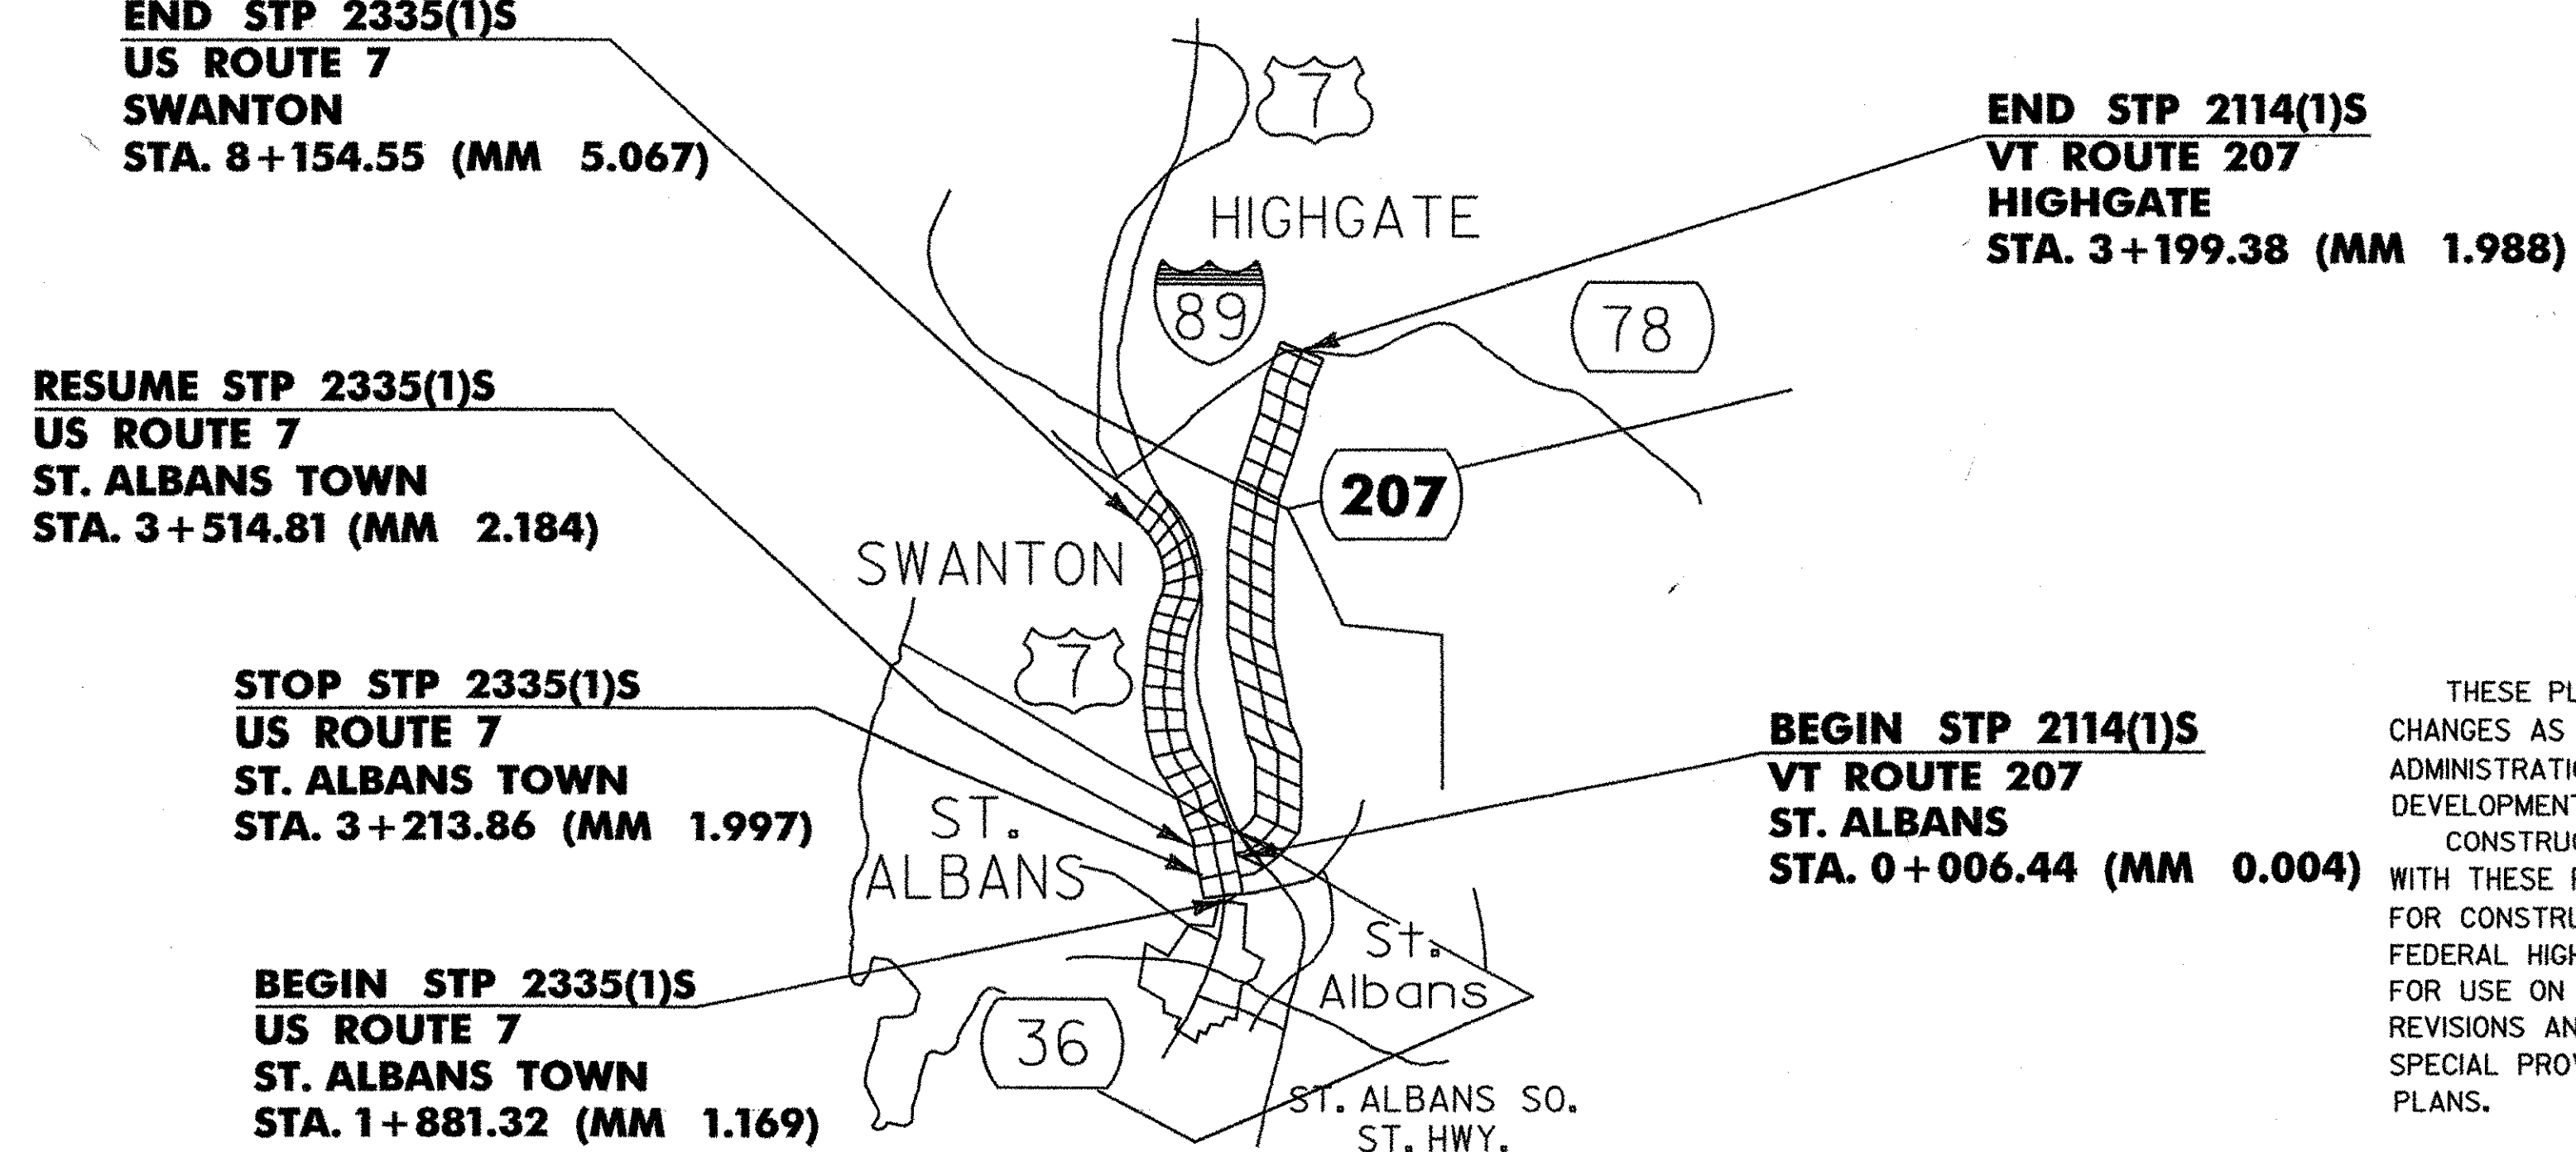

THESE PLANS ARE SUBJECT TO SUCH ENGINEERING CHANGES AS MAY BE REQUIRED BY THE FEDERAL HIGHWAY ADMINISTRATION OR THE DIRECTOR OF PROJECT DEVELOPMENT.

CONSTRUCTION IS TO BE CARRIED ON IN ACCORDANCE WITH THESE PLANS AND THE STANDARD SPECIFICATIONS FOR CONSTRUCTION DATED 2001, AS APPROVED BY THE FEDERAL HIGHWAY ADMINISTRATION ON JANUARY 4 2001 FOR USE ON THIS PROJECT, INCLUDING ALL SUBSEQUENT REVISIONS AND SUCH REVISED SPECIFICATIONS AND SPECIAL PROVISIONS AS ARE INCORPORATED IN THESE PLANS.

Metric

UNLESS NOTED OTHERWISE
STATIONS ARE IN KILOMETERS
ELEVATIONS ARE IN METERS
DIMENSIONS ARE IN MILLIMETERS

DEPARTMENT OF TRANSPORTATION
FEDERAL HIGHWAY ADMINISTRATOR

APPROVED _____ DATE _____

DIRECTOR OF PROJECT DEVELOPMENT

APPROVED *[Signature]* DATE *3/4/04*

PROJECT MANAGER :

PROJECT NAME AND NUMBER:
ST. ALBANS - HIGHGATE A C STP 2114(1)S AND
ST. ALBANS - SWANTON A C STP 2335(1)S

SHEET 1 OF 89 SHEETS