

TEMPORARY AND DURABLE 150 mm WHITE LINE
 STA. 0+120.0 TO 0+260.0, SOLID LT. & RT.
 STA. 0+120.0 TO 0+128.0, SOLID LT.
 STA. 0+128.0 TO 0+260.0, DASHED LT. & RT.


TEMPORARY AND DURABLE 150 mm YELLOW LINE
 STA. 0+120.0 TO 0+260.0, SOLID LT. & RT.

DURABLE LETTER OR SYMBOL
 STA. 0+127.0, LT. - (2) *ONLY*
 STA. 0+217.0, LT. - (2) *AHEAD*
 STA. 0+229.0, LT. - (2) *SIGNAL*

TEMPORARY LETTER OR SYMBOL
 STA. 0+123.4, LT. - (2) *ONLY*
 STA. 0+217.0, LT. - (2) *AHEAD*
 STA. 0+229.0, LT. - (2) *SIGNAL*

TEMPORARY AND DURABLE 300 mm WHITE LINE
 STA. 0+120.0 TO 0+128.0, SOLID RT.

REMOVING SIGNS
 AS SHOWN - I

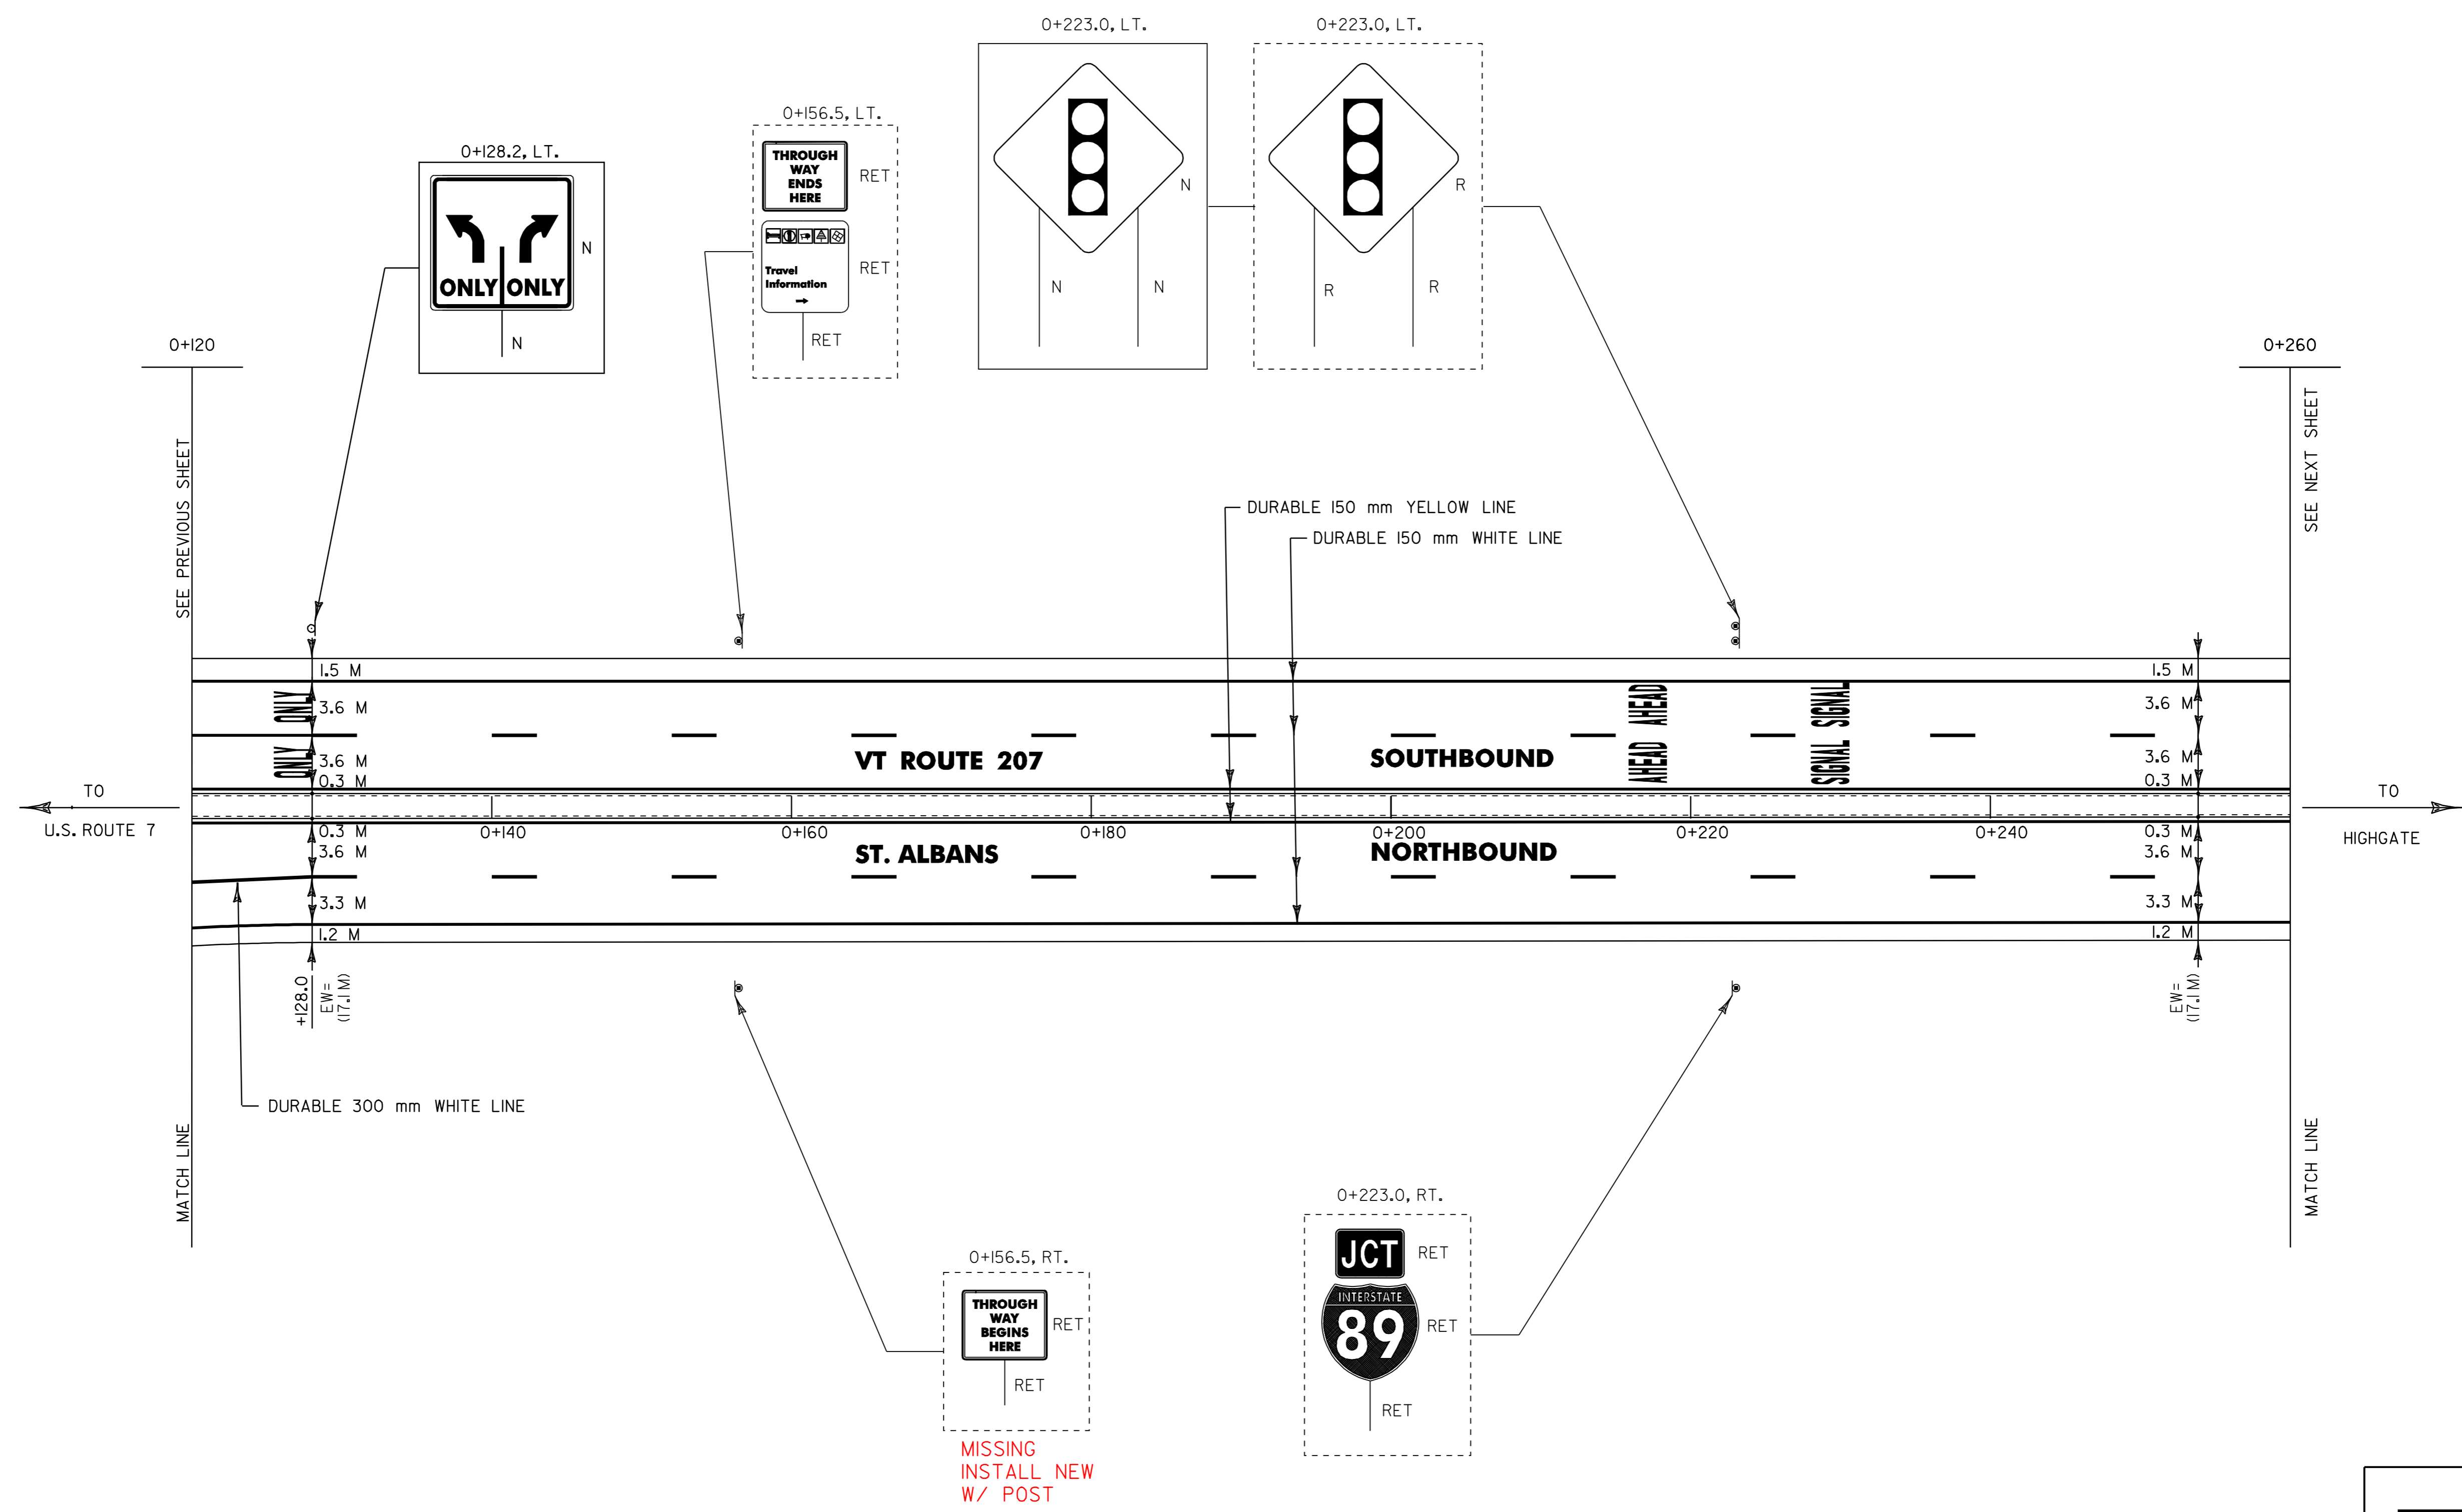

- NOTES: 1) ALL DIMENSIONS IN MILLIMETERS EXCEPT WHERE OTHERWISE INDICATED.
 2) ALL EXISTING SIGNS NOT SHOWN SHALL BE RETAINED AS DIRECTED BY THE RESIDENT ENGINEER.
 3) FOR ANY TOWN HIGHWAY OR STREET DETAILS, SEE VTrans STANDARD E-193M.
 4) FOR ALL PAVEMENT MARKING DETAILS, SEE VTrans STANDARDS E-191M & E-192M
 5) EW= EXISTING ROADWAY WIDTH

PROJECT LAYOUT #2

PROJECT NAME: ST. ALBANS-HIGHGATE	PLOT DATE: 16-SEP-2005 13:4
PROJECT NUMBER: STP 2114(1)S	DRAWN BY: D-H
FILE NAME: /pave/98cll0/pcll0.dgn	CHECKED BY: D-H
PROJECT LEADER: JLL	SHEET 17 OF 89
DESIGNED BY: D-H	
IPARM FILE NAME: pcll0p02.i	

