

TEMPORARY AND DURABLE 150 mm WHITE LINE
 STA. 0+420.0 TO 0+560.0, SOLID LT. & RT.
 (WITH EDGELINE BREAKS FOR RAMP B & "D")
 STA. 0+420.0 TO 0+480.0, DASHED LT.
 STA. 0+420.0 TO 0+560.0, DASHED RT.
 STA. 0+503.5, SOLID RT. (RAMP D)
 STA. 0+503.5, SOLID LT. (RAMP B)

TEMPORARY AND DURABLE 150 mm YELLOW LINE
 STA. 0+420.0 TO 0+560.0, SOLID LT. & RT.
 STA. 0+503.5, SOLID RT. (RAMP D)
 STA. 0+503.5, SOLID LT. (RAMP B)

TEMPORARY AND DURABLE LETTER OR SYMBOL
 STA. 0+503.5, RT. - "STOP"

TEMPORARY AND DURABLE 600 mm STOP BAR
 STA. 0+503.5, RT.

PAINTED CURB
 STA. 0+479.0 TO 0+488.0, LT. & RT.
 STA. 0+506.0 TO 0+539.0, LT.
 STA. 0+506.0 TO 0+515.0, RT.

REMOVING SIGNS
 AS SHOWN - 2



MANUFACTURED TERMINAL SECTION, FLARED


STA. 0+425.5 TO 0+436.9, LT.
 STA. 0+465.7 TO 0+477.1, RT.
 STA. 0+474.4 TO 0+486.3, LT.

REMOVAL AND DISPOSAL OF GUARD RAIL

STA. 0+420.1 TO 0+477.1, RT.
 STA. 0+425.5 TO 0+486.3, LT.

STEEL BEAM GUARD RAIL

STA. 0+420.1 TO 0+465.7, RT.
 STA. 0+436.9 TO 0+474.9, LT.

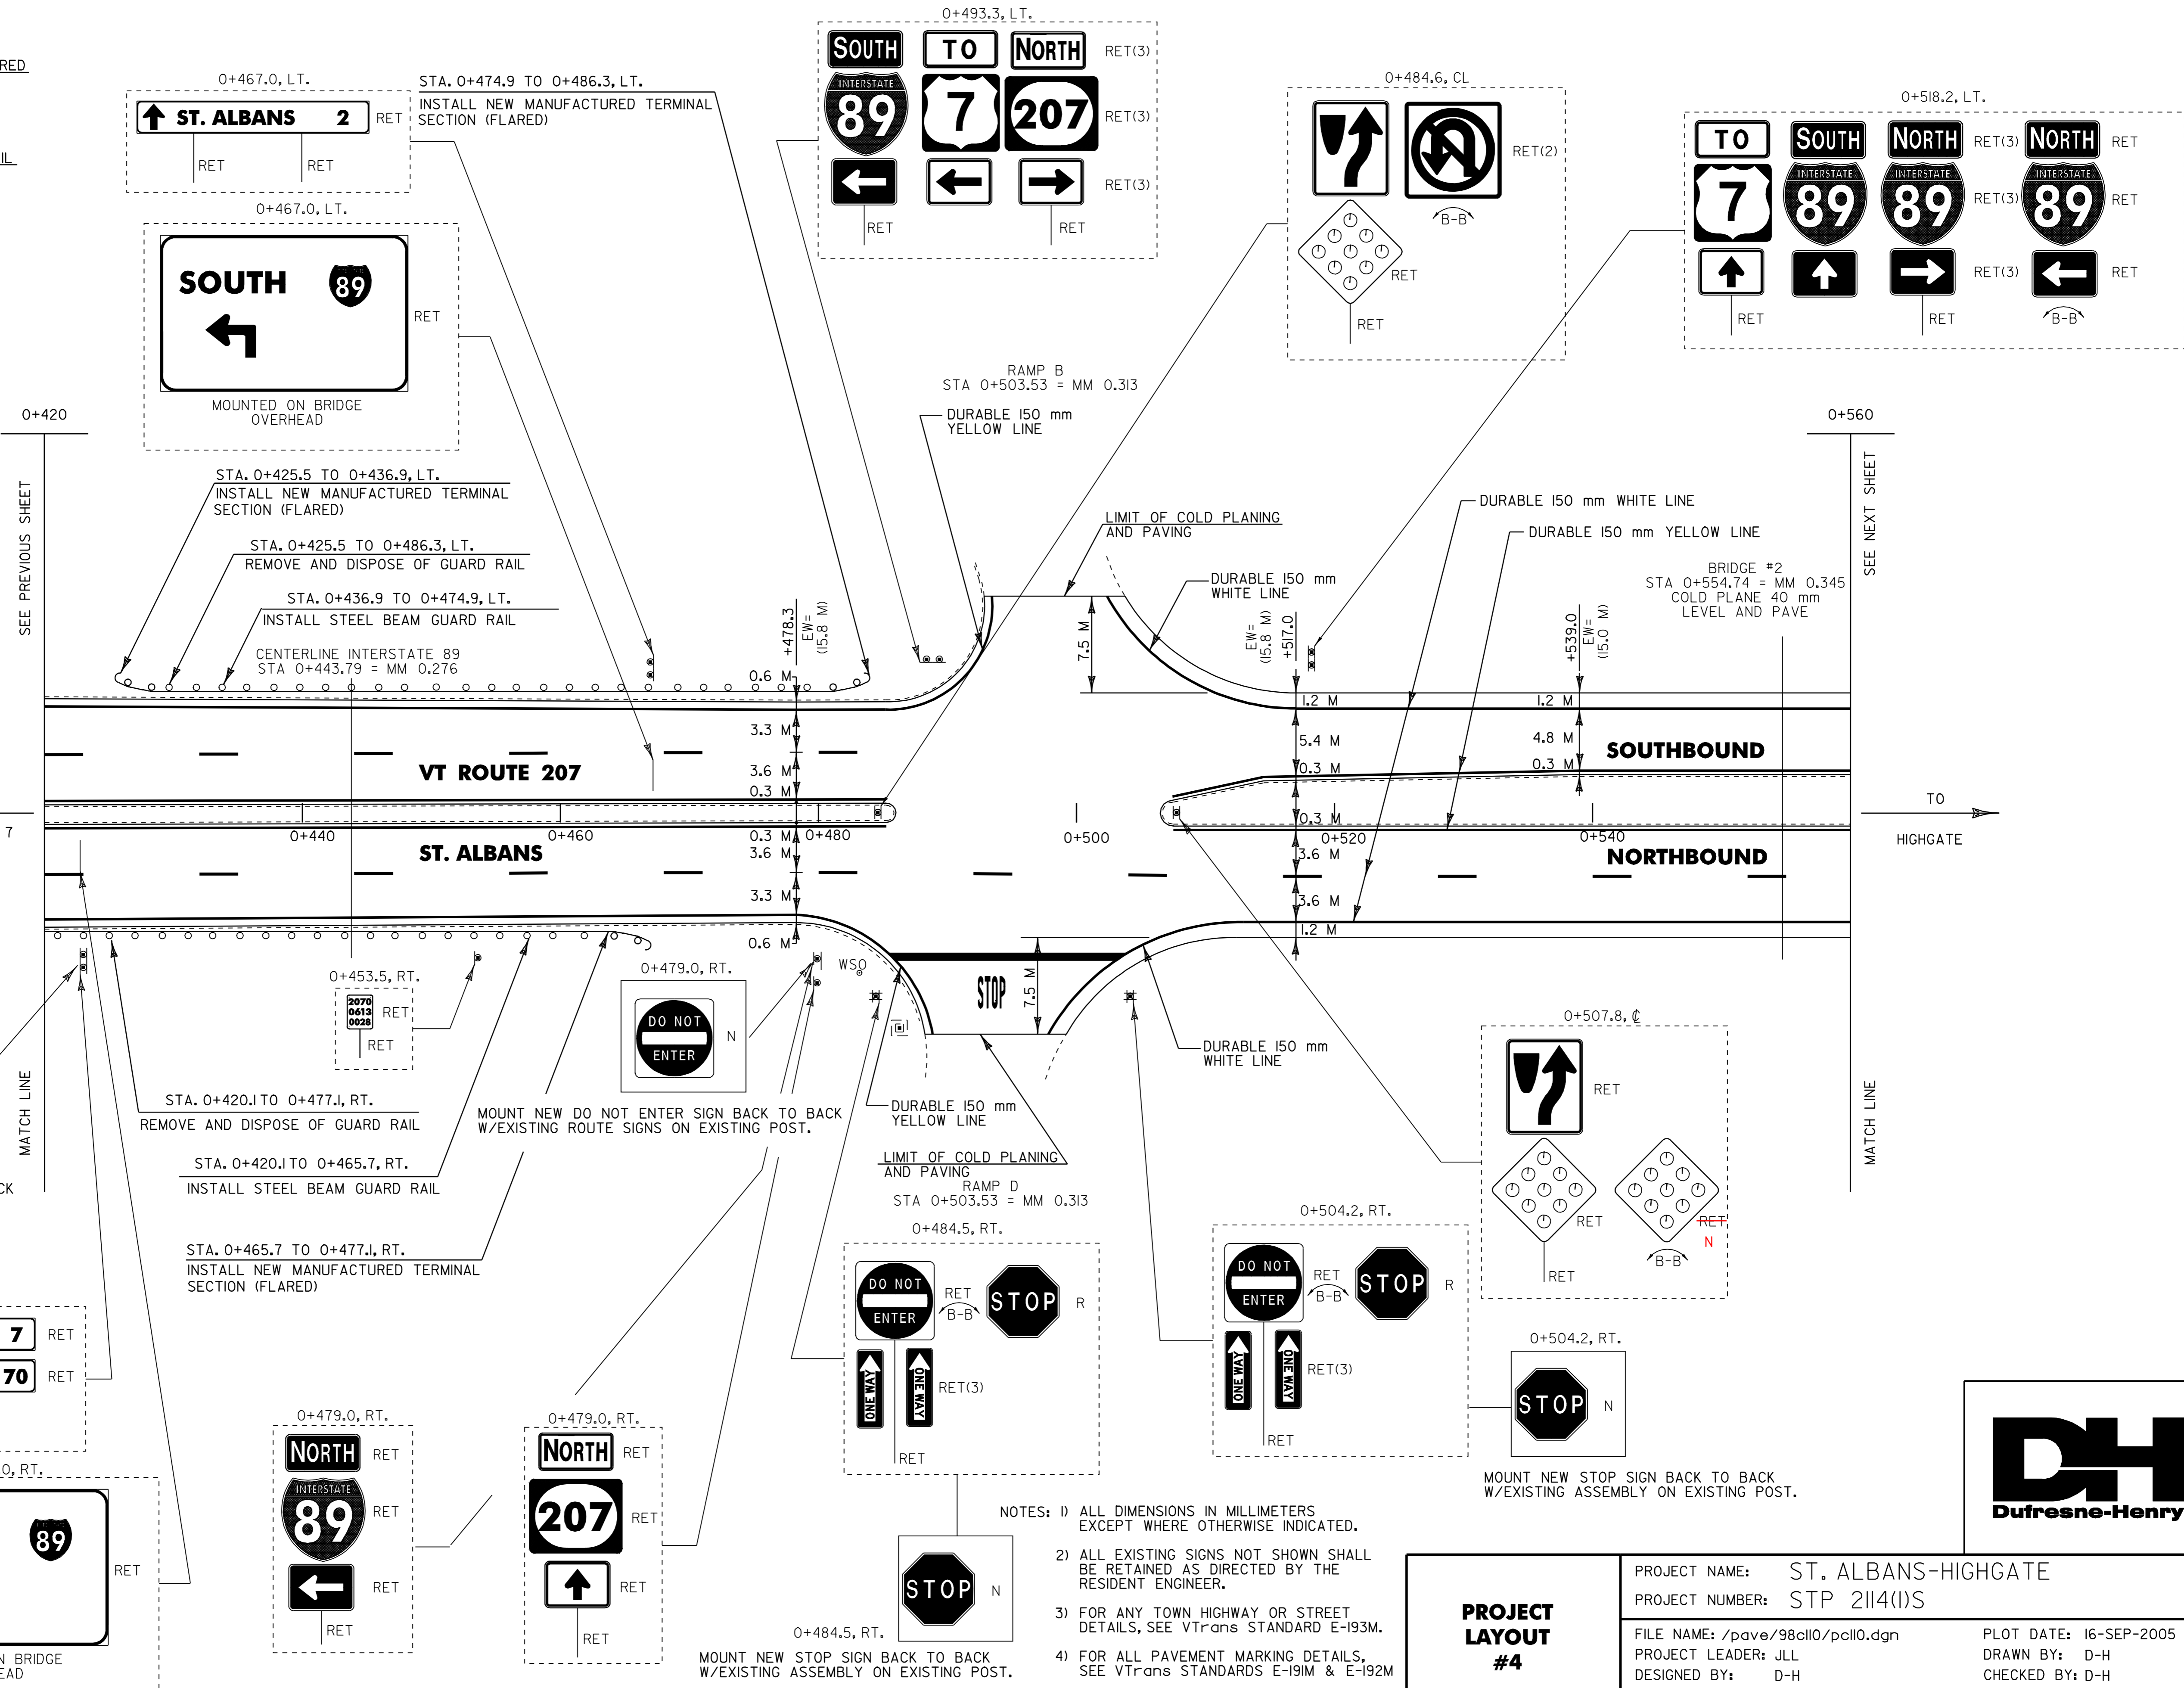

SEE PREVIOUS SHEET

SEE NEXT SHEET

MATCH LINE

MATCH LINE

MOUNT NEW WRONG WAY SIGN BACK TO BACK W/EXISTING D-BOARDS ON EXISTING POST.

STA. 0+420.1 TO 0+477.1, RT.
 REMOVE AND DISPOSE OF GUARD RAIL

STA. 0+420.1 TO 0+465.7, RT.
 INSTALL STEEL BEAM GUARD RAIL

STA. 0+465.7 TO 0+477.1, RT.
 INSTALL NEW MANUFACTURED TERMINAL SECTION (FLARED)

MOUNT NEW DO NOT ENTER SIGN BACK TO BACK W/EXISTING ROUTE SIGNS ON EXISTING POST.

LIMIT OF COLD PLANING AND PAVING
 RAMP D
 STA 0+503.53 = MM 0.313
 0+484.5, RT.

MOUNT NEW STOP SIGN BACK TO BACK W/EXISTING ASSEMBLY ON EXISTING POST.

NOTES: 1) ALL DIMENSIONS IN MILLIMETERS EXCEPT WHERE OTHERWISE INDICATED.

2) ALL EXISTING SIGNS NOT SHOWN SHALL BE RETAINED AS DIRECTED BY THE RESIDENT ENGINEER.

3) FOR ANY TOWN HIGHWAY OR STREET DETAILS, SEE VTrans STANDARD E-193M.

4) FOR ALL PAVEMENT MARKING DETAILS, SEE VTrans STANDARDS E-191M & E-192M

5) EW= EXISTING ROADWAY WIDTH

PROJECT LAYOUT #4

PROJECT NAME: ST. ALBANS-HIGHGATE	PLOT DATE: 16-SEP-2005 13:44
PROJECT NUMBER: STP 2114(1)S	DRAWN BY: D-H
FILE NAME: /pave/98cl10/pcl10.dgn	CHECKED BY: D-H
PROJECT LEADER: JLL	SHEET 19 OF 89
DESIGNED BY: D-H	
IPARM FILE NAME: pcl10p04.1	

