


TEMPORARY AND DURABLE 100 mm WHITE LINE
 STA. I+000.0 TO I+700.0, SOLID LT. & RT.

TEMPORARY AND DURABLE 100 mm YELLOW LINE
 STA. I+000.0 TO I+207.0, SOLID LT. / DASHED RT.
 STA. I+207.0 TO I+512.8, DASHED CL
 STA. I+512.8 TO I+700.0, DASHED LT. / SOLID RT.

DITCH CLEANING
 STA. I+000.0 TO I+126.5, RT.
 STA. I+448.4 TO I+700.0, LT.
 (FOR DETAILS SEE SHEET 11)

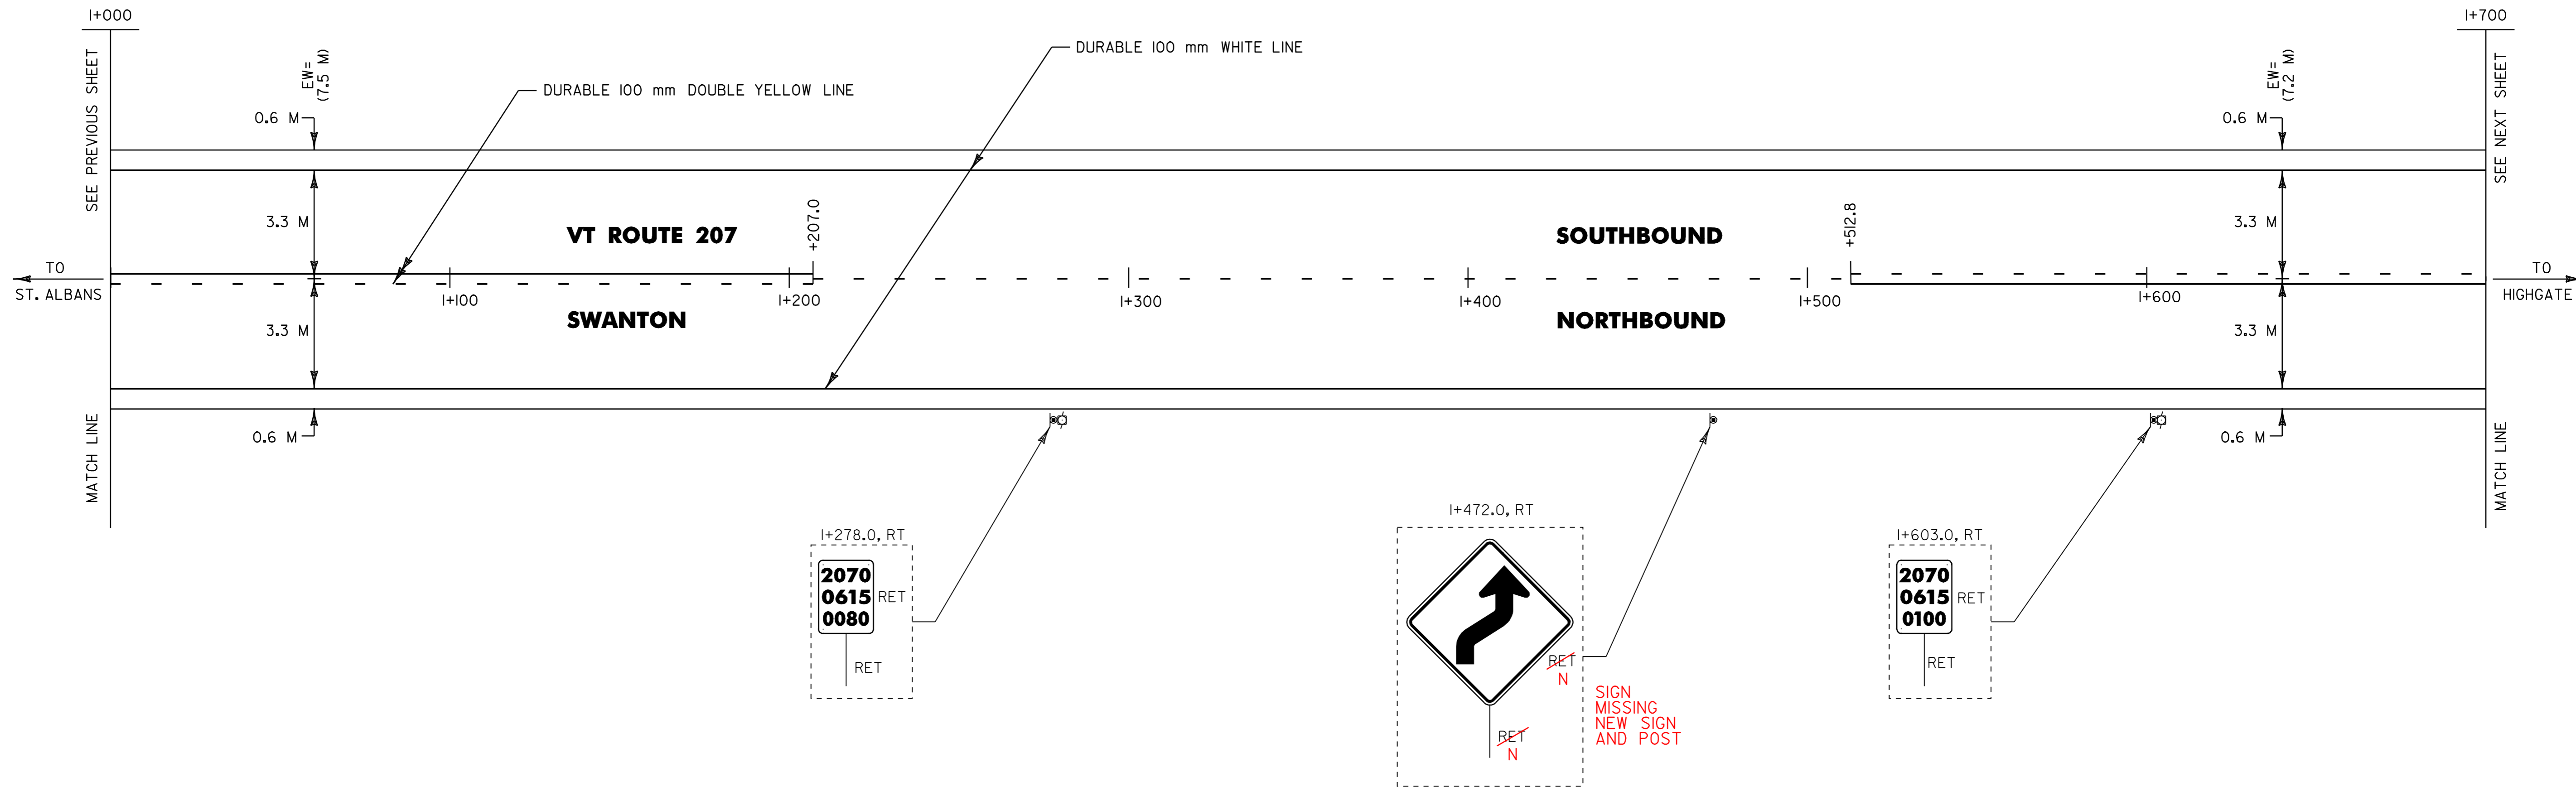

- NOTES: 1) ALL DIMENSIONS IN MILLIMETERS EXCEPT WHERE OTHERWISE INDICATED.
 2) ALL EXISTING SIGNS NOT SHOWN SHALL BE RETAINED AS DIRECTED BY THE RESIDENT ENGINEER.
 3) FOR ANY TOWN HIGHWAY OR STREET DETAILS, SEE VTrans STANDARD E-193M.
 4) FOR ALL PAVEMENT MARKING DETAILS, SEE VTrans STANDARDS E-191M & E-192M
 5) EW= EXISTING ROADWAY WIDTH

PROJECT LAYOUT #9

PROJECT NAME: ST. ALBANS-HIGHGATE
 PROJECT NUMBER: STP 2114(1)S
 FILE NAME: /pave/98cll0/pcll0.dgn
 PROJECT LEADER: JLL
 DESIGNED BY: D-H
 IPARM FILE NAME: pcll0p09.i
 PLOT DATE: 16-SEP-2005 13:51
 DRAWN BY: D-H
 CHECKED BY: D-H
 SHEET 24 OF 89

