


TEMPORARY AND DURABLE 100 mm WHITE LINE
STA. 3+100.0 TO 3+700.0, SOLID LT. & RT.

TEMPORARY AND DURABLE 100 mm YELLOW LINE
STA. 3+100.0 TO 3+106.0, DASHED LT. / SOLID RT.
STA. 3+106.0 TO 3+800.0, SOLID LT. & RT.

REMOVING SIGNS
AS SHOWN - I

DITCH CLEANING
STA. 3+540.6 TO 3+800.0, LT.
(FOR DETAILS SEE SHEET 11)

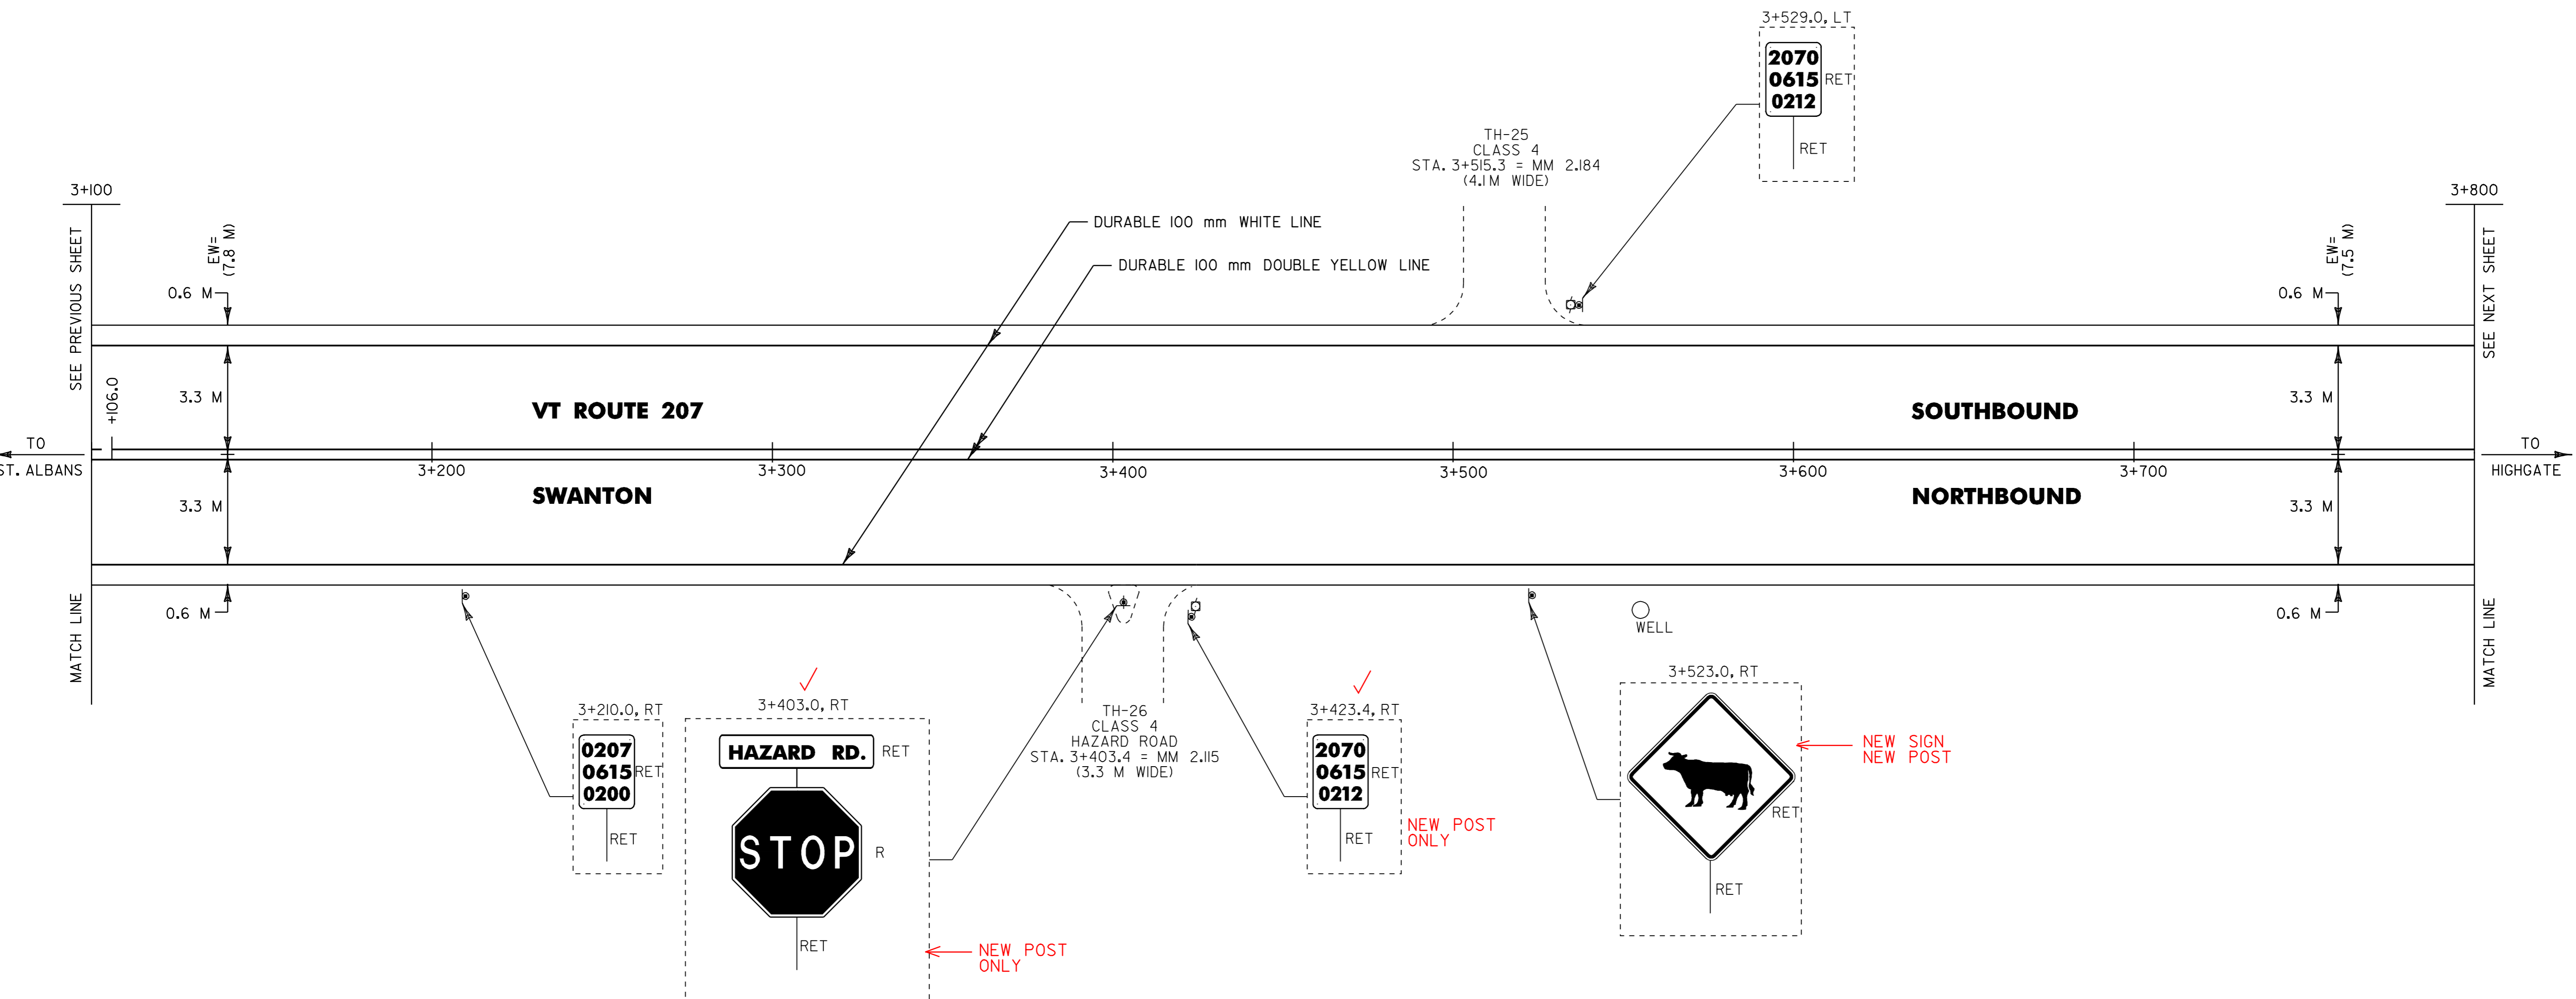

- NOTES: 1) ALL DIMENSIONS IN MILLIMETERS EXCEPT WHERE OTHERWISE INDICATED.
 2) ALL EXISTING SIGNS NOT SHOWN SHALL BE RETAINED AS DIRECTED BY THE RESIDENT ENGINEER.
 3) FOR ANY TOWN HIGHWAY OR STREET DETAILS, SEE VTrans STANDARD E-193M.
 4) FOR ALL PAVEMENT MARKING DETAILS, SEE VTrans STANDARDS E-191M & E-192M
 5) EW= EXISTING ROADWAY WIDTH

PROJECT LAYOUT #12

PROJECT NAME: ST. ALBANS-HIGHGATE	PROJECT NUMBER: STP 2114(1)S
FILE NAME: /pave/98c110/pcl10.dgn	PLOT DATE: 16-SEP-2005 13:15
PROJECT LEADER: JLL	DRAWN BY: D-H
DESIGNED BY: D-H	CHECKED BY: D-H
IPARM FILE NAME: pcl10pl2.1	SHEET 27 OF 89

