

TEMPORARY AND DURABLE 100 mm WHITE LINE (MOD.2)
STA. 0+300.0 TO 1+000.0, SOLID LT. & RT.


TEMPORARY AND DURABLE 100 mm YELLOW LINE (MOD.2)
STA. 0+300.0 TO STA. 1+000.0, SOLID LT. & RT.

MANUFACTURED TERMINAL SECTION, FLARED
STA. 0+770.2 TO 0+781.6, RT.
STA. 0+772.1 TO 0+783.5, LT.
STA. 0+802.5 TO 0+813.9, LT.
STA. 0+804.4 TO 0+815.8, RT.

REMOVAL AND DISPOSAL OF GUARD RAIL
STA. 0+771.1 TO 0+814.0, RT.
STA. 0+775.9 TO 0+817.0, LT.

STEEL BEAM GUARD RAIL
STA. 0+781.6 TO 0+804.4, RT.
STA. 0+783.5 TO 0+802.5, LT.

DITCH CLEANING
STA. 0+300.0 TO 0+313.8, LT.
(FOR DETAILS SEE SHEET 11)

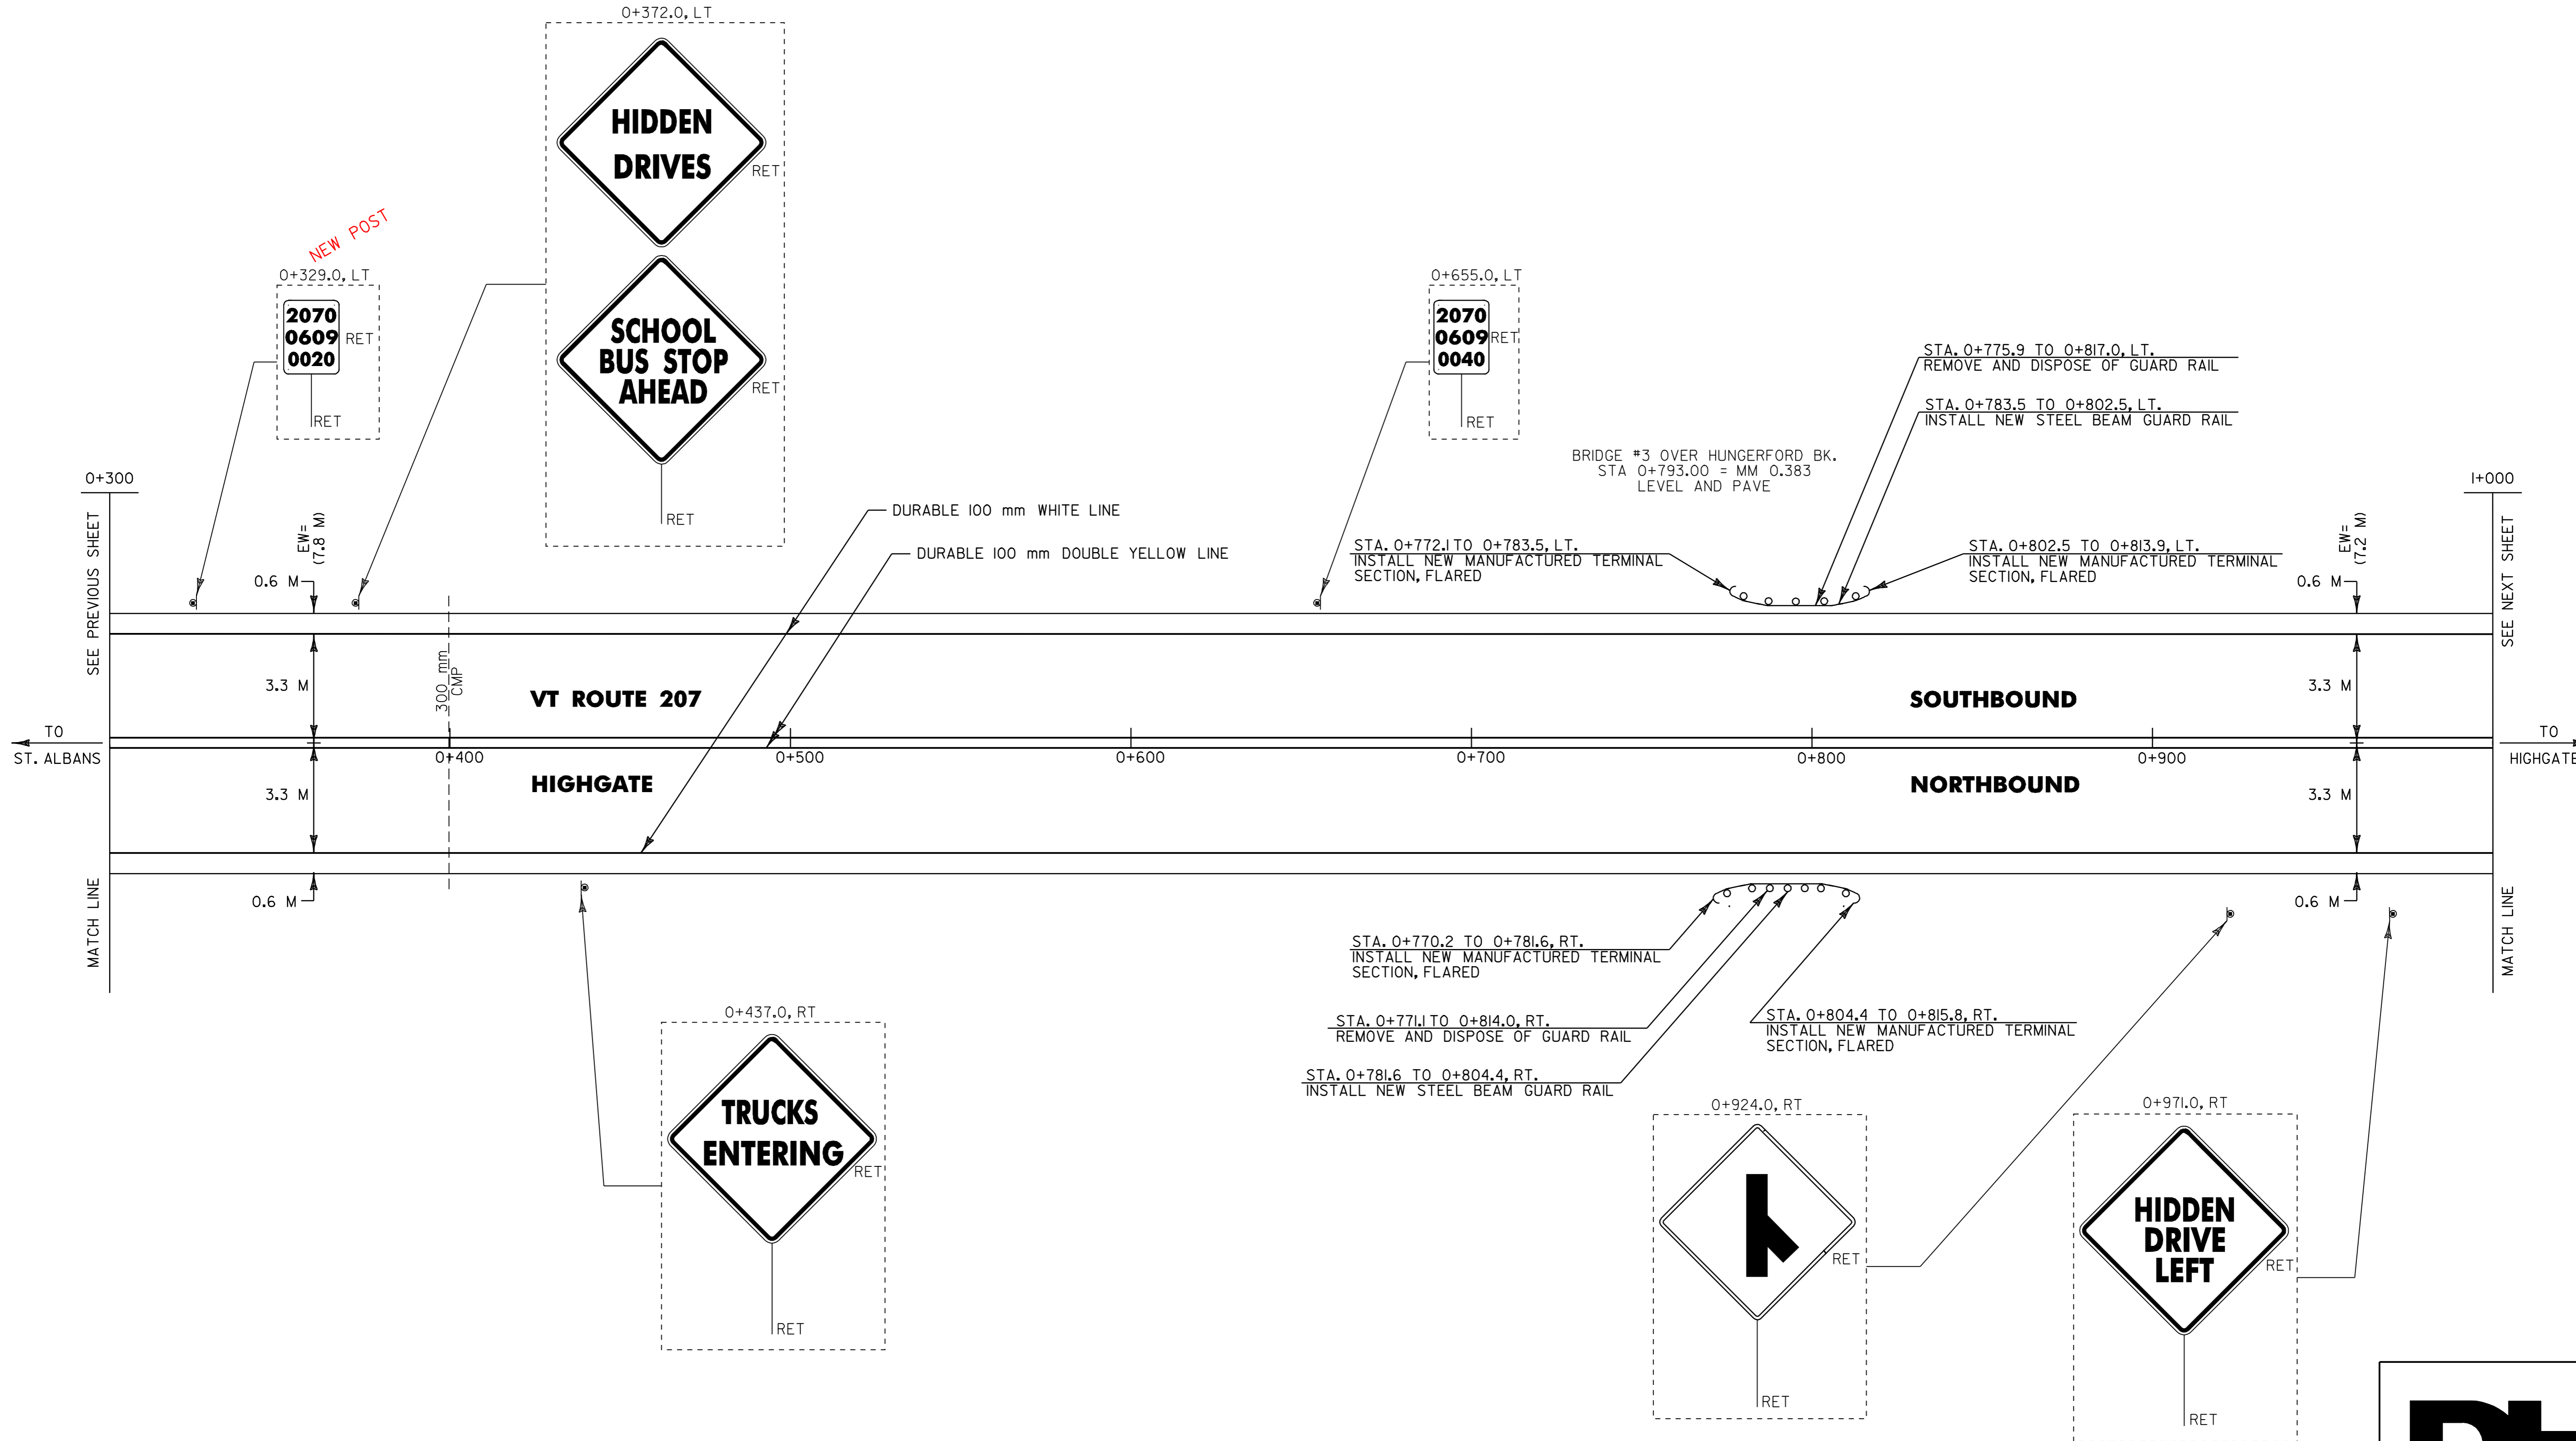

NOTES: 1) ALL DIMENSIONS IN MILLIMETERS EXCEPT WHERE OTHERWISE INDICATED.

- 2) ALL EXISTING SIGNS NOT SHOWN SHALL BE RETAINED AS DIRECTED BY THE RESIDENT ENGINEER.
- 3) FOR ANY TOWN HIGHWAY OR STREET DETAILS, SEE VTrans STANDARD E-193M.
- 4) FOR ALL PAVEMENT MARKING DETAILS, SEE VTrans STANDARDS E-191M & E-192M
- 5) EW= EXISTING ROADWAY WIDTH

PROJECT LAYOUT #19	PROJECT NAME: ST. ALBANS-HIGHGATE	FILE NAME: /pave/98c110/pcl10.dgn	PLOT DATE: 16-SEP-2005 13:16
	PROJECT NUMBER: STP 2114(1)S	PROJECT LEADER: JLL	DRAWN BY: D-H
		DESIGNED BY: D-H	CHECKED BY: D-H
		IPARM FILE NAME: pcl10p19.1	SHEET 34 OF 89

