

TEMPORARY AND DURABLE 100 mm WHITE LINE (MOD. 2)
STA. 3+100.0 TO 3+199.4, SOLID LT. & RT.






TEMPORARY AND DURABLE 100 mm YELLOW LINE (MOD. 2)
STA. 3+100.0 TO STA. 3+191.0, SOLID LT. & RT.

REMOVING SIGNS
AS SHOWN - 9





ERECTING SALVAGED SIGNS
AS SHOWN - 4

TEMPORARY AND DURABLE LETTER OR SYMBOL (MOD. 2)
STA. 3+188.0, RT. - 'STOP'

TEMPORARY AND DURABLE 600 mm STOP BAR (MOD. 2)
STA. 3+190.7, RT.

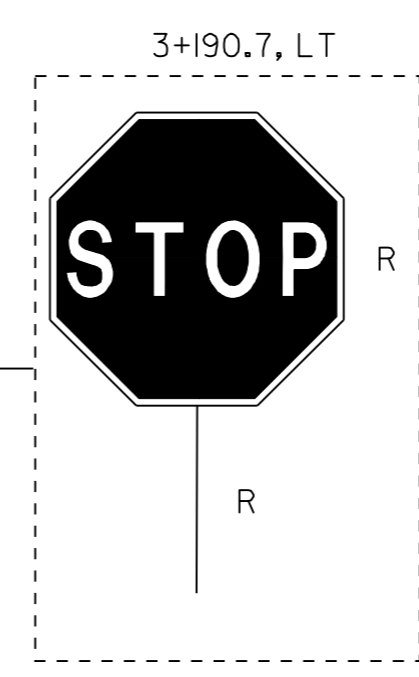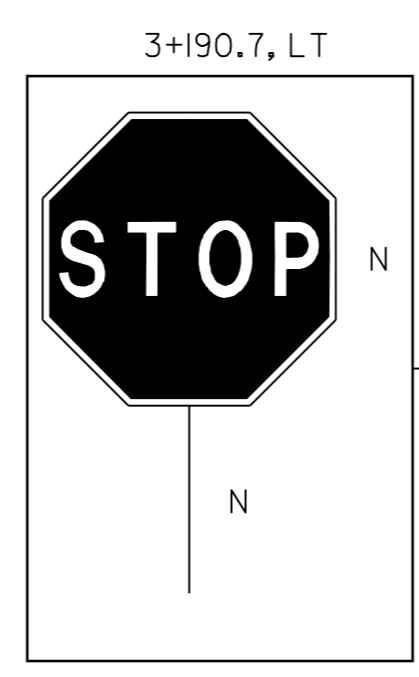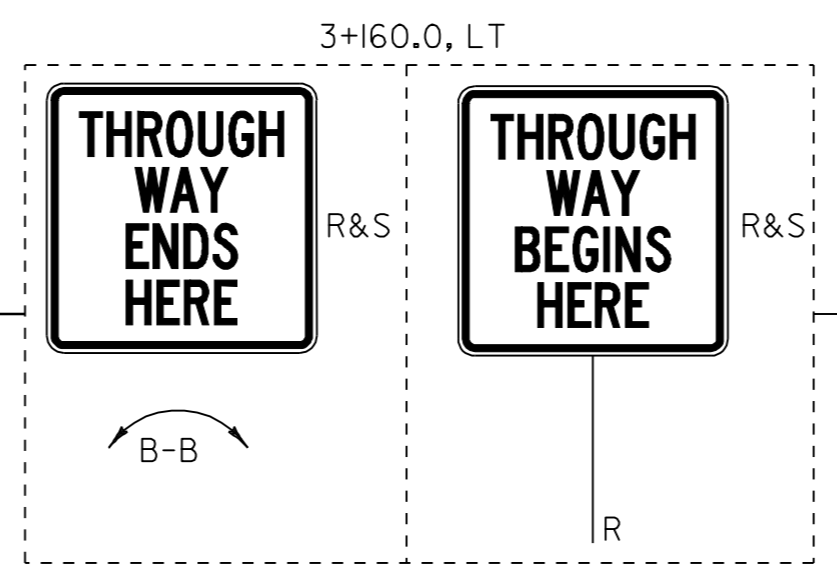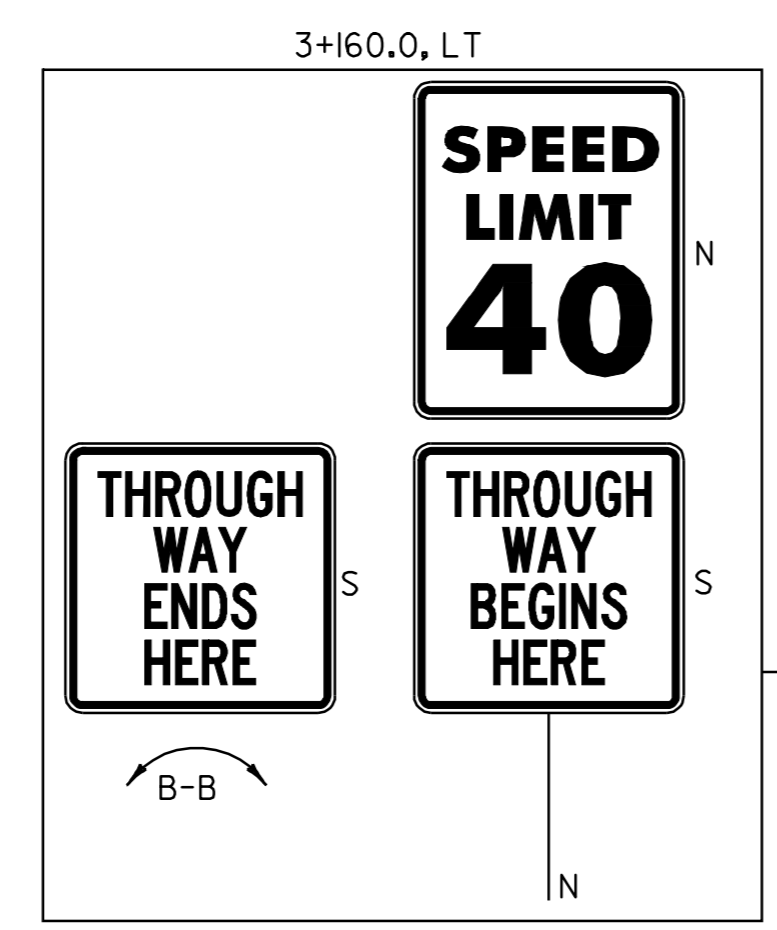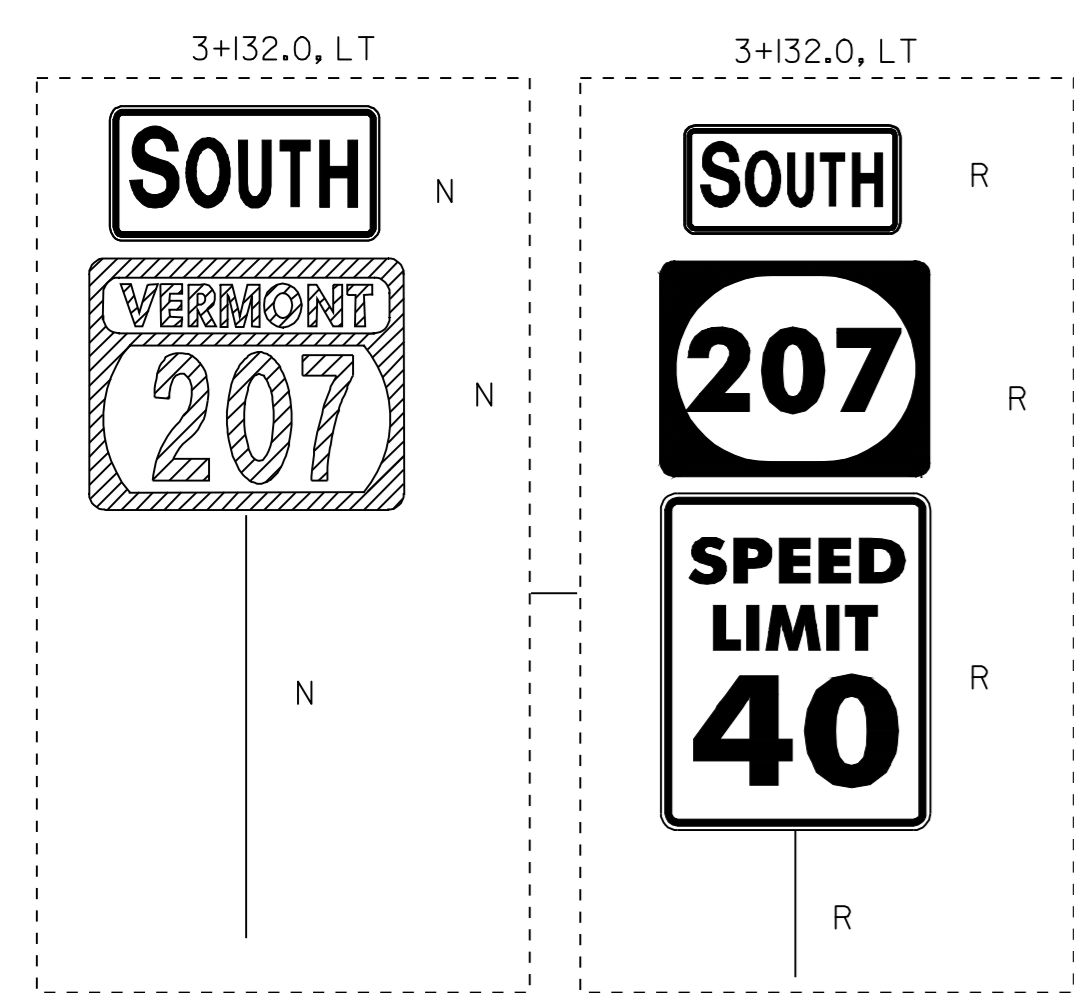

**END STP 2114(1)S
VT ROUTE 207
HIGHGATE
STA. 3+199.38 = MM 1.988**

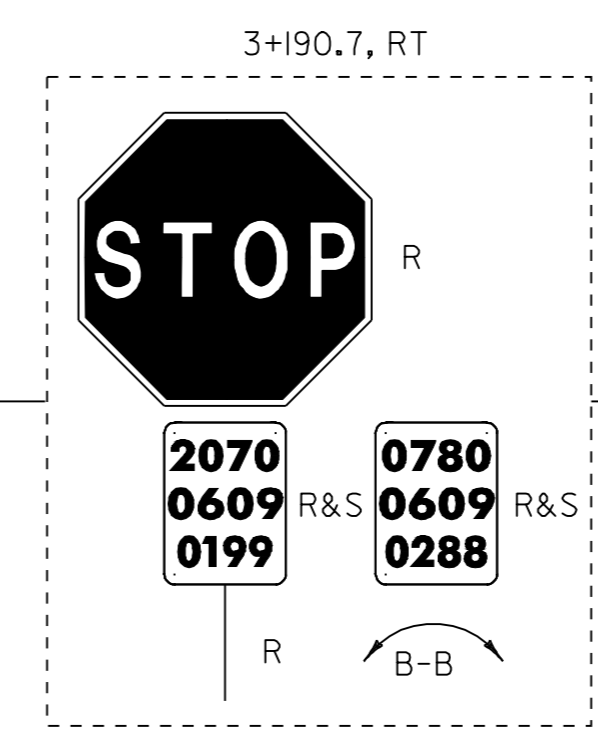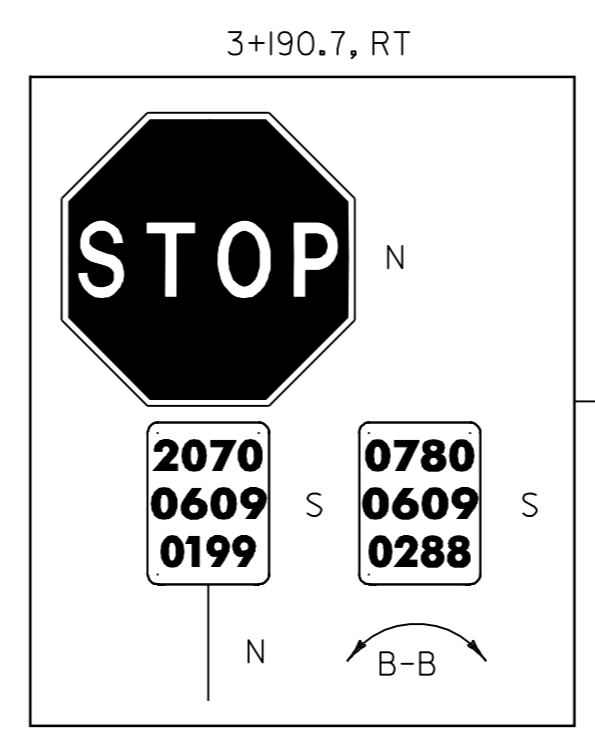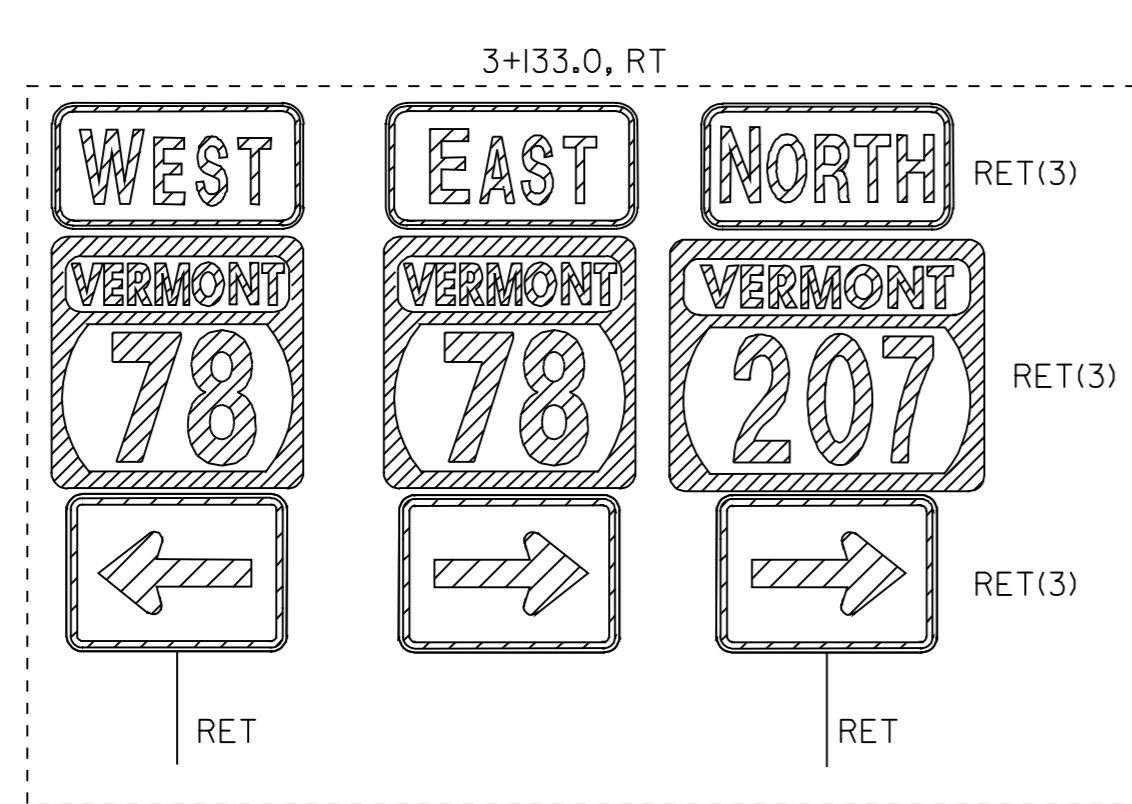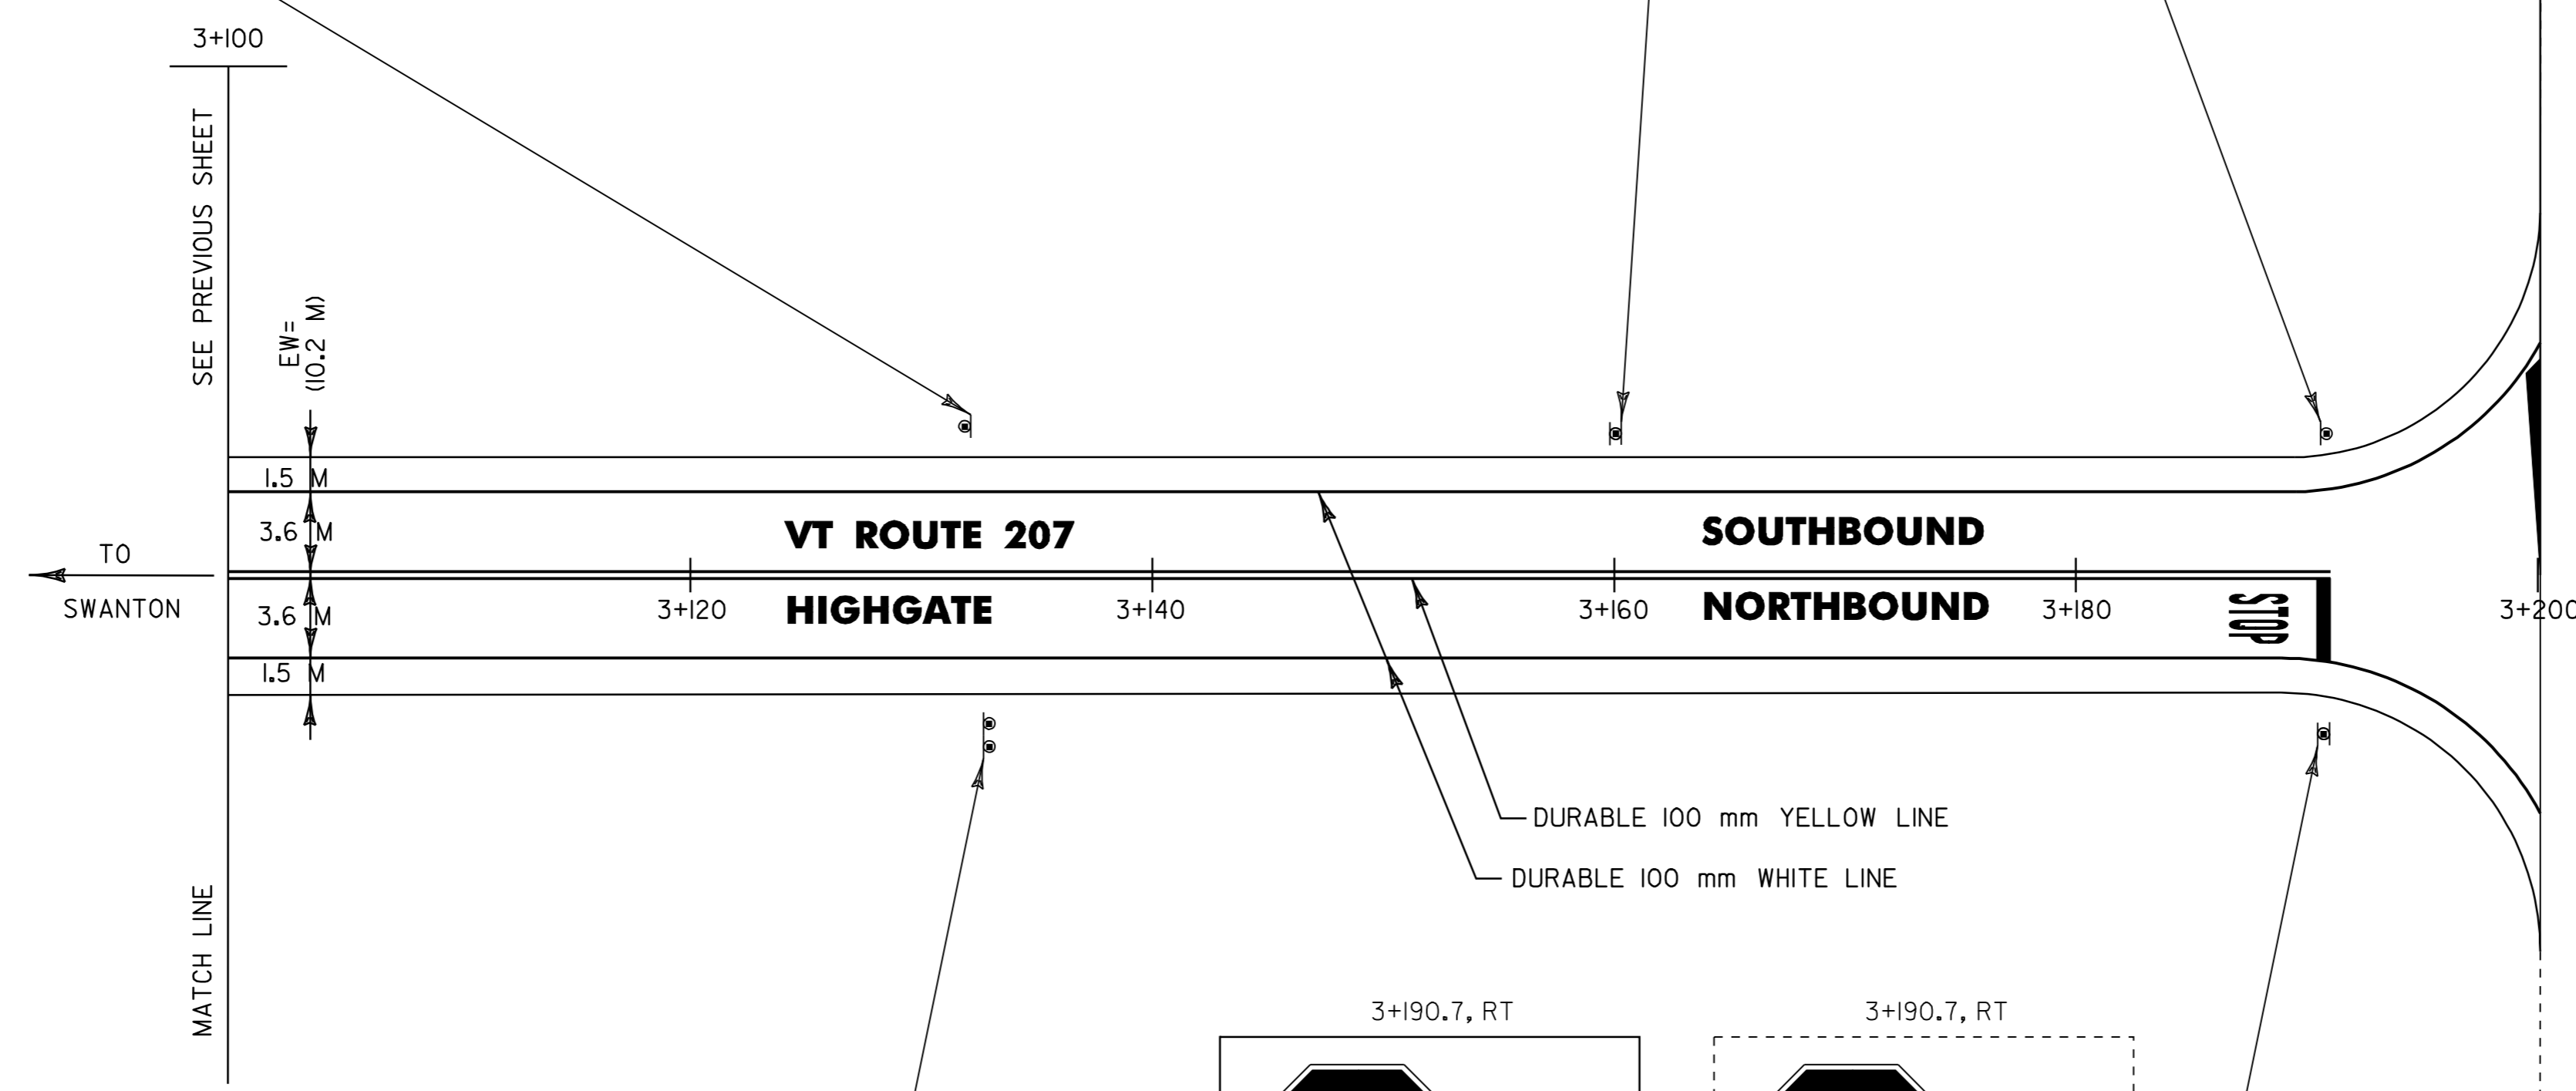

- NOTES: 1) ALL DIMENSIONS IN MILLIMETERS EXCEPT WHERE OTHERWISE INDICATED.
2) ALL EXISTING SIGNS NOT SHOWN SHALL BE RETAINED AS DIRECTED BY THE RESIDENT ENGINEER.
3) FOR ANY TOWN HIGHWAY OR STREET DETAILS, SEE VTrans STANDARD E-193M.
4) FOR ALL PAVEMENT MARKING DETAILS, SEE VTrans STANDARDS E-191M & E-192M
5) EW= EXISTING ROADWAY WIDTH

PROJECT LAYOUT #25

PROJECT NAME: ST. ALBANS-HIGHGATE	PLOT DATE: 16-SEP-2005 13:17
PROJECT NUMBER: STP 2114(1)S	DRAWN BY: D-H
FILE NAME: /pave/98c110/pcl10.dgn	CHECKED BY:
DESIGNED BY: D-H	SHEET 40 OF 89
IPARM FILE NAME: pcl10p25.i	

