
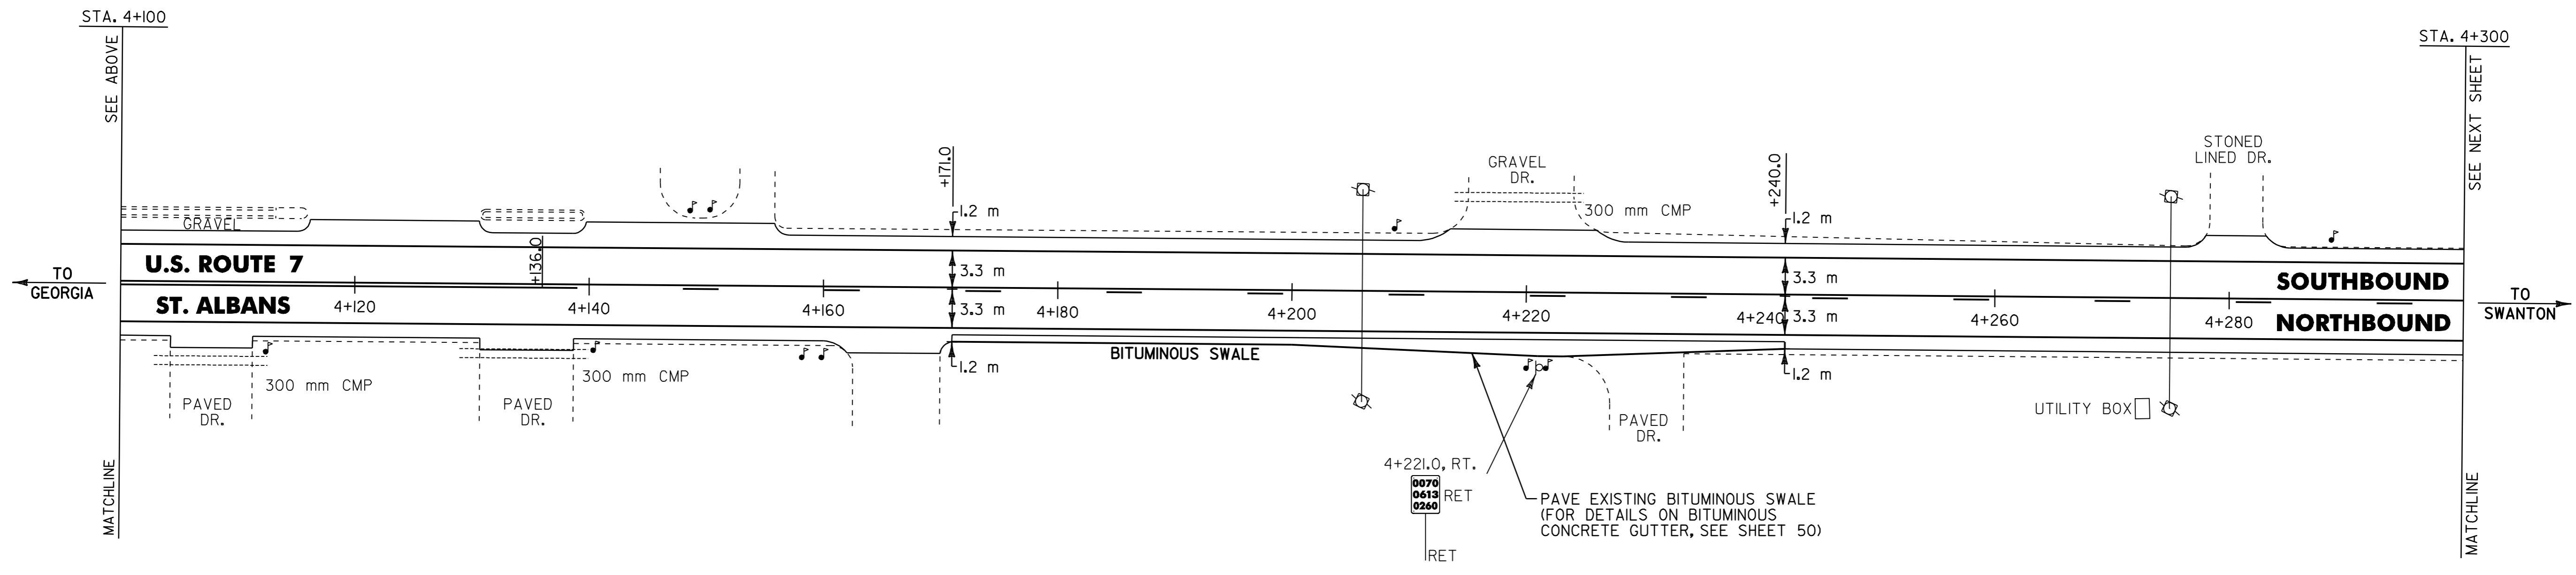


TEMPORARY & DURABLE 100 mm WHITE LINE  
 STA. 3+900.0 TO 4+300.0, SOLID LT. & RT.

TEMPORARY & DURABLE 100 mm YELLOW LINE  
 STA. 3+900.0 TO 4+136.0, SOLID LT. & RT.  
 STA. 4+136.0 TO 4+300.0, SOLID LT/ DASHED RT.

TEMPORARY & DURABLE LETTER OR SYMBOL  
 STA. 3+918.3, LT - AHEAD  
 STA. 3+930.3, LT - SIGNAL

BITUMINOUS CONCRETE GUTTERS AND TRAFFIC ISLANDS  
 STA. 4+171.0 TO 4+240.0, RT.  
 (FOR DETAIL, SEE SHEET 50)

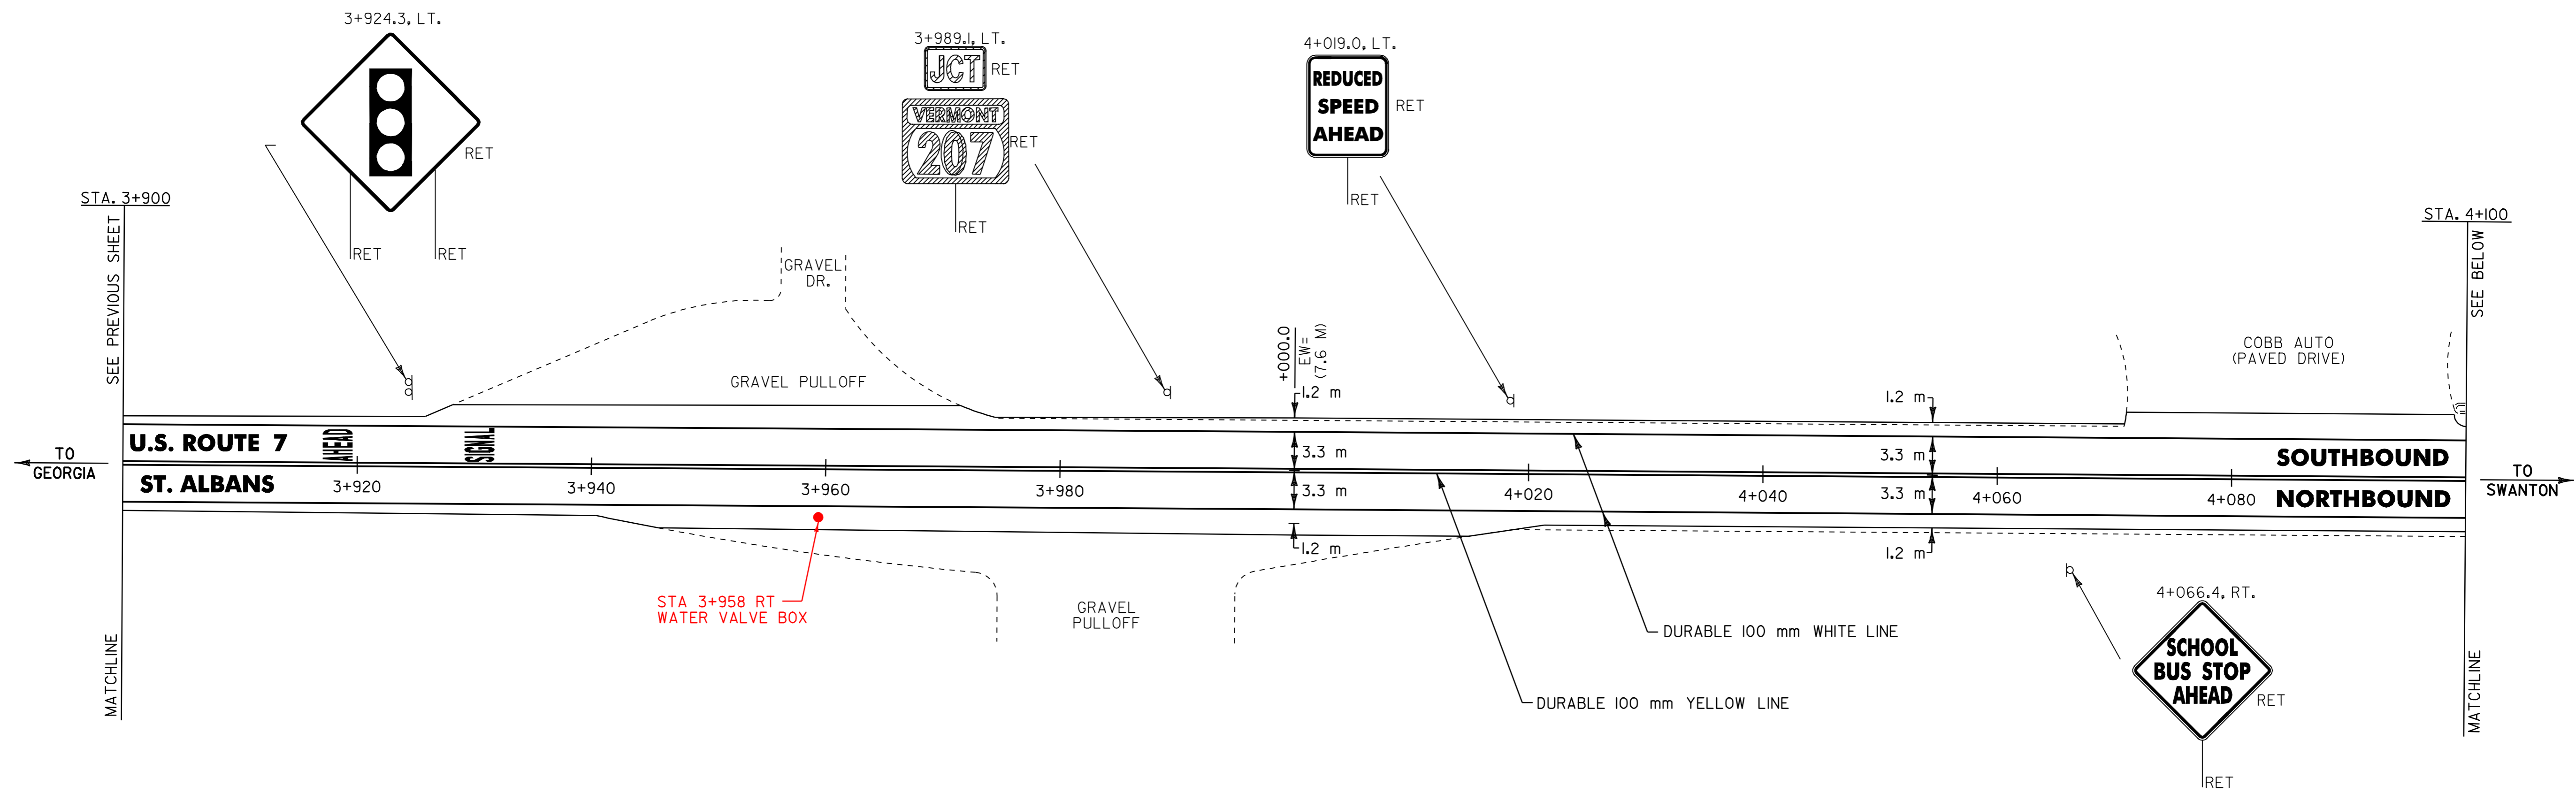

- NOTES: 1) ALL DIMENSIONS IN MILLIMETERS EXCEPT WHERE OTHERWISE INDICATED.  
 2) ALL EXISTING SIGNS NOT SHOWN SHALL BE RETAINED AS DIRECTED BY THE RESIDENT ENGINEER.  
 3) FOR ANY TOWN HIGHWAY OR STREET DETAILS, SEE VTrans STANDARDS E-12IM & E-193M.  
 4) EW = EXISTING ROADWAY WIDTH.

<b>LAYOUT SHEET #7</b>	PROJECT NAME: ST. ALBANS - SWANTON	PLOT DATE: 16-SEP-2005 13:20
	PROJECT NUMBER: STP_2335(I)S	DRAWN BY: D=H
	FILE NAME: /pave/01c016/p01c016.dgn	CHECKED BY: D=H
	DESIGNED BY: D=H	SHEET 63 OF 89

