

TEMPORARY & DURABLE 100 mm WHITE LINE
 STA. I+600.0 TO 2+000.0, SOLID LT. & RT.

TEMPORARY & DURABLE 100 mm YELLOW LINE
 STA. I+600.0 TO 2+000.0, SOLID LT. & RT.

REMOVING SIGNS
 AS SHOWN - 3

REMOVAL AND DISPOSAL OF GUARD RAIL
 STA. I+620.5 TO 2+000.0, LT.




MANUFACTURED TERMINAL SECTION (FLARED)
 STA. I+620.5 TO I+631.9, LT.

STONE FILL, TYPE I
 STA. I+790.0 TO I+792.0, LT.
 STA. I+877.0 TO I+879.5, LT.
 ELIMINATED



STEEL BEAM GUARD RAIL W/2.4 METER POSTS (MOD.)
 STA. I+631.9 TO 2+000.0, LT.

RELOCATE MAIL BOX, SINGLE SUPPORT
 STA. I+710.0, LT.
 STA. I+884.7, LT.
 (FOR FURTHER DETAILS SEE VTrans STANDARD J-3M)

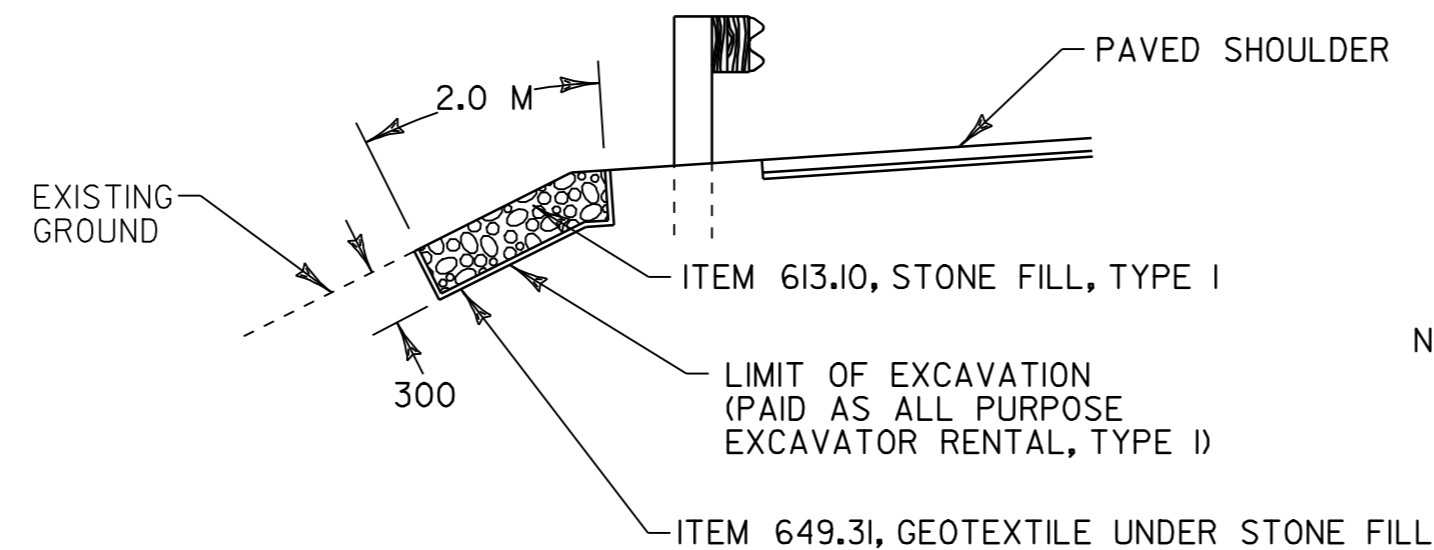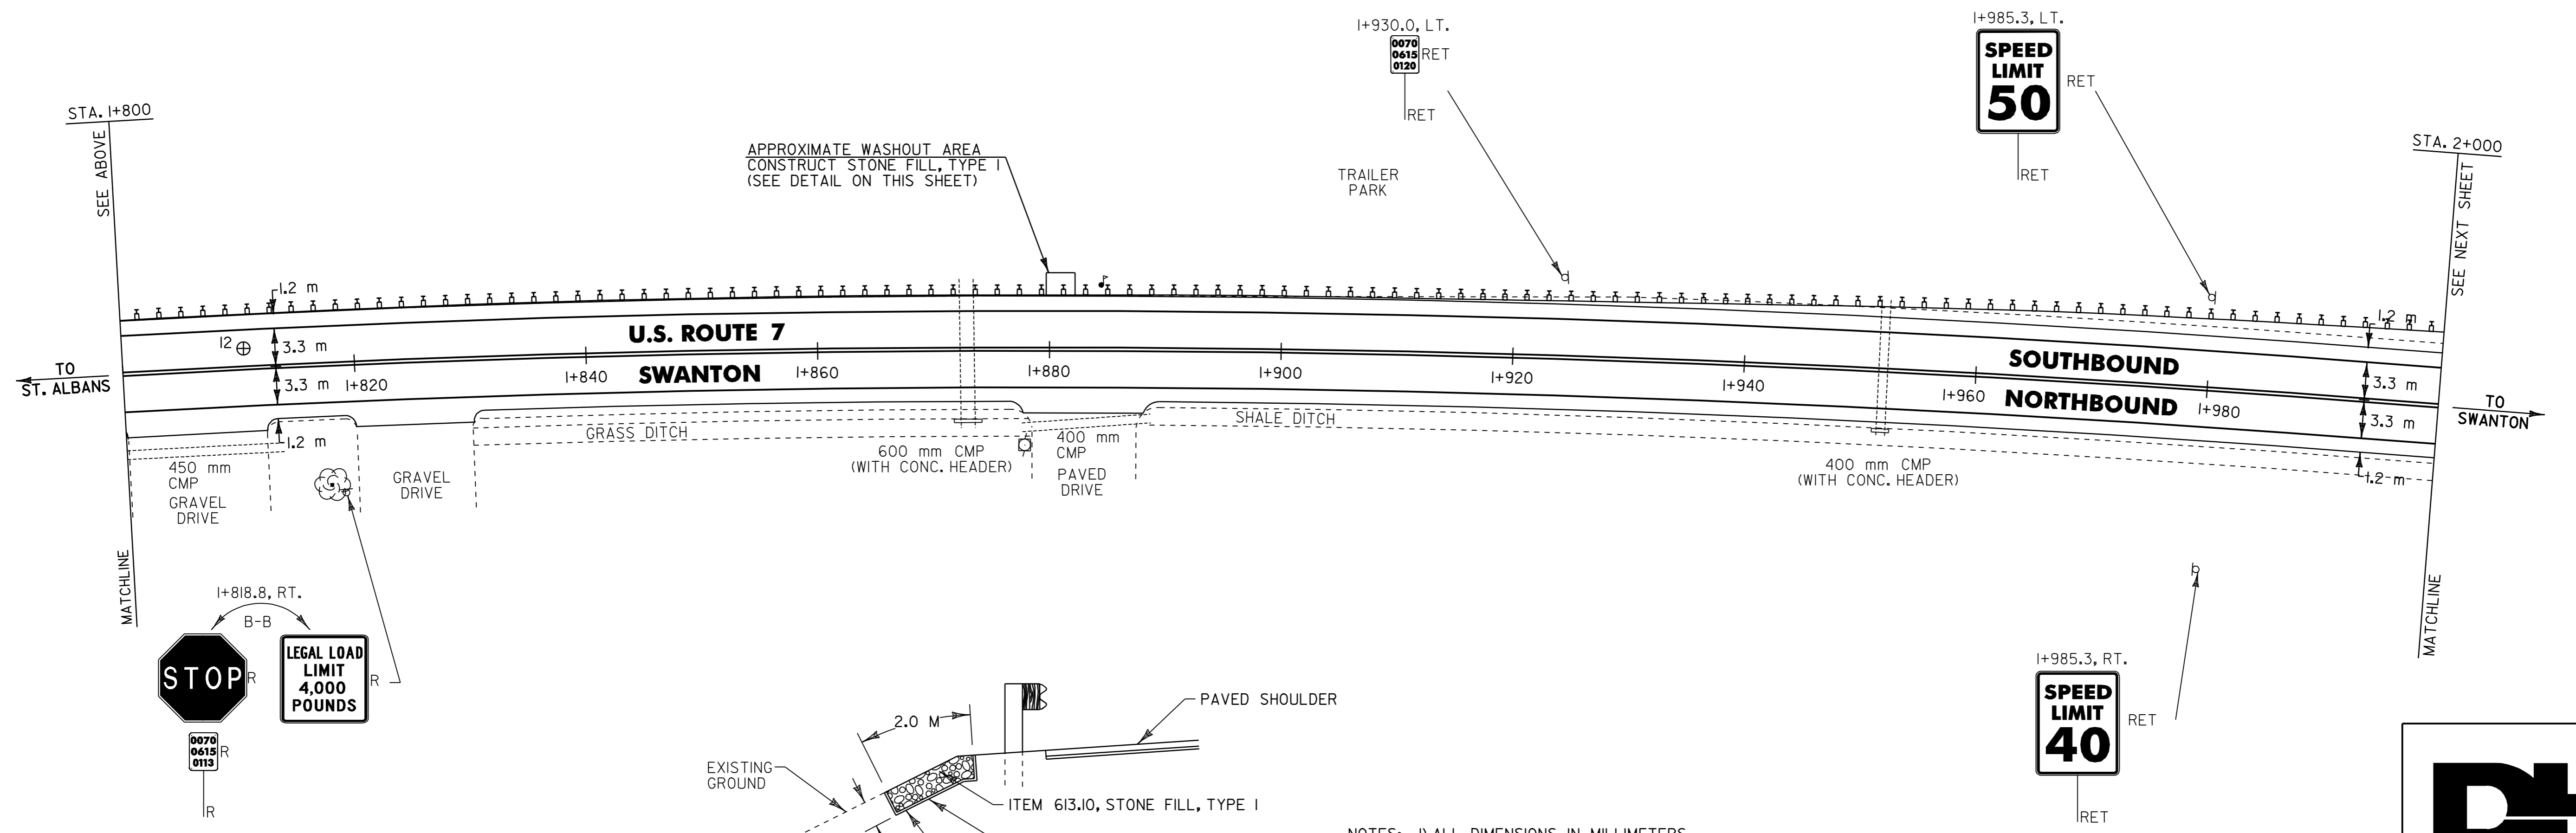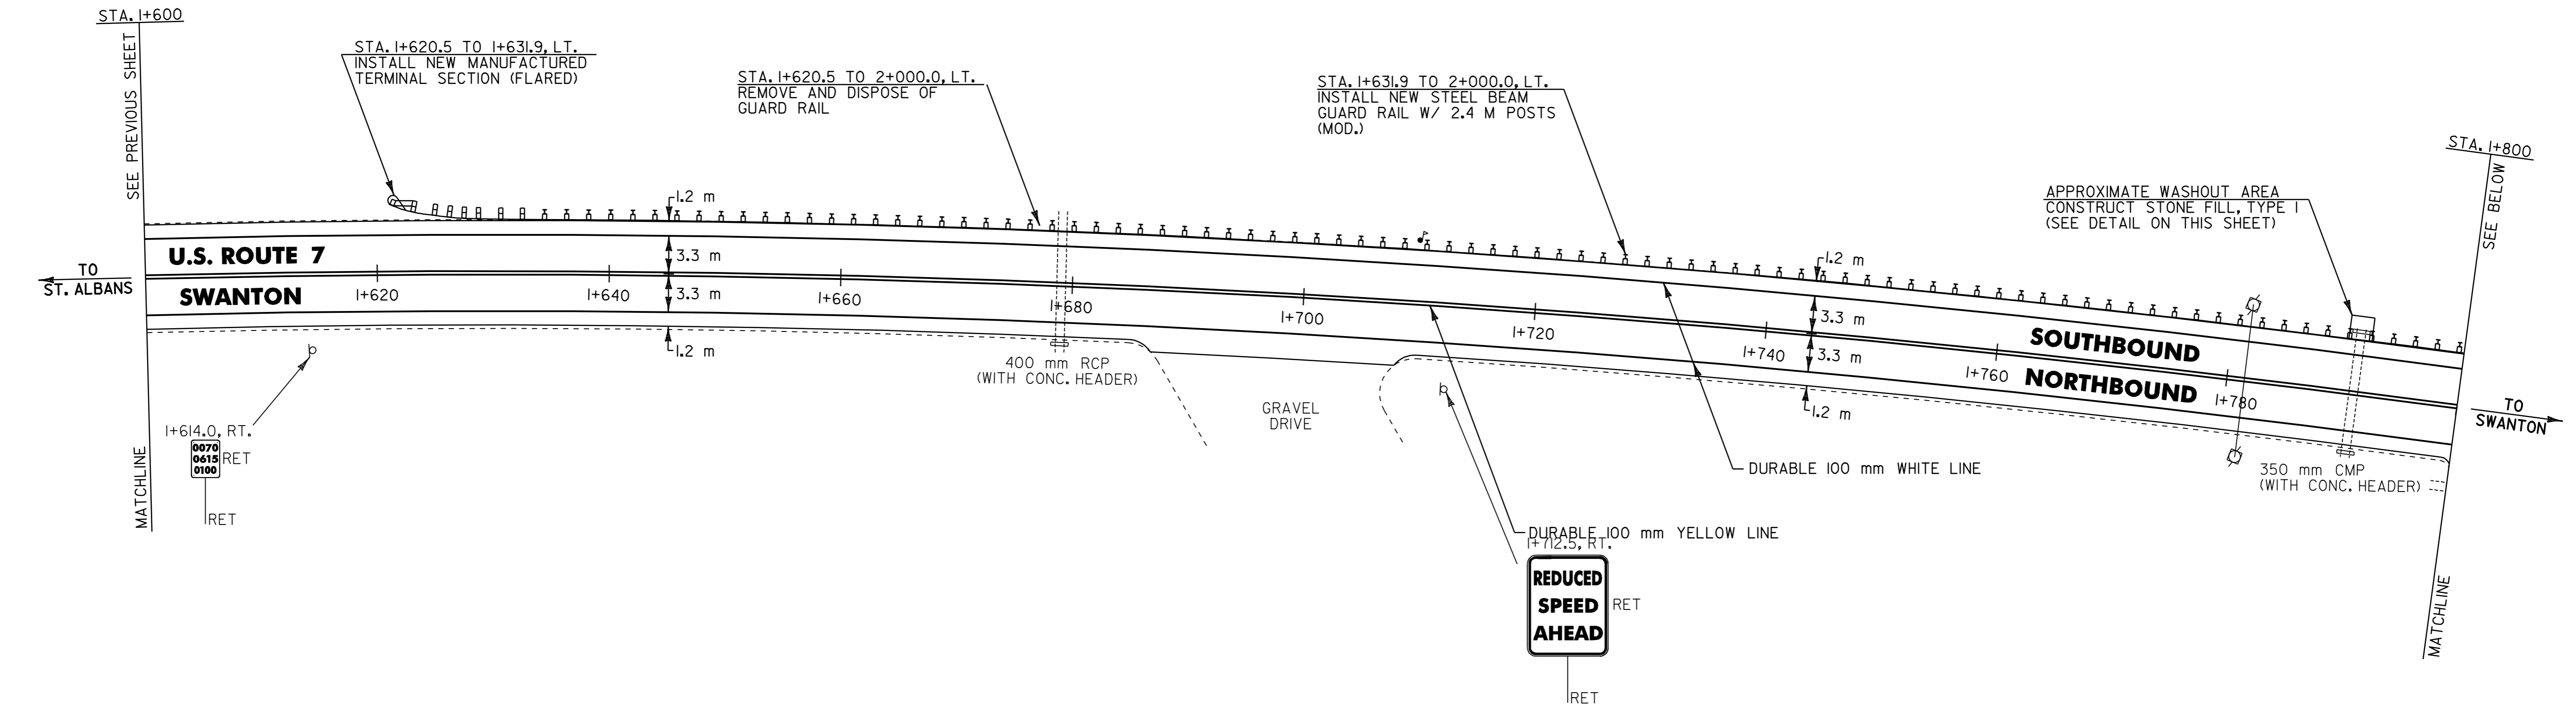

STONE FILL, TYPE I DETAIL
 STA. I+790.0 TO I+792.0, LT.
 STA. I+877.0 TO I+879.5, LT.

- NOTES:
- 1) ALL DIMENSIONS IN MILLIMETERS EXCEPT WHERE OTHERWISE INDICATED.
 - 2) ALL EXISTING SIGNS NOT SHOWN SHALL BE RETAINED AS DIRECTED BY THE RESIDENT ENGINEER.
 - 3) FOR ANY TOWN HIGHWAY OR STREET DETAILS, SEE VTrans STANDARDS E-I21M & E-I93M.
 - 4) EW = EXISTING ROADWAY WIDTH.

⊕ CORE LOCATION

PAVEMENT CORE DATA			
CORE #	LOCATION	DEPTH (mm)	PCC
I2	I+810.5, LT.	203	NO

LAYOUT SHEET #13

PROJECT NAME: ST. ALBANS - SWANTON
 PROJECT NUMBER: SIP_2335(I)S
 FILE NAME: /pave/01c016/p01c016.dgn PLOT DATE: 16-SEP-2005 13:21
 PROJECT LEADER: JLL DRAWN BY: D:H
 DESIGNED BY: D:H CHECKED BY: D:H
 IPARM FILE NAME: p01c016i13.1 SHEET 69 OF 89

