

TEMPORARY & DURABLE 100 mm WHITE LINE (MOD. I)
 STA. 6+000.0 TO 6+400.0, SOLID LT. & RT.
 (WITH EDGELINE BREAK FOR BEEBE RD.)
 STA. 6+024.8, DOUBLE SOLID LT. (BEEBE RD. EDGELINES)



TEMPORARY & DURABLE 100 mm YELLOW LINE (MOD. I)
 STA. 6+000.0 TO 6+002.9, DASHED LT./ SOLID RT.
 STA. 6+002.9 TO 6+400.0, SOLID LT. & RT.
 (WITH CENTERLINE BREAK FOR BEEBE RD.)
 STA. 6+024.8, DOUBLE SOLID LT. (BEEBE RD. CENTERLINE)

TEMPORARY & DURABLE 600 mm STOP BAR (MOD. I)
 STA. 6+024.8, LT.

TEMPORARY & DURABLE LETTER OR SYMBOL (MOD. I)
 STA. 6+024.8, LT - STOP

ERECTING SALVAGED SIGNS
 AS SHOWN - 1

REMOVING SIGNS
 AS SHOWN - 2

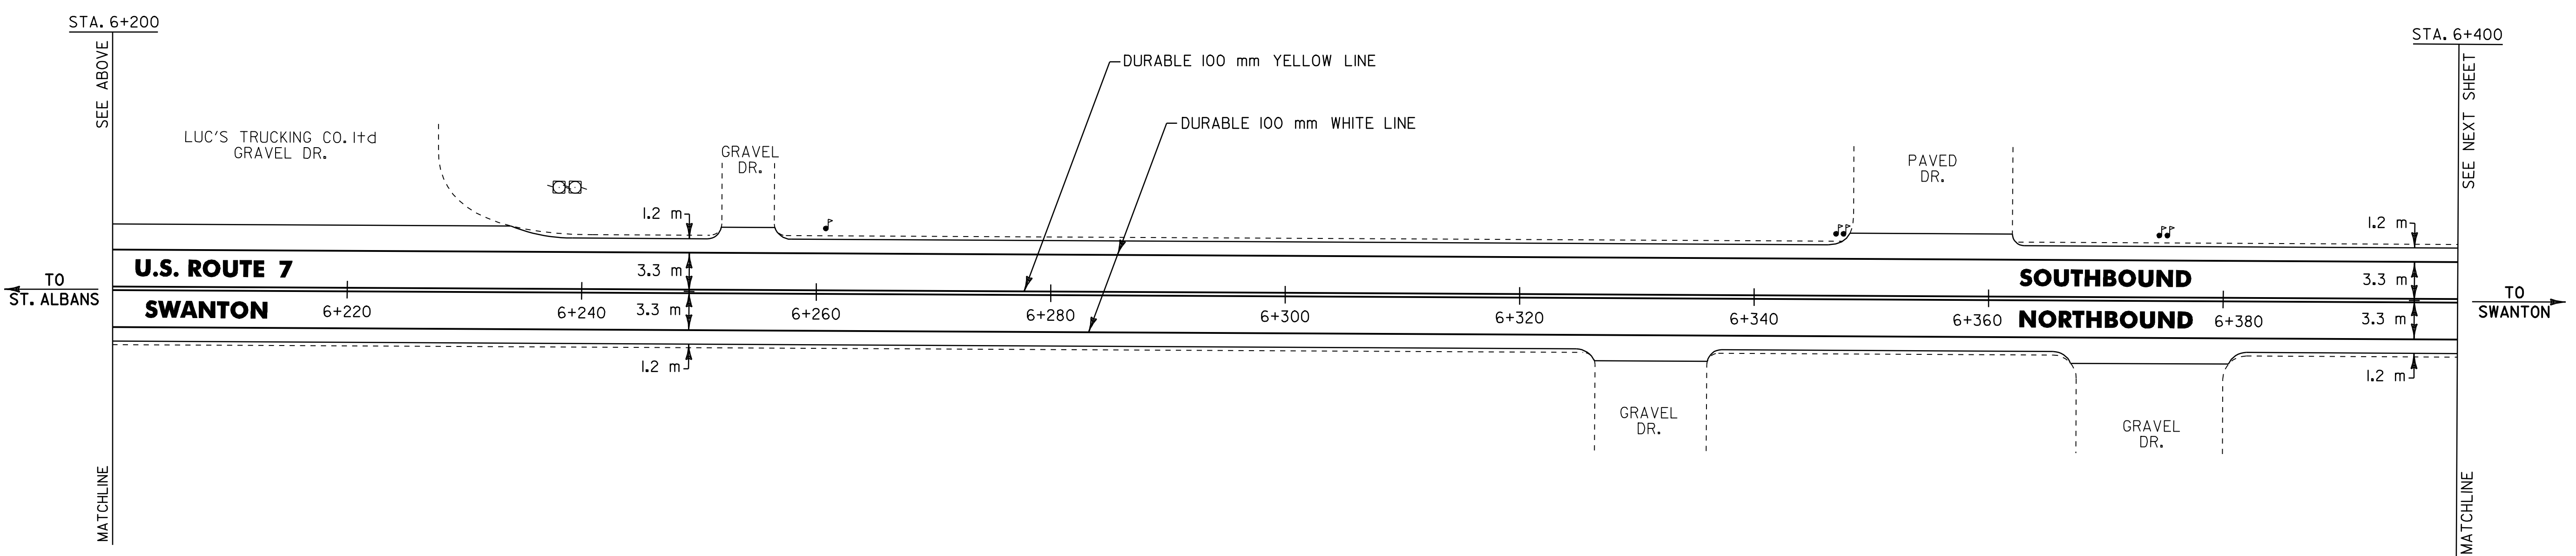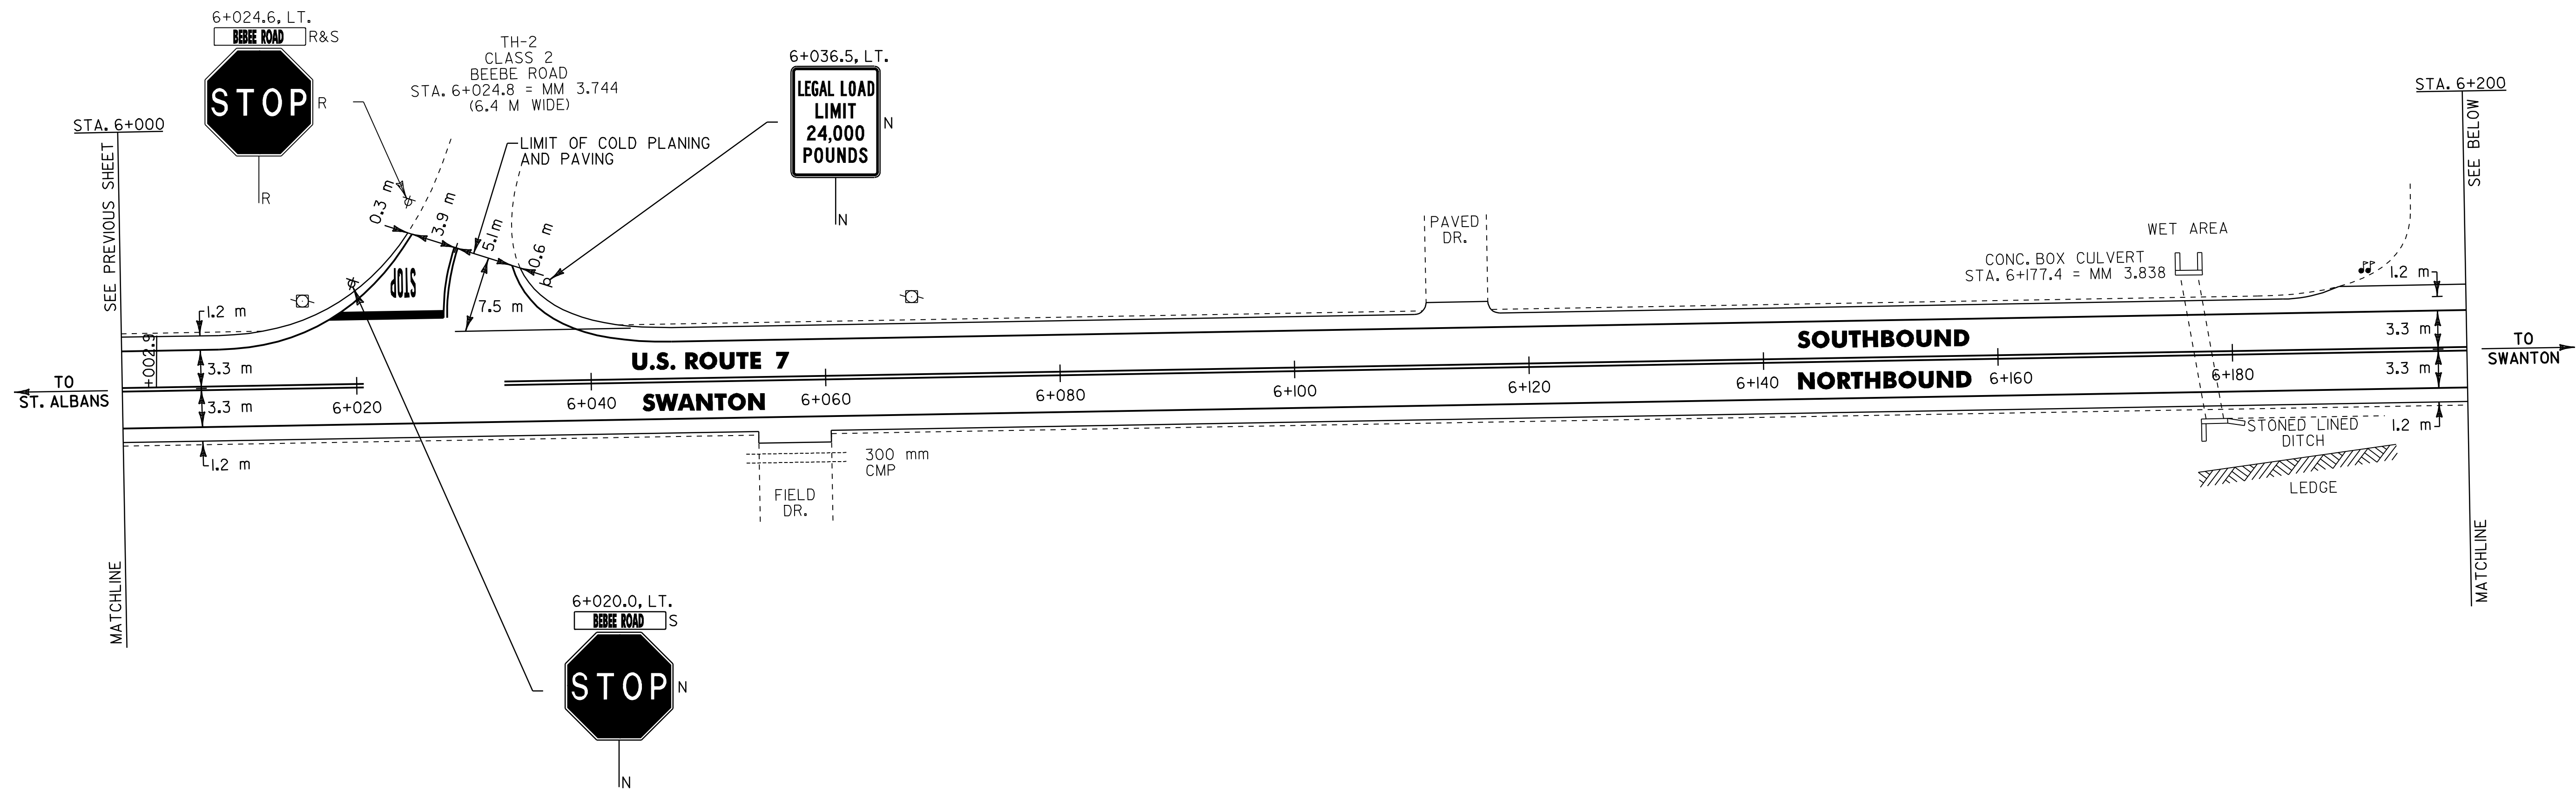

- NOTES: 1) ALL DIMENSIONS IN MILLIMETERS EXCEPT WHERE OTHERWISE INDICATED.
 2) ALL EXISTING SIGNS NOT SHOWN SHALL BE RETAINED AS DIRECTED BY THE RESIDENT ENGINEER.
 3) FOR ANY TOWN HIGHWAY OR STREET DETAILS, SEE VTrans STANDARDS E-121M & E-193M.
 4) EW = EXISTING ROADWAY WIDTH.



LAYOUT SHEET #24	PROJECT NAME: ST. ALBANS - SWANTON	FILE NAME: /pave/01c016/p01c016.dgn	PLOT DATE: 16-SEP-2005
	PROJECT NUMBER: STP 2335(1)S	PROJECT LEADER: JLL	DRAWN BY: D-H
		DESIGNED BY: D-H	CHECKED BY: D-H