
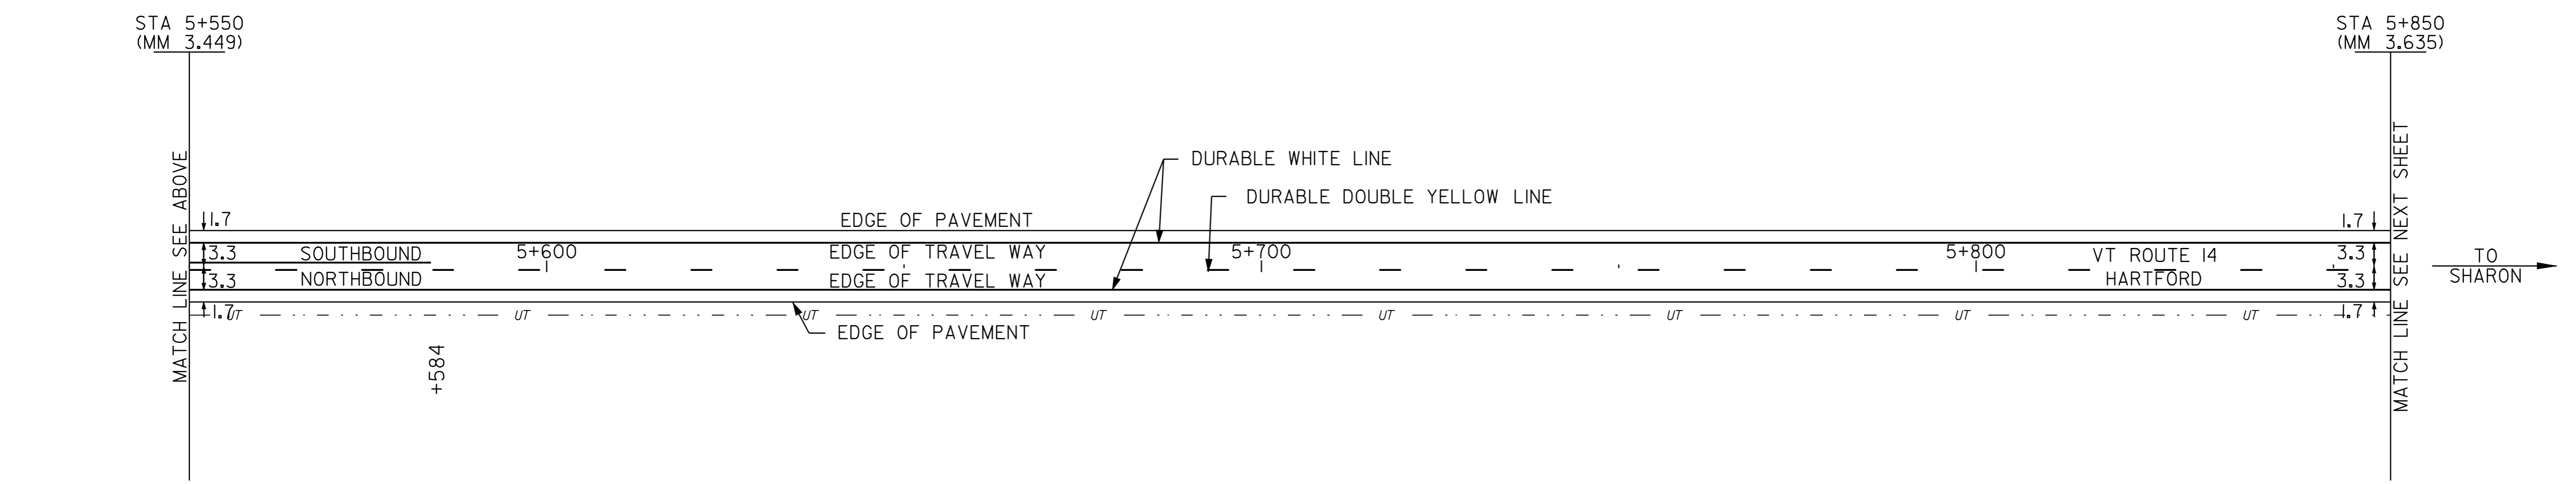


TEMPORARY AND DURABLE 100 mm YELLOW LINE
 STA 5+250 TO 5+351 SOLID LT & RT
 STA 5+351 TO 5+584 SOLID LT, DASHED RT
 STA 5+584 TO 5+850 DASHED

TEMPORARY AND DURABLE 100 mm WHITE LINE
 STA 5+250 TO 5+850 SOLID LT & RT

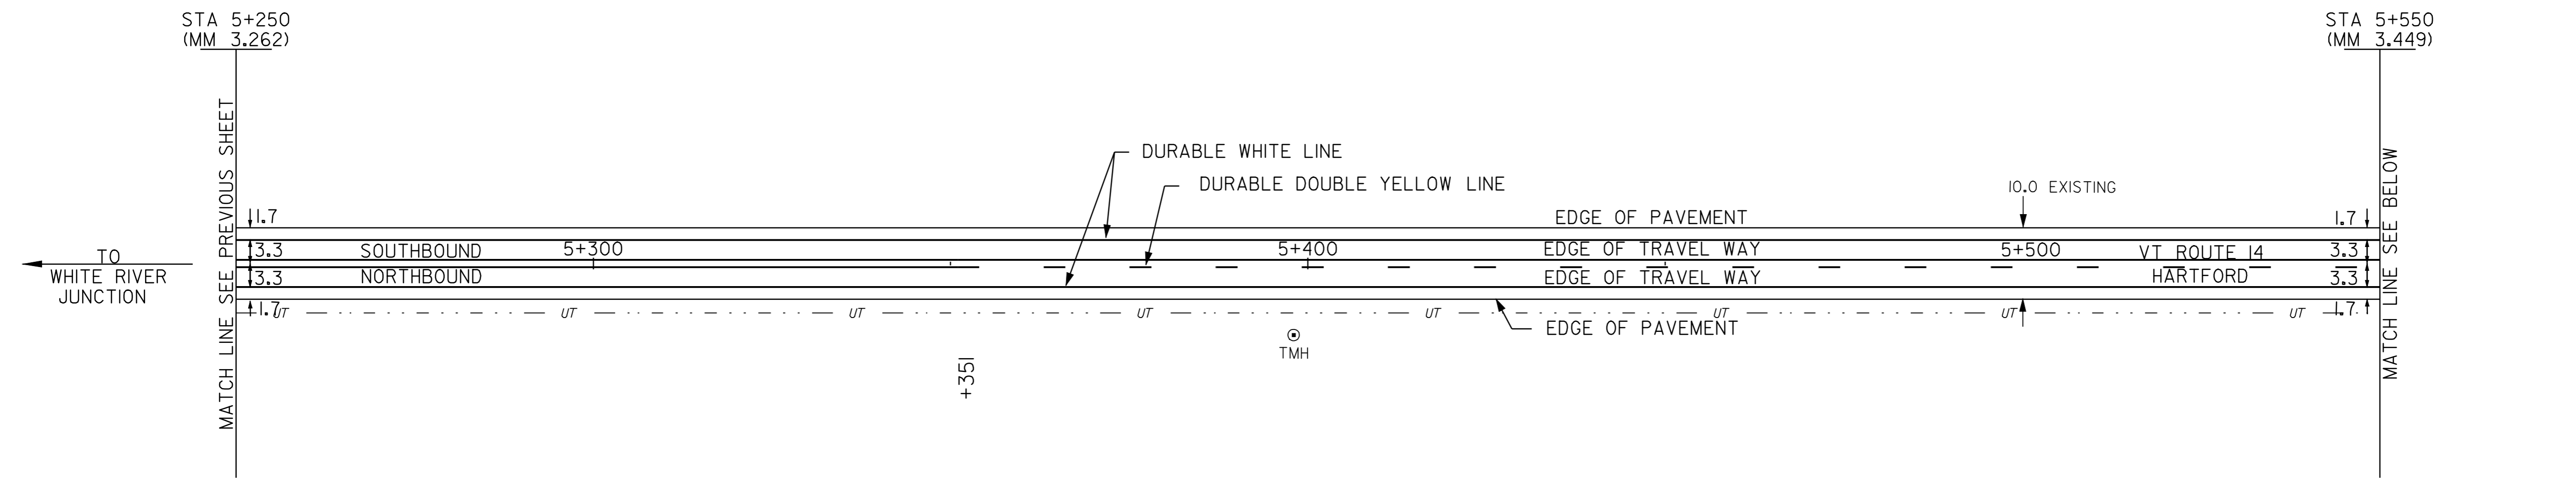

LEGEND

- R = REMOVE EXISTING
- S = SALVAGE
- R&S = REMOVE AND SALVAGE
- N = NEW
- RET = RETAIN
- B-B = BACK TO BACK
- = NEW RAIL
- - - = EXISTING RAIL
- ⊗ = BORING LOCATION

NOTE: ALL DIMENSIONS IN METERS EXCEPT AS INDICATED

DATUM	
VERTICAL	N/A
HORIZONTAL	N/A

NOT TO SCALE

**PAVING
PROJECT
LAYOUT #6**

PROJECT: HARTFORD - ROYALTON	PROJECT NO.: STP 212(1)S
DESIGN FILE NAME: /pave/98cl74/pcl74.dgn	PLOT DATE: 21-MAR-2007
IPARM FILE NAME: _pcl74i06.j	SURVEY DATE: 8/99
SURVEYED BY: _CLD_ENGINEERS_INC	DRAWN BY: _REB
SQUAD LEADER: _WRH	SHEET: 16 OF 64