

TEMPORARY AND DURABLE 100 mm YELLOW LINE
 STA 9+450 TO 10+050 SOLID LT & RT

TEMPORARY AND DURABLE 100 mm WHITE LINE
 STA 9+450 TO 10+050 SOLID LT & RT

STEEL BEAM GUARDRAIL
 STA 9+639 TO 9+716 LT
 STA 9+645 TO 9+664 RT

REMOVAL & DISP. OF GUIDE POSTS
 STA 9+923 RT (1)

CHANGING ELEV. OF DI, CB OR MH
 REHABILITATION OF DI, CB OR MH

STA 9+548 RT
 STA 9+595 RT


REMOVAL & DISP. OF GUARDRAIL
 STA 9+639 TO 9+650 LT
 STA 9+648 TO 9+675 RT
 STA 9+851 TO 9+862 LT

ANCHOR FOR STEEL BEAM RAIL
 STA 9+645 RT (2)

SHOULDER BERM REMOVAL
 STA 9+450 TO 9+639 LT
 STA 9+862 TO 10+050 LT

REMOVAL & RESET GUARDRAIL
 STA 9+664 TO 9+675 RT

MANUFACTURED TERMINAL SECTION (FLARED)
 STA 9+716 TO 9+727 LT
 STA 9+664 TO 9+675 RT
 STA 9+851 TO 9+862 LT

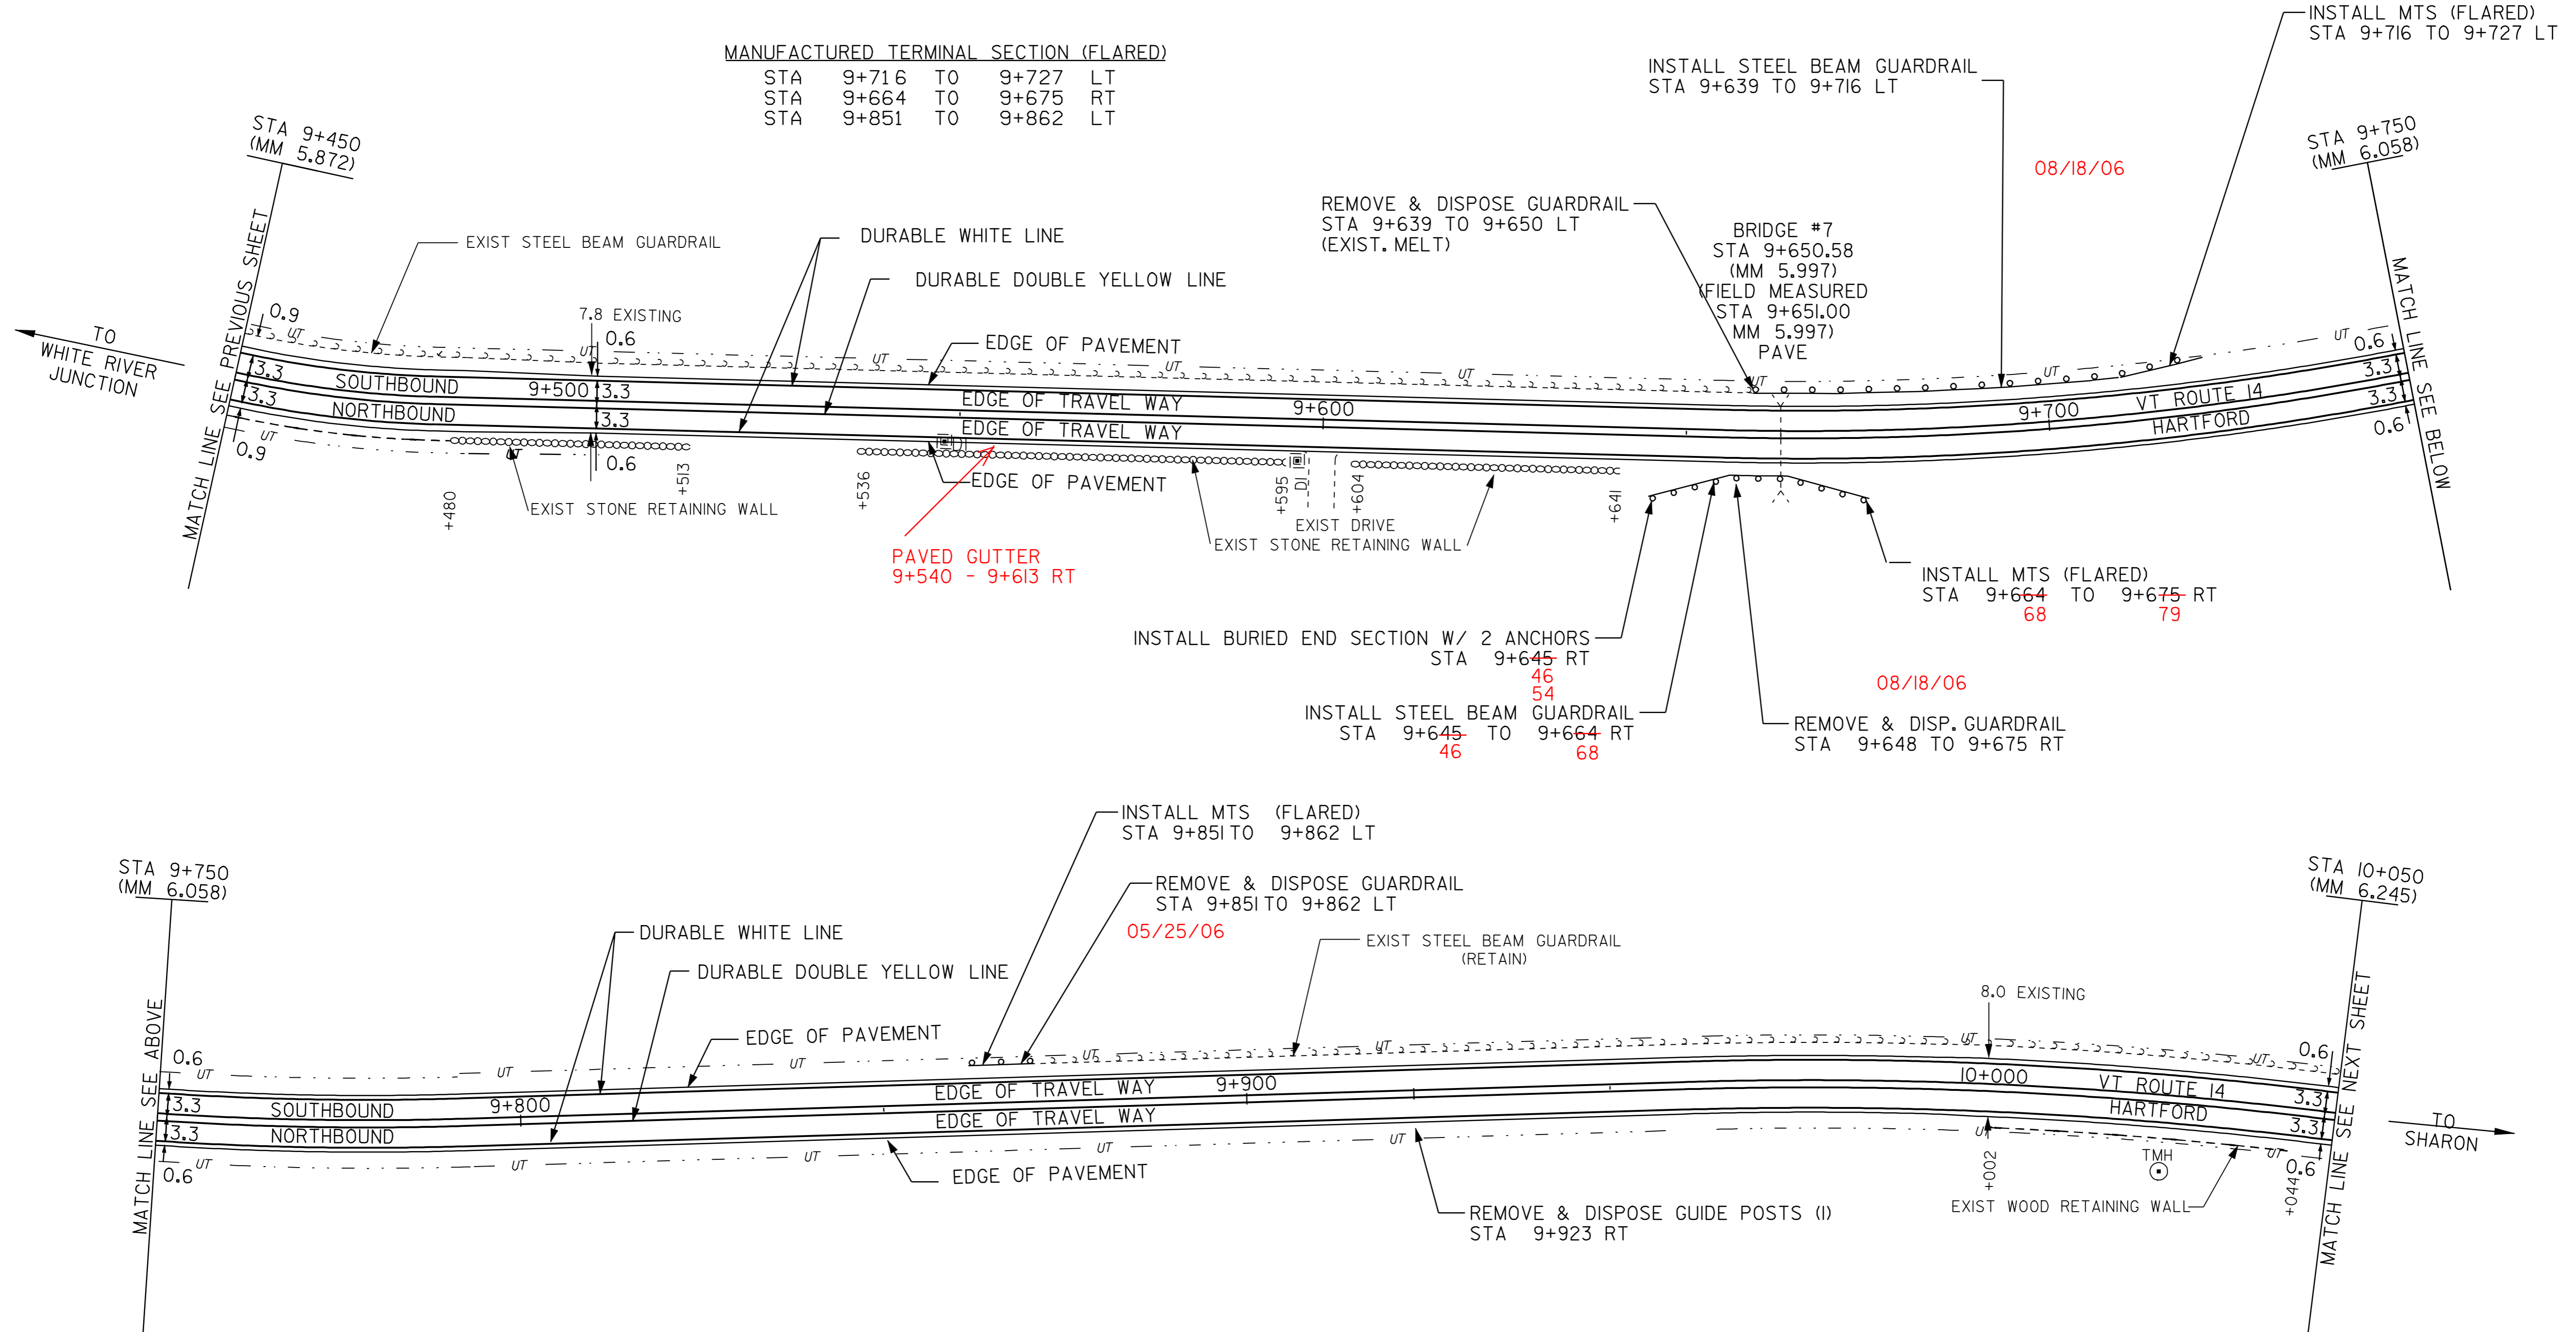

- LEGEND
- R = REMOVE EXISTING
 - S = SALVAGE
 - R&S = REMOVE AND SALVAGE
 - N = NEW
 - RET = RETAIN
 - B-B = BACK TO BACK
 - - - = NEW RAIL
 - = EXISTING RAIL
 - ⊗ = BORING LOCATION

NOTE: ALL DIMENSIONS IN METERS EXCEPT AS INDICATED

DATUM	
VERTICAL	N/A
HORIZONTAL	N/A

NOT TO SCALE

PAVING PROJECT LAYOUT #13

PROJECT: HARTFORD - ROYALTON	PROJECT NO. : STP 212(K)S
DESIGN FILE NAME: /pave/98cl74/pcl74.dgn	PLOT DATE: 21-MAR-2007
IPARM FILE NAME: pcl74i3.i	SURVEY DATE: 8/99
SURVEYED BY: CLD_ENGINEERS_INC	DRAWN BY: REB
SQUAD LEADER: WRH	SHEET: 23 OF 64