

TEMPORARY AND DURABLE 100 mm YELLOW LINE  
 STA 11+800 TO 12+400 SOLID LT & RT

TEMPORARY AND DURABLE 100 mm WHITE LINE  
 STA 11+800 TO 12+400 SOLID LT & RT

STEEL BEAM GUARDRAIL  
 STA 12+020 TO 12+050 RT  
 STA 12+117 TO 12+140 RT  
 STA 12+081 TO 12+342 LT  
 85 138  
 12+145 - 12+207 LT  
 12+237 - 12+275 LT

SHOULDER BERM REMOVAL  
 STA 11+800 TO 12+081 LT  
 STA 12+334 TO 12+400 LT

ANCHOR FOR STEEL BEAM RAIL  
 STA 12+020 RT  
 STA 12+050 RT  
 STA 12+117 RT  
 STA 12+140 RT

BITUMINOUS CONCRETE  
 GUTTER AND TRAFFIC ISLAND  
 STA 12+368 LT

300 mm CSP 1.7 mm (68mm X 12mm)  
 STA 12+137 TO 12+141 RT



MTS FLARED

12+150 - 12+161 LT  
 12+191 - 12+202 LT

REMOVE & DISPOSE GUARDRAIL 88  
 STA 12+081 TO 12+089 LT  
 STA 12+334 TO 12+342 LT  
 43 51  
 12+202 TO 12+150

STEEL BEAM GUARDRAIL W/ 2.4m POSTS

STA 12+207 - 12+237 LT  
 STA 12+138 - 12+145 LT  
 STA 12+257 - 12+352 LT

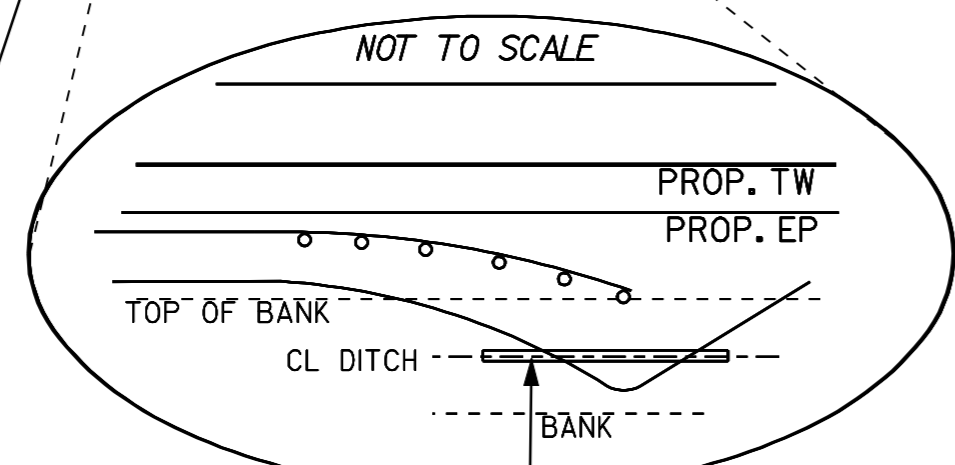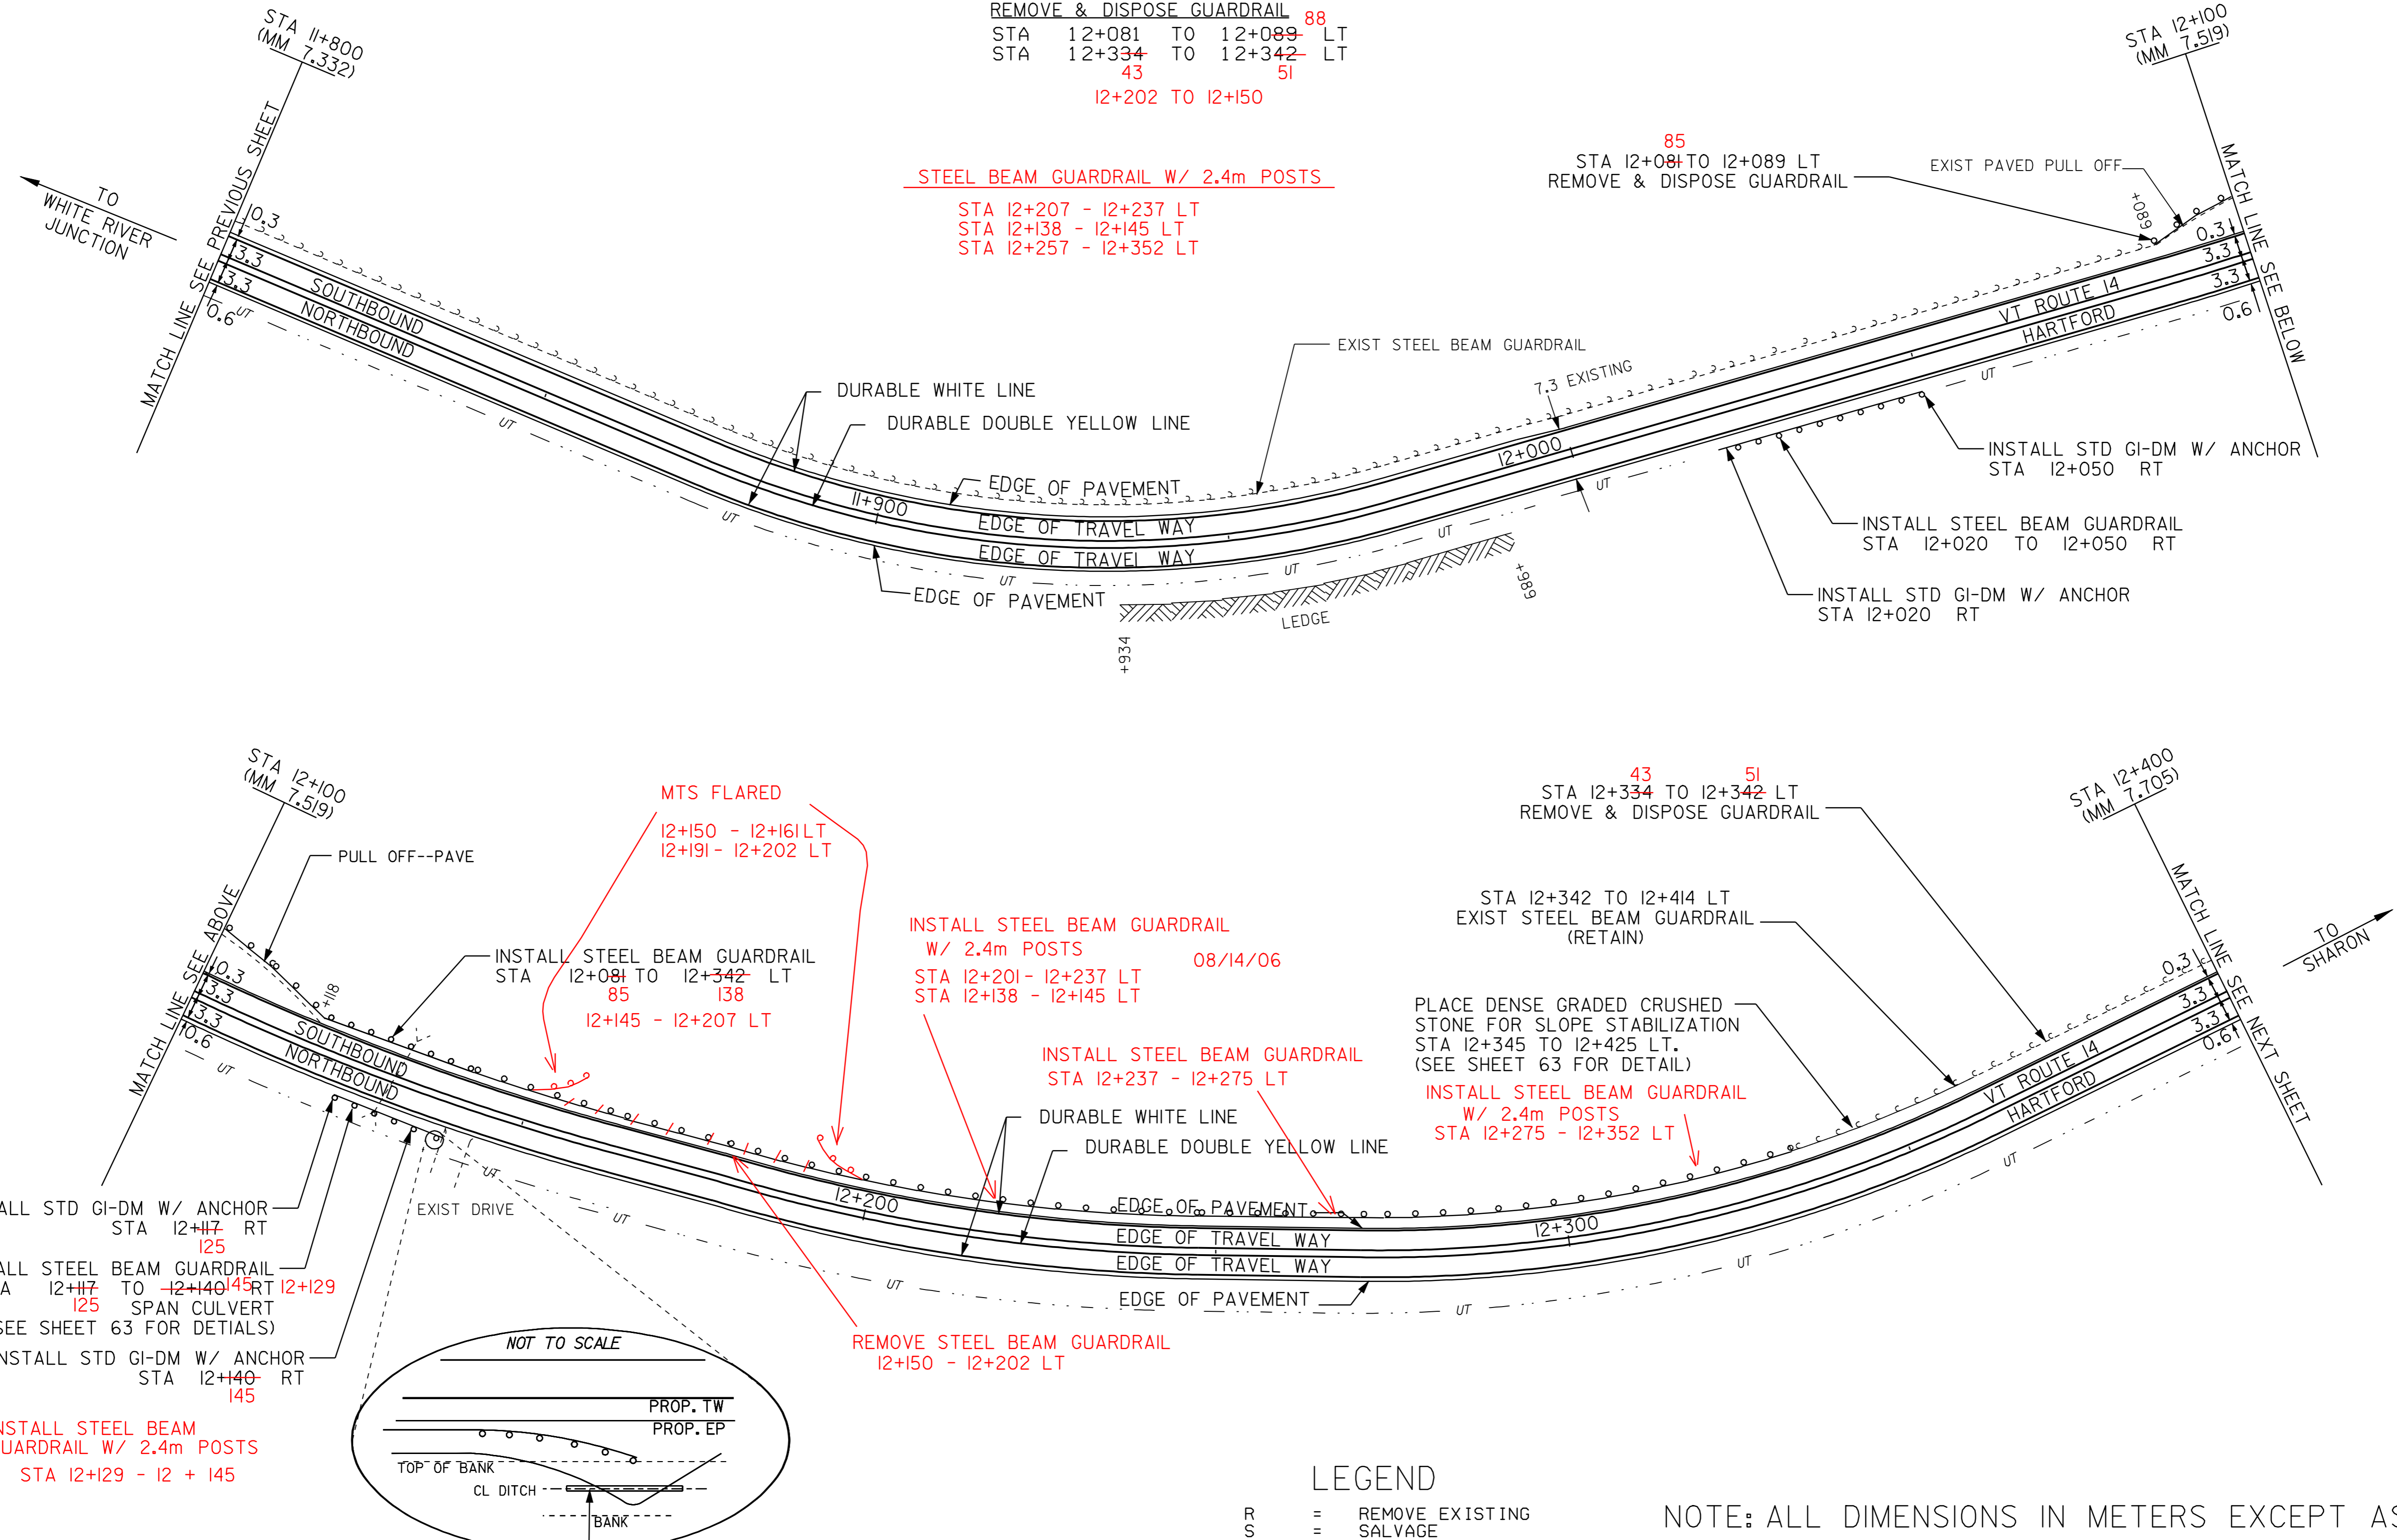

NEW 300 mm x 4 m CSP (1.7 mm)

NOT TO SCALE

- LEGEND
- R = REMOVE EXISTING
  - S = SALVAGE
  - R&S = REMOVE AND SALVAGE
  - N = NEW
  - RET = RETAIN
  - B-B = BACK TO BACK
  - = NEW RAIL
  - ⋯ = EXISTING RAIL
  - ⊗ = BORING LOCATION

NOTE: ALL DIMENSIONS IN METERS EXCEPT AS INDICATED

DATUM	
VERTICAL	N/A
HORIZONTAL	N/A

<b>PAVING PROJECT LAYOUT #17</b>	PROJECT: HARTFORD - ROYALTON	PROJECT NO.: STP 212(1)S
	DESIGN FILE NAME: /pave/98cl74/pol74.dgn	PLOT DATE: 21-MAR-2007
	IPARM FILE NAME: pol74ll7.i	SURVEY DATE: 8/99
	SURVEYED BY: CLD ENGINEERS INC	DRAWN BY: REB
	SQUAD LEADER: WRH	SHEET: 27 OF 64