

TEMPORARY AND DURABLE 100 mm YELLOW LINE
 STA 1+550 TO 1+593 DASHED LT, SOLID RT
 STA 1+593 TO 2+150 SOLID LT& RT

STEEL BEAM GUARDRAIL
 STA 1+761 TO 1+797 LT
 STA 2+124 TO 2+135 RT
 44

300mm CSP 1.7 mm (68mm X 12mm)
 STA 2+118 TO 2+133 RT

REMOVAL & DISPOSAL OF GUIDE POST
 STA 2+105 RT (1)
 10

TEMPORARY AND DURABLE 100 mm WHITE LINE
 STA 1+550 TO 2+150 SOLID LT & RT


ANCHOR FOR STEEL BEAM RAIL
 STA 2+124 RT
 STA 2+135 RT
 44

RELOCATE MAILBOX - SINGLE SUPPORT
 STA 2+059 RT
 2+110 RT

MANUFACTURED TERMINAL SECTION (FLARED)
 STA 1+745 TO 1+756 RT
 STA 1+750 TO 1+761 LT
 STA 1+797 TO 1+808 LT
 STA 1+813 TO 1+824 RT
 STA 1+925 TO 1+936 LT TANGENT
 40


REMOVE & DISPOSE GUARDRAIL
 STA 1+745 TO 1+756 RT
 STA 1+750 TO 1+808 LT
 STA 1+813 TO 1+824 RT
 STA 1+925 TO 1+936 LT

SHOULDER BERM REMOVAL
 STA 1+767 TO 1+806 RT
 STA 1+936 TO 2+150 LT

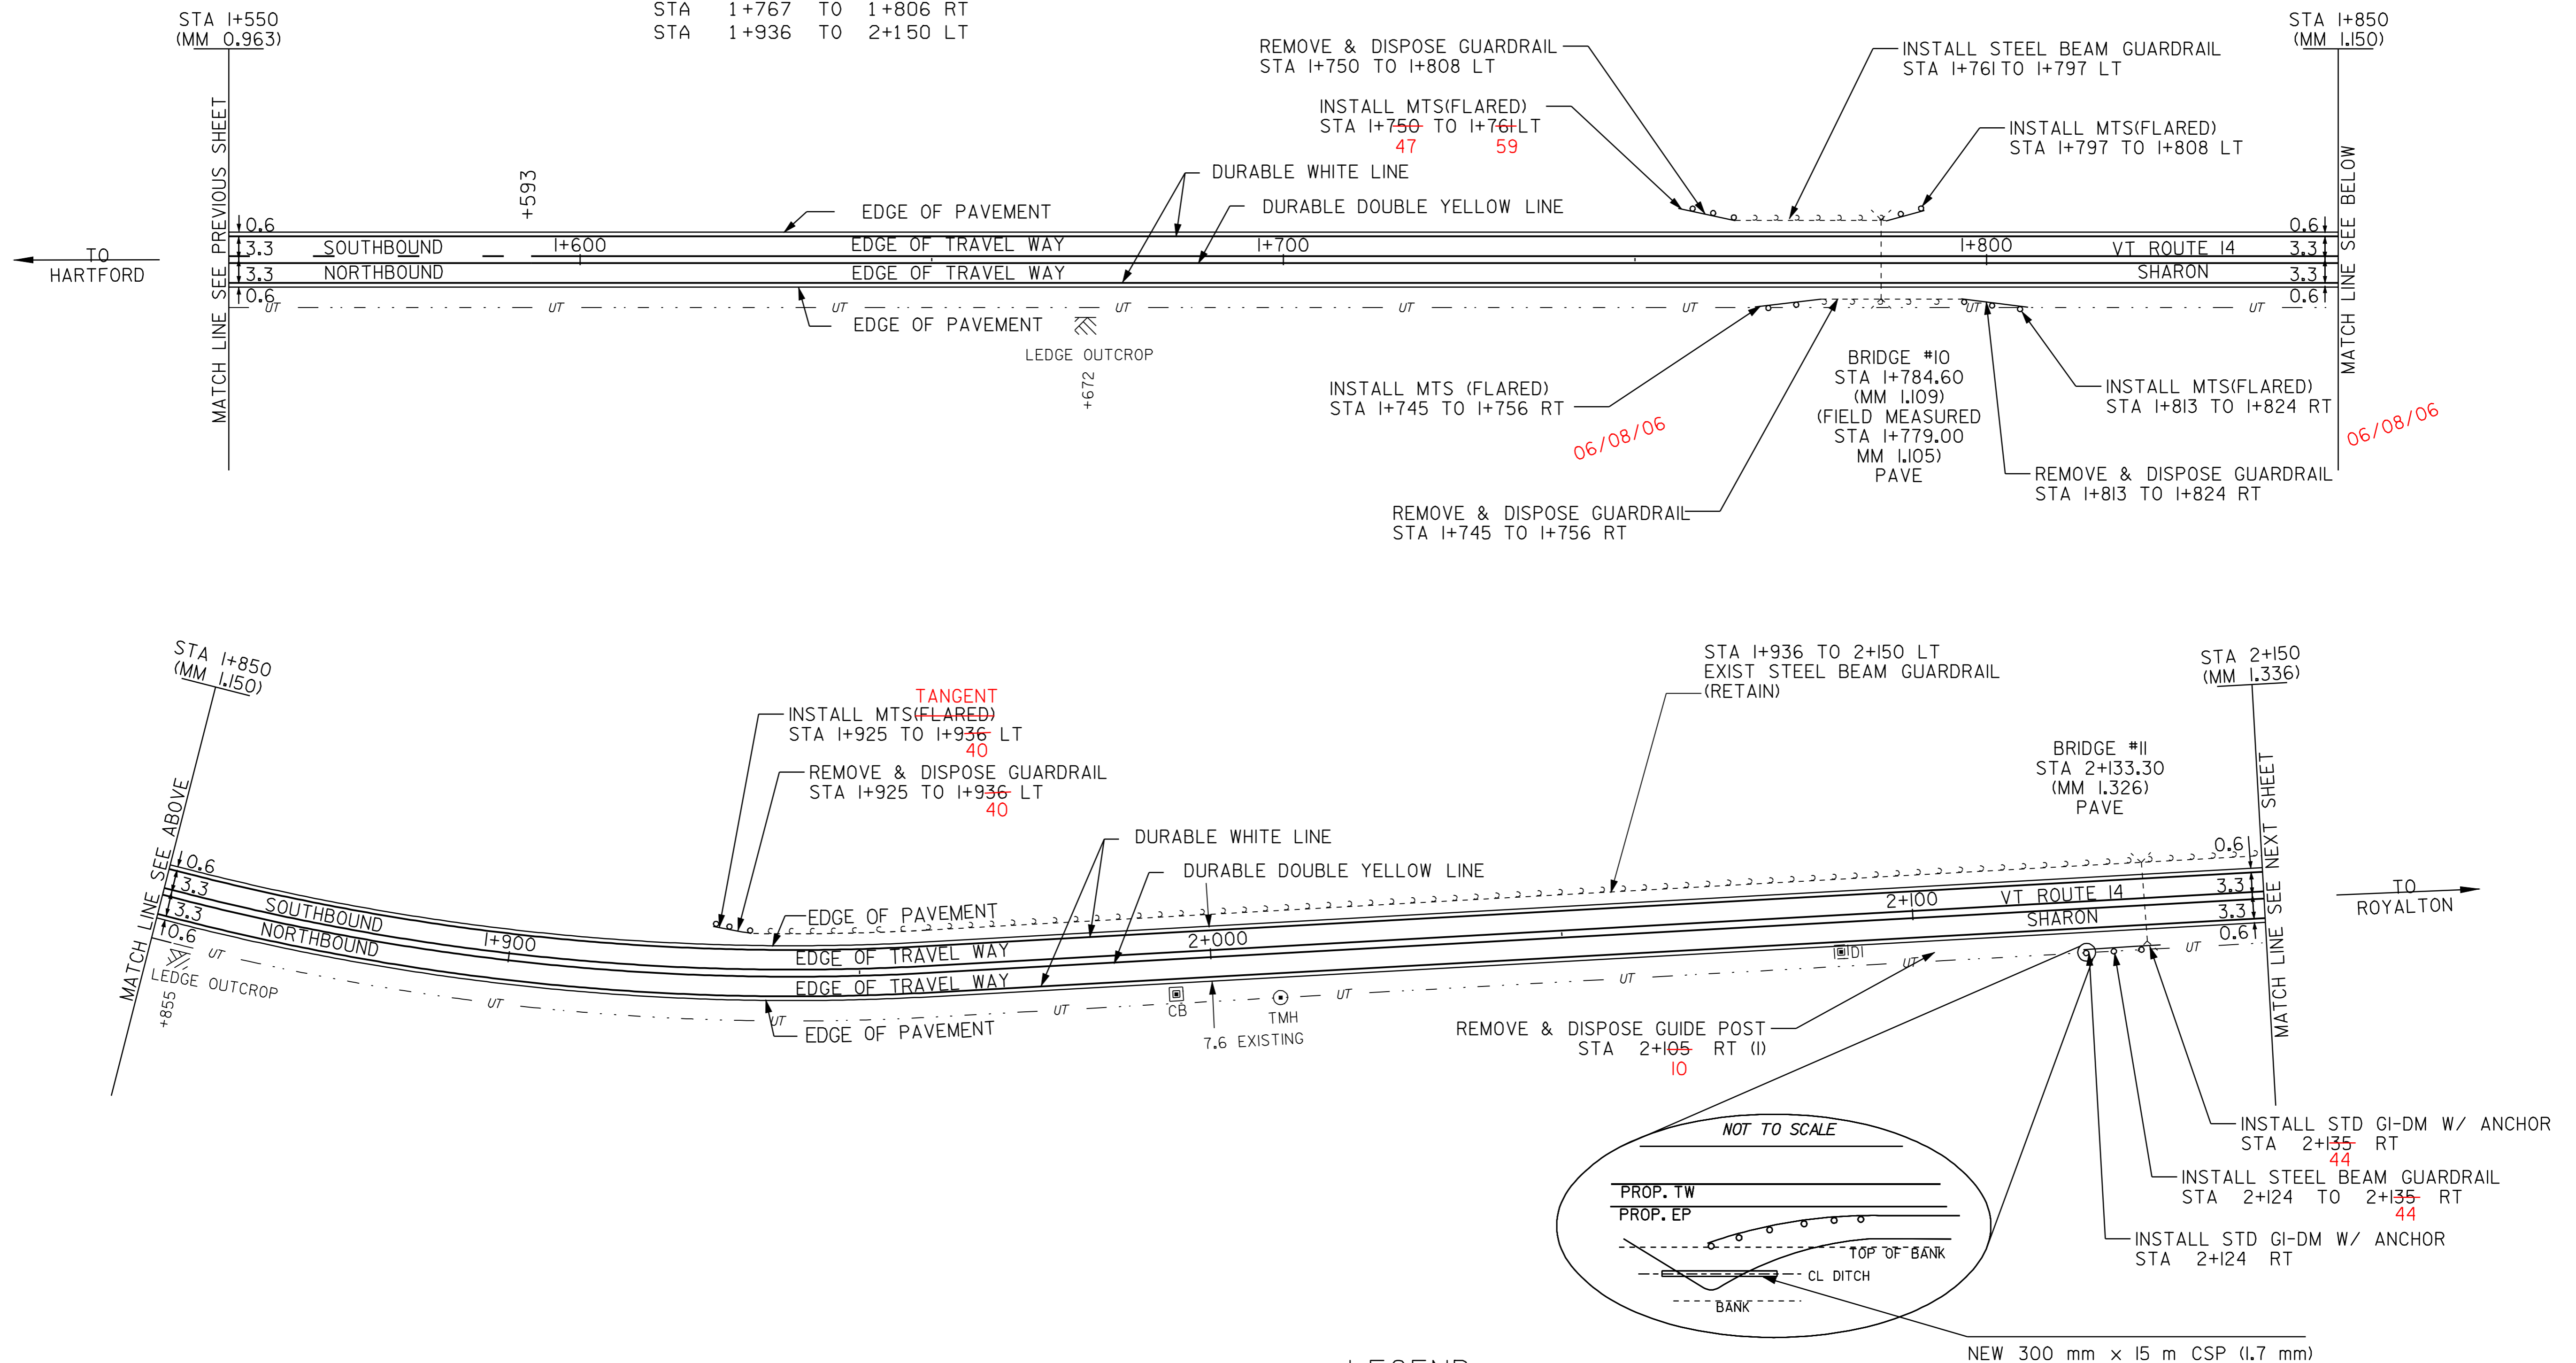

MATCH LINE SEE ABOVE
 STA 1+850 (MM 1.150)
 +855

MATCH LINE SEE NEXT SHEET
 STA 2+150 (MM 1.336)

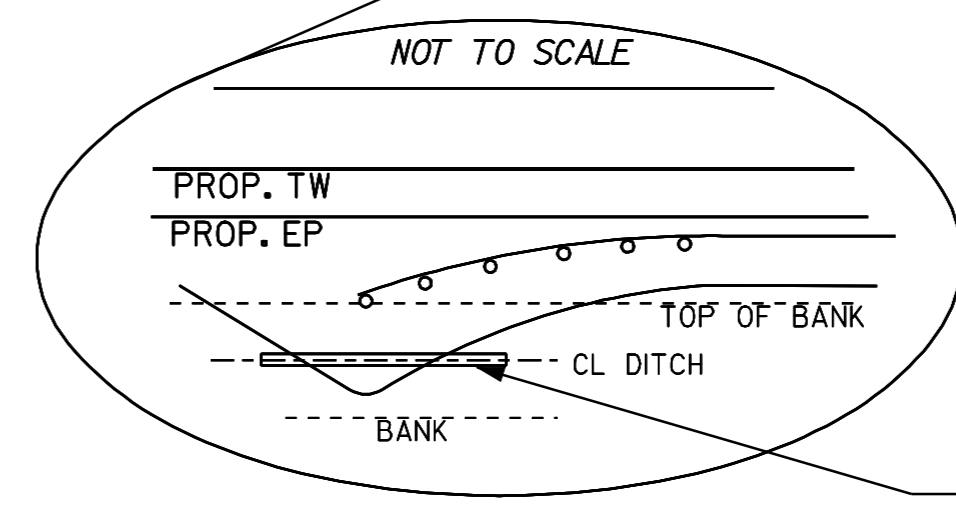

LEGEND

- R = REMOVE EXISTING
- S = SALVAGE
- R&S = REMOVE AND SALVAGE
- N = NEW
- RET = RETAIN
- B-B = BACK TO BACK
- = NEW RAIL
- - - = EXISTING RAIL
- ⊗ = BORING LOCATION

NOTE: ALL DIMENSIONS IN METERS EXCEPT AS INDICATED

DATUM	
VERTICAL	N/A
HORIZONTAL	N/A

NOT TO SCALE

PAVING PROJECT LAYOUT #21	PROJECT: HARTFORD - ROYALTON	PROJECT NO.: STP 212(1)S
	DESIGN FILE NAME: /pave/98ci74/pol74.dgn	PLOT DATE: 21-MAR-2007
	IPARM FILE NAME: pol74i21	SURVEY DATE: 8/99
	SURVEYED BY: CLD_ENGINEERS_INC	DRAWN BY: REB
SQUAD LEADER: WRH	SHEET: 31 OF 64	