

TEMPORARY AND DURABLE 100 mm YELLOW LINE
 STA 2+750 TO 3+350 SOLID LT & RT



REMOVAL & DISPOSAL OF GUIDE POSTS
 STA 3+005 LT (2)

CHANGING ELEV. OF DI, CB OR MH
 REHABILITATION OF DI, CB OR MH
 STA 3+333 RT OTDI

TEMPORARY AND DURABLE 100 mm WHITE LINE
 STA 2+750 TO 3+350 SOLID LT & RT

~~RELOCATE MAILBOX - MULTIPLE SUPPORT~~
 STA 3+150 RT LT - 2 EA
 60
 3+020 LT - 1EA

RELOCATE MAILBOX - MULTIPLE SUPPORT
 3+020 LT - 1EA

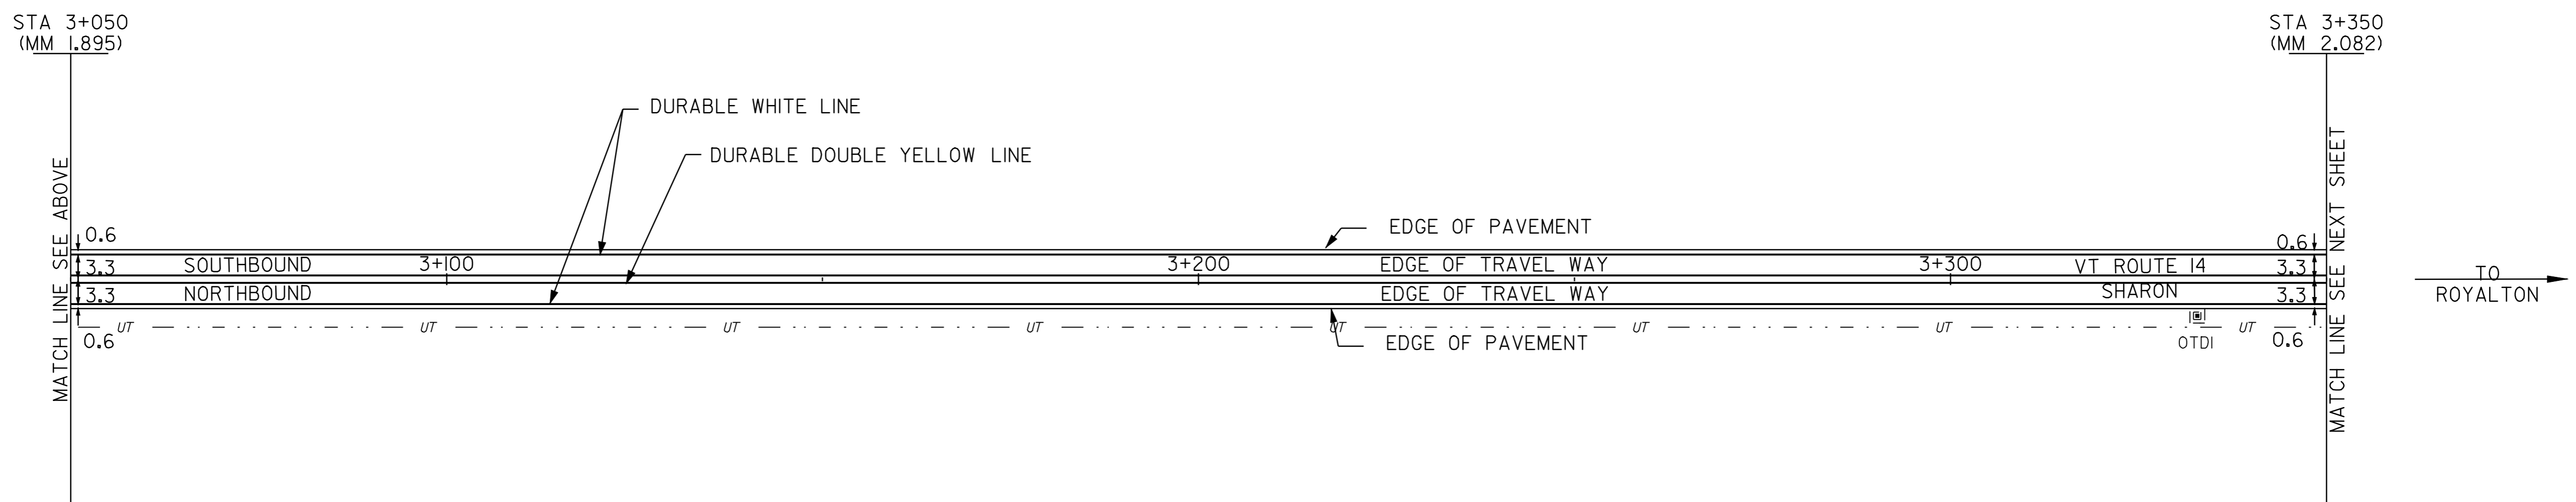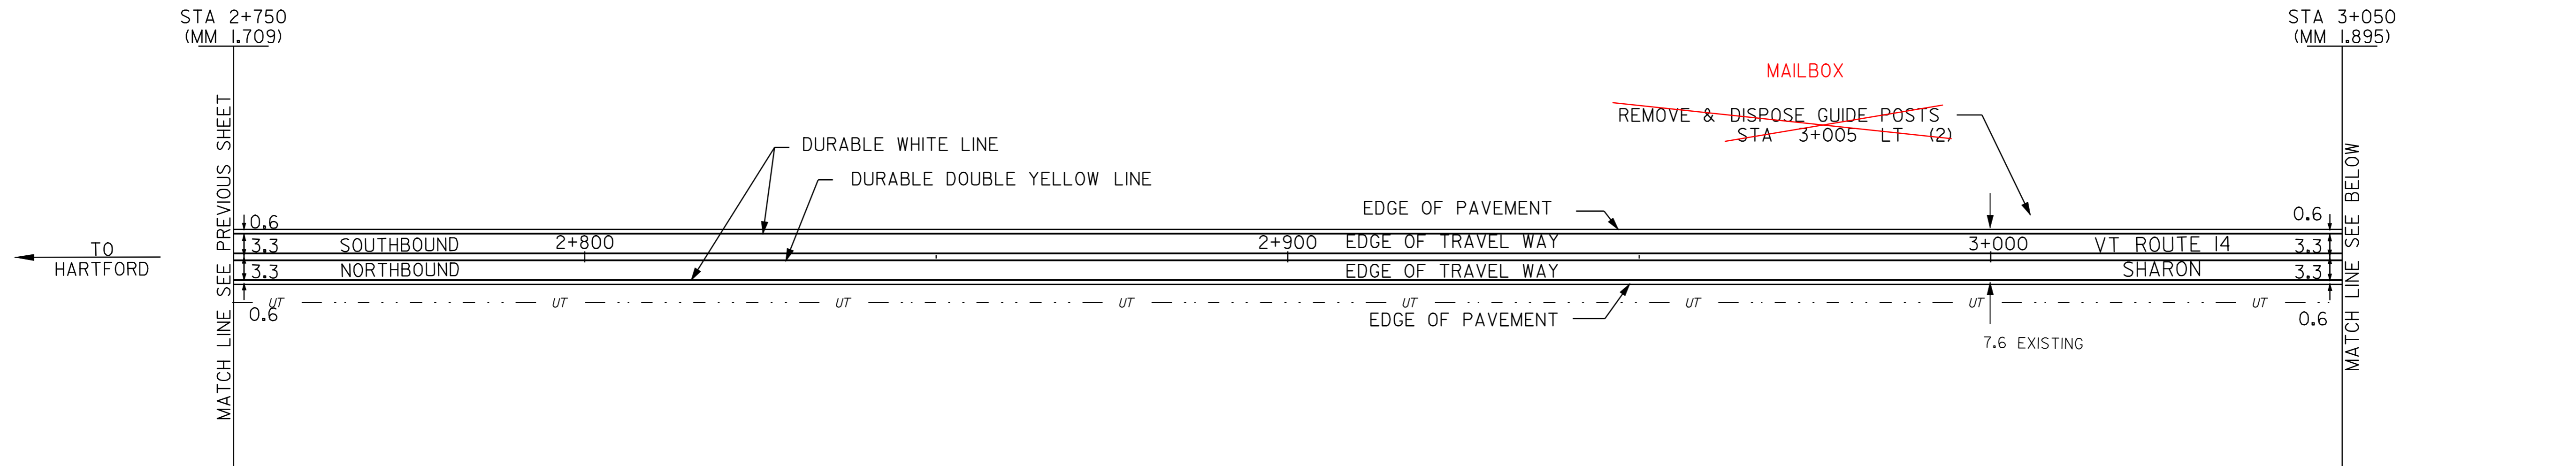

LEGEND

- R = REMOVE EXISTING
- S = SALVAGE
- R&S = REMOVE AND SALVAGE
- N = NEW
- RET = RETAIN
- B-B = BACK TO BACK
- = NEW RAIL
- = EXISTING RAIL
- ⊗ = BORING LOCATION

NOTE: ALL DIMENSIONS IN METERS EXCEPT AS INDICATED

DATUM	
VERTICAL	N/A
HORIZONTAL	N/A

NOT TO SCALE

PAVING PROJECT LAYOUT #23	PROJECT: HARTFORD - ROYALTON	PROJECT NO.: STP 212(K)S
	DESIGN FILE NAME: /pave/98cl74/pcl74.dgn	PLOT DATE: 21-MAR-2007
	IPARM FILE NAME: pcl74i23.i	SURVEY DATE: 8/99
	SURVEYED BY: CLD ENGINEERS INC	DRAWN BY: REB
SQUAD LEADER: WRH	SHEET: 33 OF 64	