

TEMPORARY AND DURABLE 100 mm YELLOW LINE
 STA 3+350 TO 3+846 SOLID LT & RT
 STA 3+846 TO 3+950 DASHED LT, SOLID RT

STEEL BEAM GUARDRAIL 618
 STA 3+535 TO 3+564 LT
~~STA 3+620 TO 3+628 RT~~
 STA 3+620 TO 3+628 LT
 30 38


MANUFACTURED TERMINAL SECTION (FLARED)
 STA 3+524 TO 3+535 LT
~~STA 3+564 TO 3+575 LT~~
~~STA 3+609 TO 3+620 RT~~
~~STA 3+609 TO 3+620 LT~~
 STA 3+628 TO 3+639 RT 41
 STA 3+628 TO 3+639 LT
 38 49

REMOVE & DISPOSE GUARDRAIL
 STA 3+524 TO 3+575 LT
 STA 3+609 TO 3+639 LT
 STA 3+609 TO 3+639 RT

ANCHOR FOR STEEL BEAM
 STA 03+572 RT

TEMPORARY AND DURABLE 100 mm WHITE LINE
 STA 3+350 TO 3+950 SOLID LT & RT

STEEL BEAM GUARDRAIL W/ 2.4m POSTS
 STA 03+618 - 03+630 LT
 STA 03+530 - 03+556 LT
 STA 03+572 - 03+630 RT

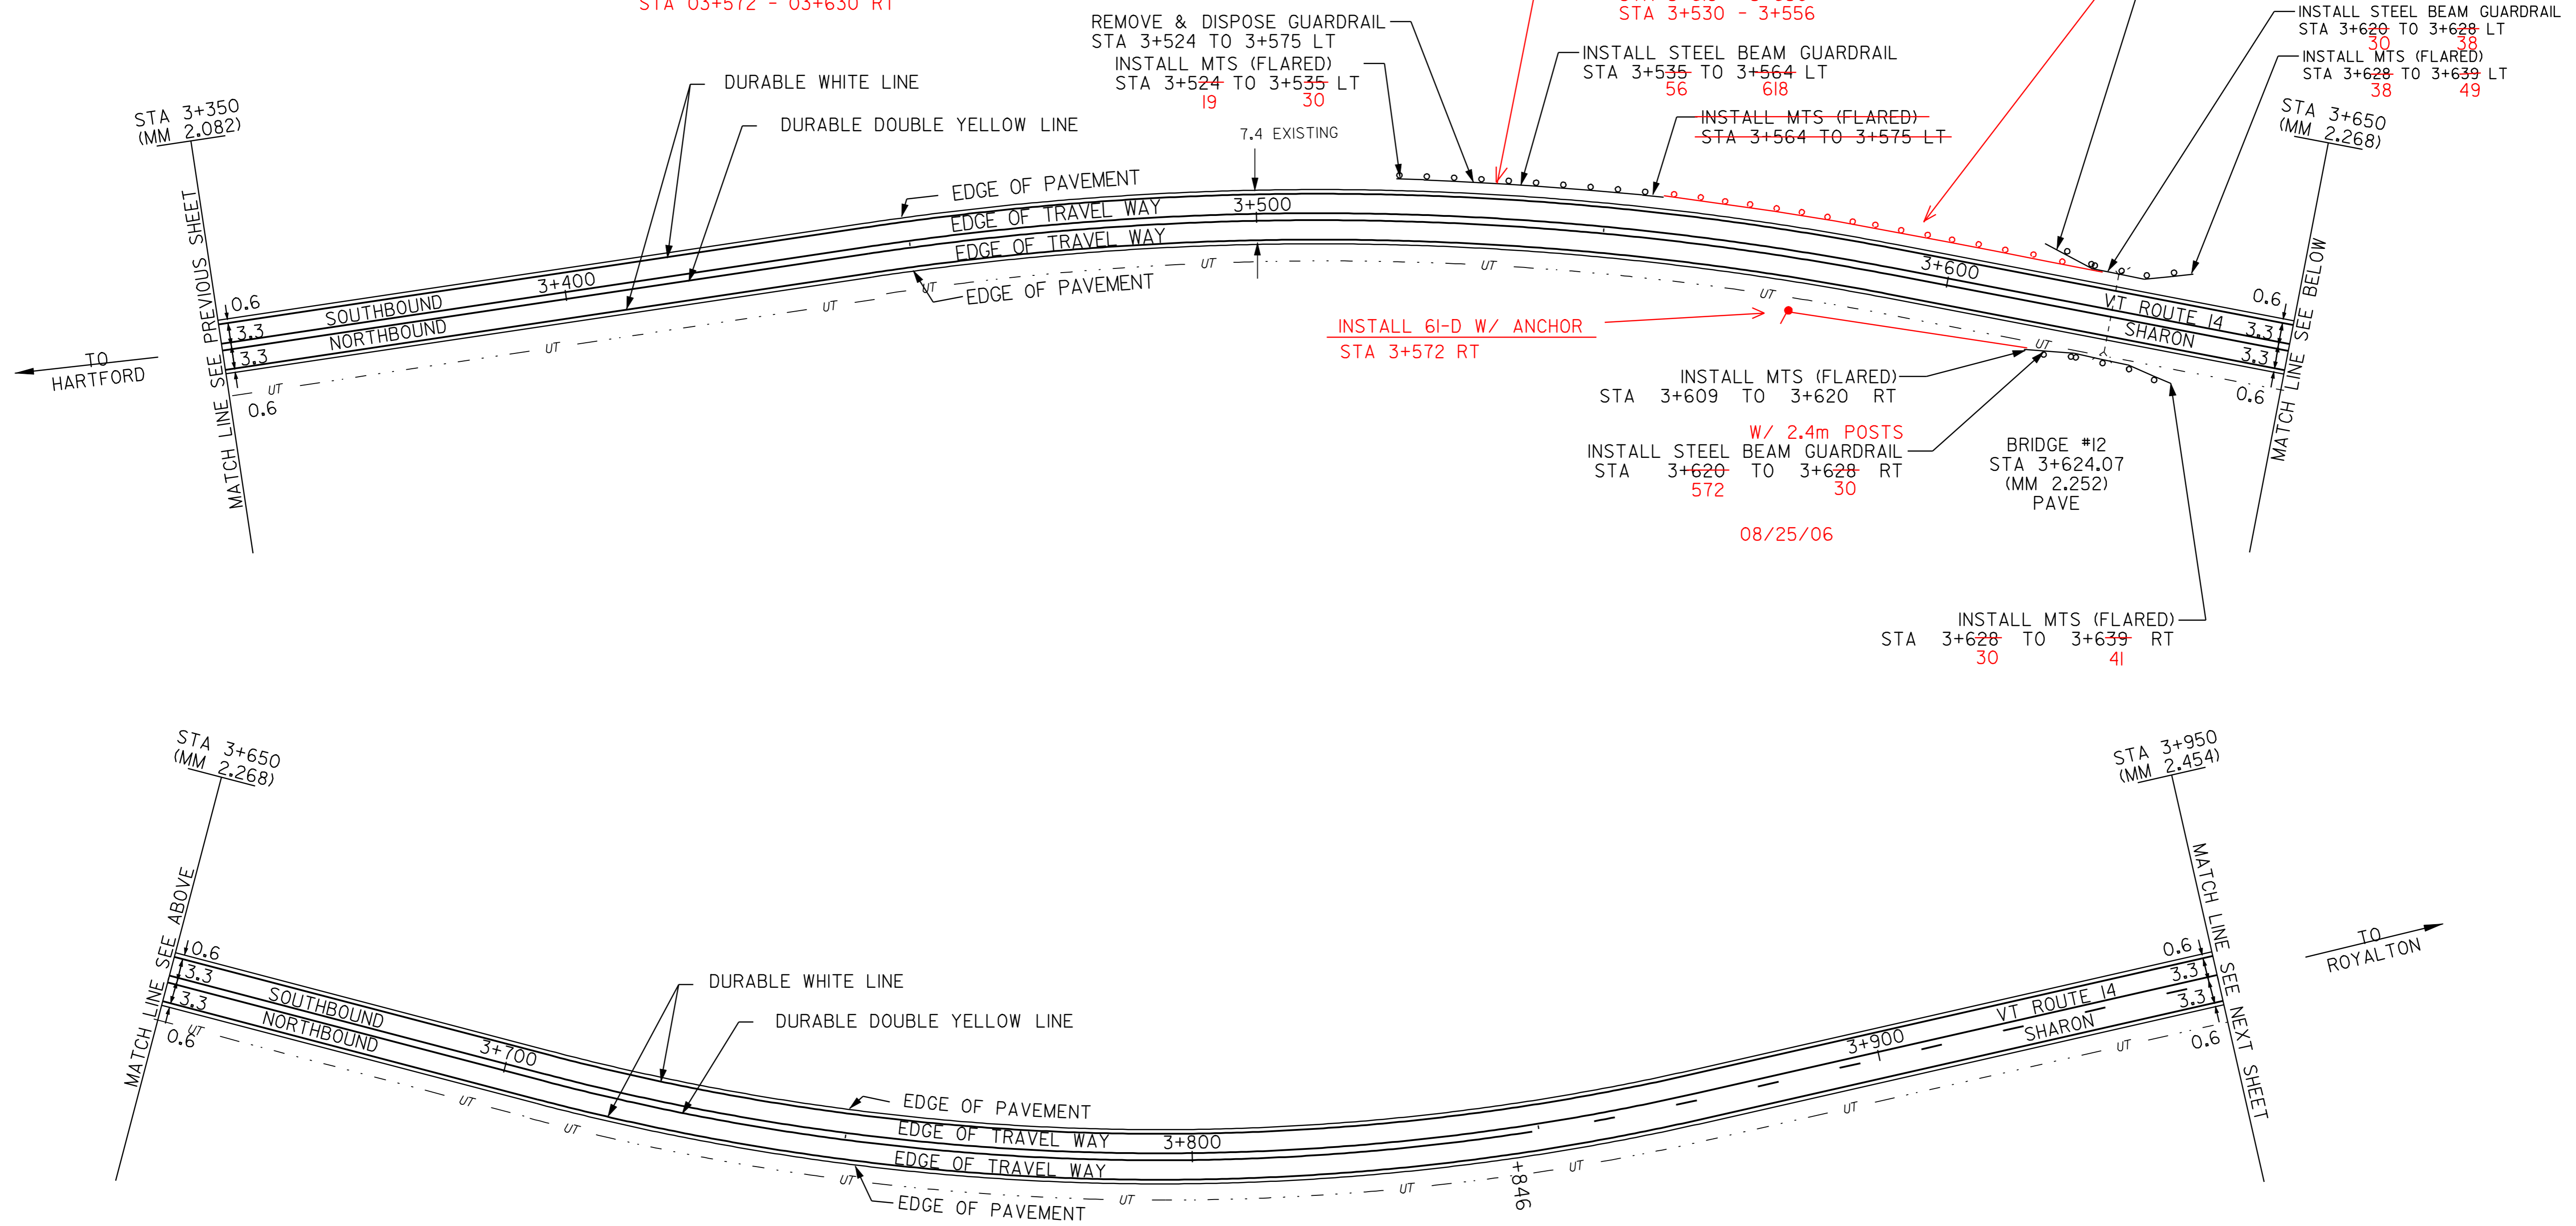

INSTALL 6I-D W/ ANCHOR
 STA 3+572 RT

INSTALL MTS (FLARED)
 STA 3+609 TO 3+620 RT
 W/ 2.4m POSTS
 INSTALL STEEL BEAM GUARDRAIL
 STA 3+620 TO 3+628 RT
 572 30

INSTALL MTS (FLARED)
 STA 3+628 TO 3+639 RT
 30 41

BRIDGE #12
 STA 3+624.07
 (MM 2.252)
 PAVE

08/25/06

LEGEND

- R = REMOVE EXISTING
- S = SALVAGE
- R&S = REMOVE AND SALVAGE
- N = NEW
- RET = RETAIN
- B-B = BACK TO BACK
- = NEW RAIL
- - - = EXISTING RAIL
- ⊗ = BORING LOCATION

NOTE: ALL DIMENSIONS IN METERS EXCEPT AS INDICATED

DATUM	
VERTICAL	N/A
HORIZONTAL	N/A

NOT TO SCALE

PAVING PROJECT LAYOUT #24

PROJECT: HARTFORD - ROYALTON	PROJECT NO. : STP 212(K)S
DESIGN FILE NAME: /pave/98ci74/pcl74.dgn	PLOT DATE: 21-MAR-2007
IPARM FILE NAME: pcl74i24.i	SURVEY DATE: 8/99
SURVEYED BY: CLD_ENGINEERS_INC	DRAWN BY: REB
SQUAD LEADER: WRH	SHEET: 34 OF 64