
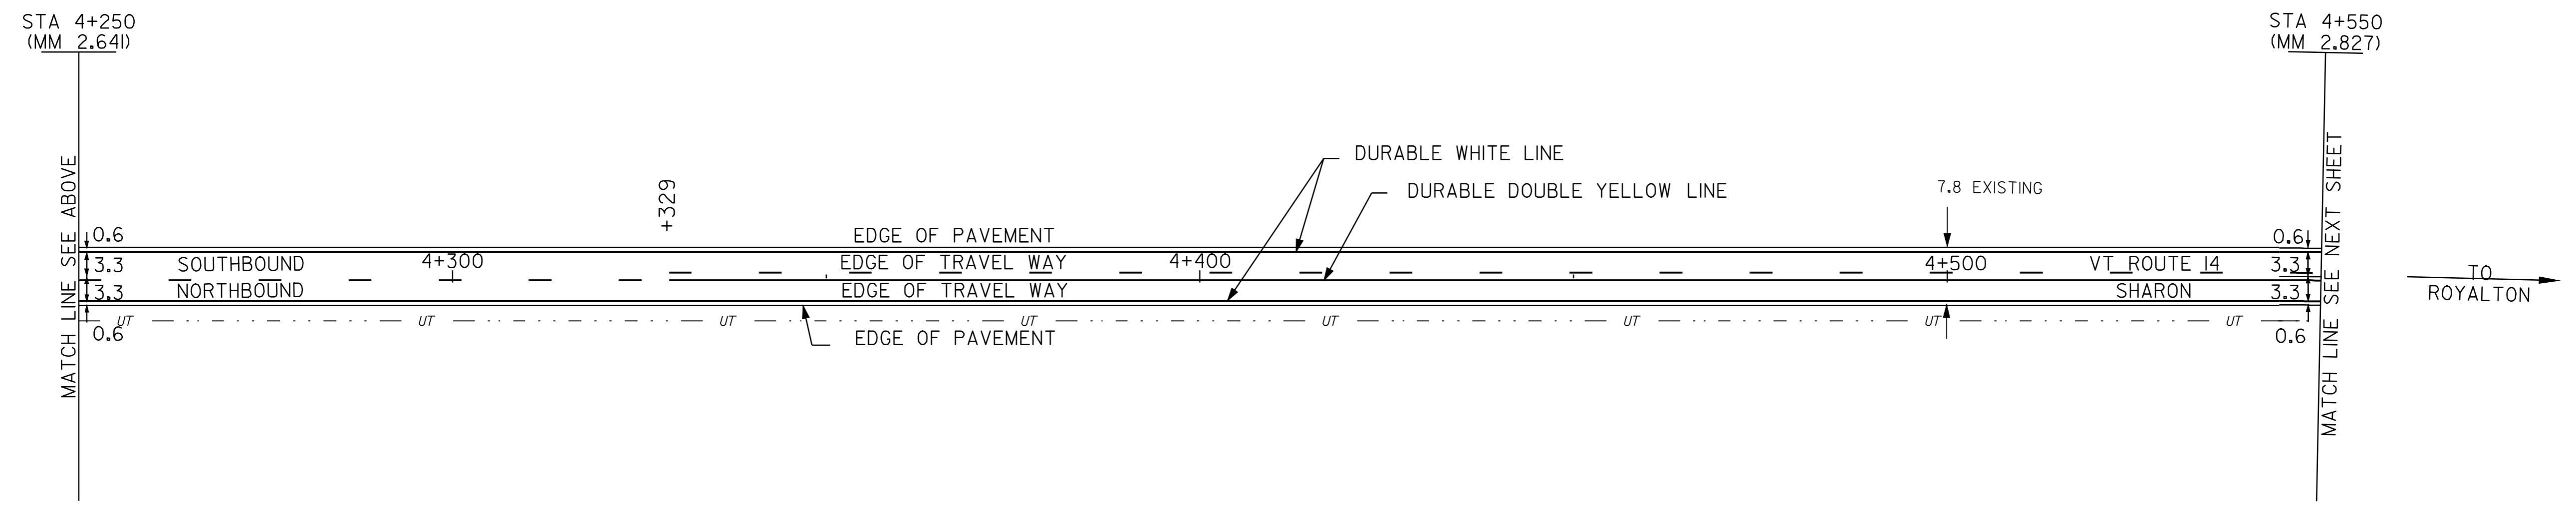


TEMPORARY AND DURABLE 100 mm YELLOW LINE  
 STA 3+950 TO 4+088 SOLID LT, DASHED RT  
 STA 4+088 TO 4+329 DASHED  
 STA 4+329 TO 4+550 DASHED LT, SOLID RT

TEMPORARY AND DURABLE 100 mm WHITE LINE  
 STA 3+950 TO 4+550 SOLID LT & RT

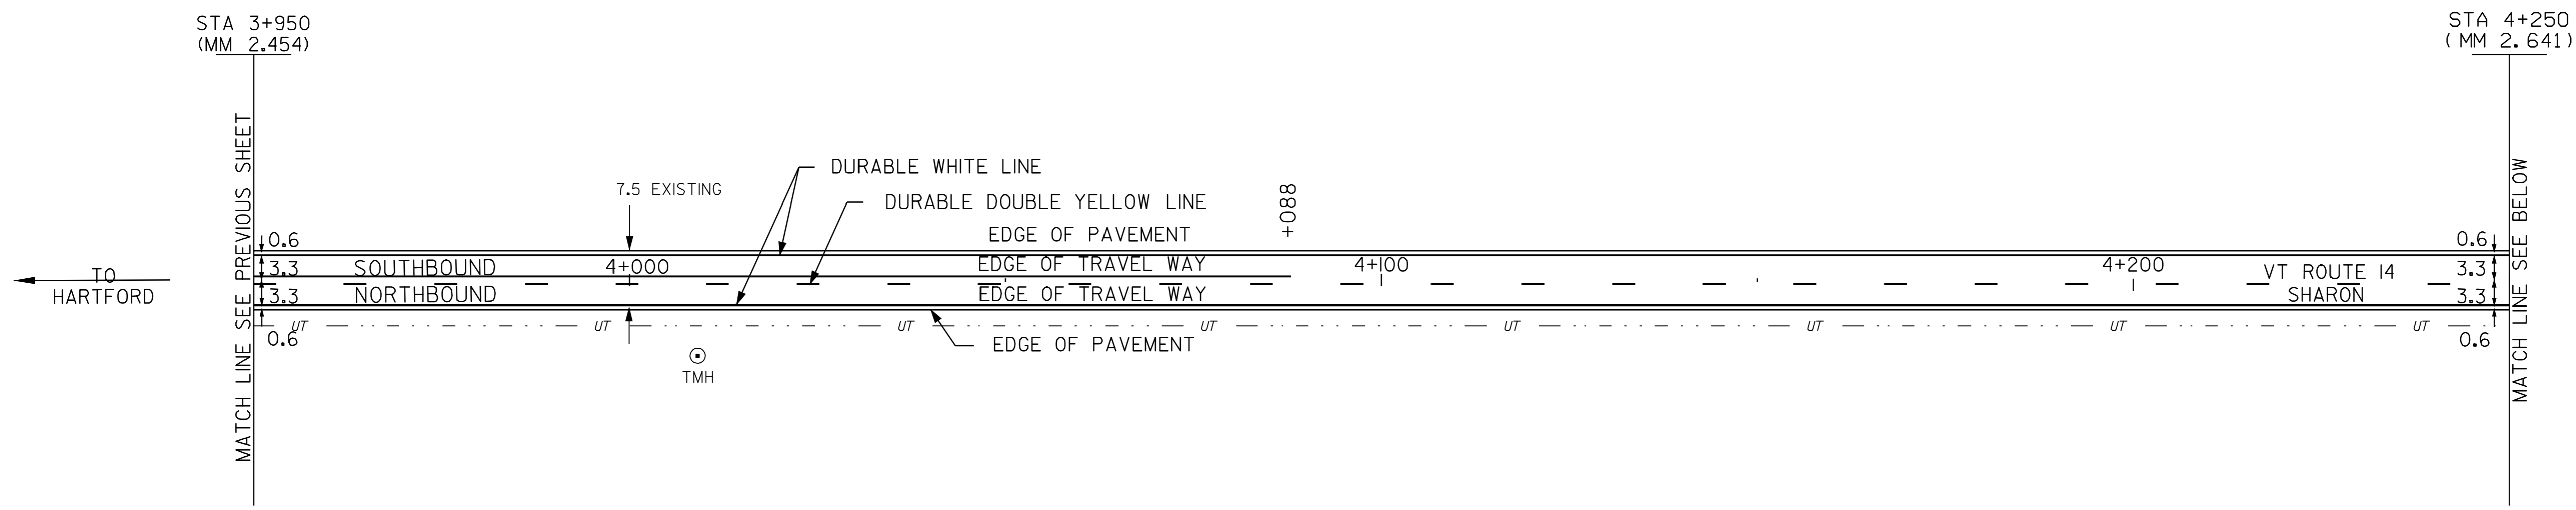

LEGEND

- R = REMOVE EXISTING
- S = SALVAGE
- R&S = REMOVE AND SALVAGE
- N = NEW
- RET = RETAIN
- B-B = BACK TO BACK
- = NEW RAIL
- - - = EXISTING RAIL
- ⊗ = BORING LOCATION

NOTE: ALL DIMENSIONS IN METERS EXCEPT AS INDICATED

|            |     |
|------------|-----|
| DATUM      |     |
| VERTICAL   | N/A |
| HORIZONTAL | N/A |

NOT TO SCALE

**PAVING PROJECT LAYOUT #25**

|  |                             |
|--|-----------------------------|
| PROJECT:<br>HARTFORD - ROYALTON          | PROJECT NO.:<br>STP 212(I)S |
| DESIGN FILE NAME: /pave/98ci74/pol74.dgn | PLOT DATE: 21-MAR-2007      |
| IPARM FILE NAME: pol74i25.i              | SURVEY DATE: 8/99           |
| SURVEYED BY: CLD ENGINEERS INC           | DRAWN BY: REB               |
| SQUAD LEADER: WRH                        | SHEET: 35 OF 64             |