


TEMPORARY AND DURABLE 100 mm YELLOW LINE
 STA 6+900 TO 7+500 SOLID LT & RT
 TEMPORARY AND DURABLE 100 mm WHITE LINE
 STA 6+900 TO 7+500 SOLID LT & RT


RELOCATE MAILBOX - ~~MULTIPLE~~ SINGLE SUPPORT
 STA 7+486 RT - 2 EACH
 80

MANUFACTURED TERMINAL SECTION (FLARED)
 STA 6+901 TO 6+912 LT

REMOVE & DISPOSE GUARDRAIL
 STA 6+901 TO 6+912 LT

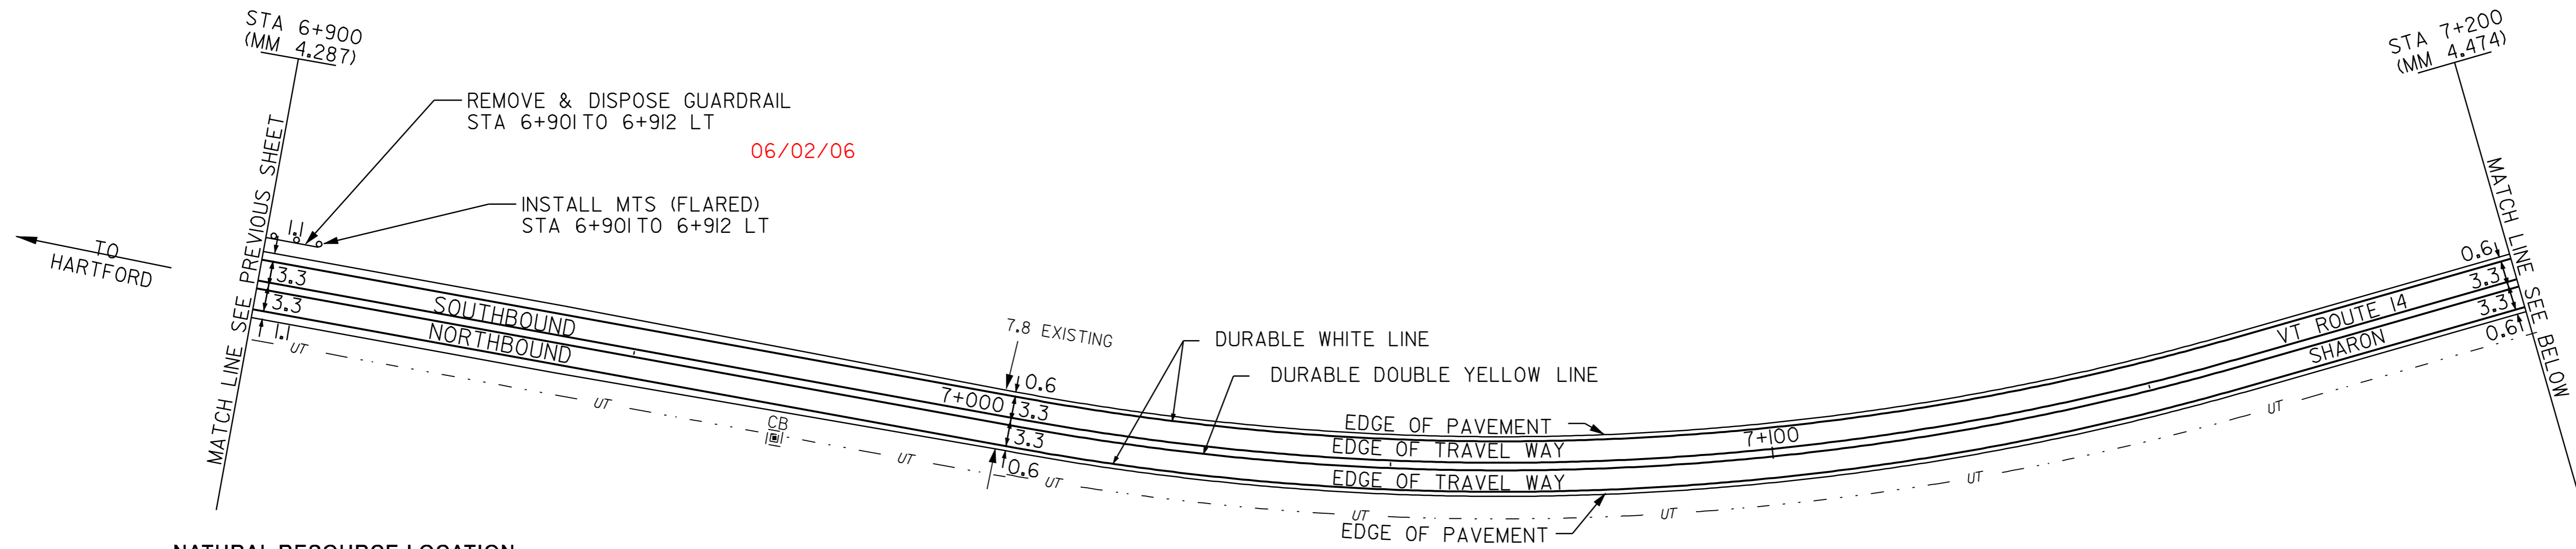

NATURAL RESOURCE LOCATION
 STA 3+399 - 3+510 LT--WETLAND III--TOE OF SLOPE
 STA 3+565 LT--WETLAND III--TOE OF SLOPE
 STA 3+603 RT--WETLAND III--TOE OF SLOPE
 STA 3+621 LT--WETLAND III--TOE OF SLOPE
 STA 3+829 LT--WETLAND III--TOE OF SLOPE

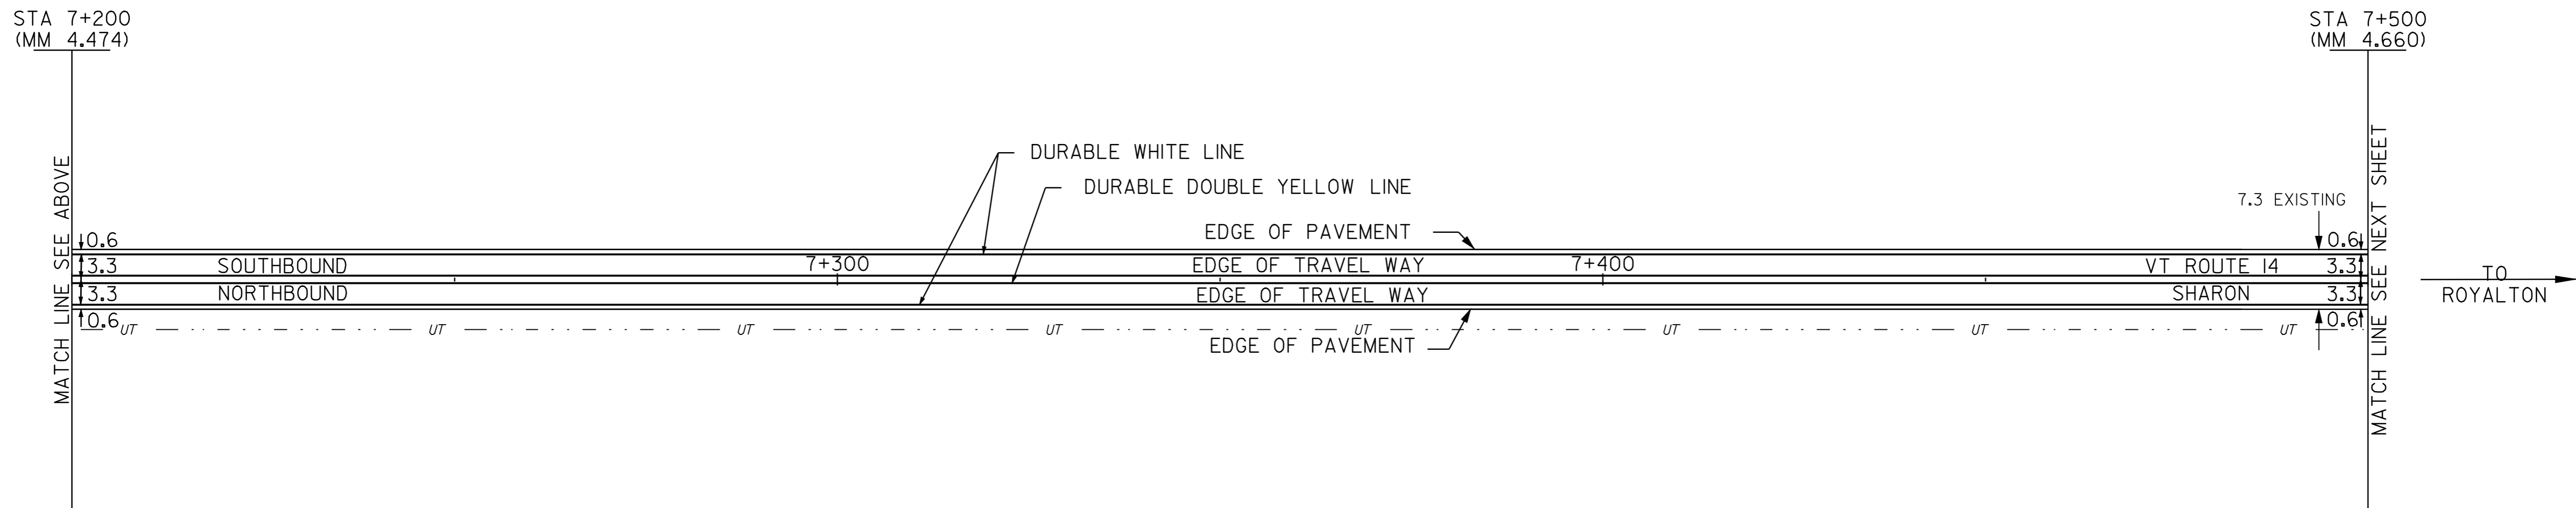

LEGEND

- R = REMOVE EXISTING
- S = SALVAGE
- R&S = REMOVE AND SALVAGE
- N = NEW
- RET = RETAIN
- B-B = BACK TO BACK
- = NEW RAIL
- - - = EXISTING RAIL
- ⊗ = BORING LOCATION

NOTE: ALL DIMENSIONS IN METERS EXCEPT AS INDICATED

DATUM	
VERTICAL	N/A
HORIZONTAL	N/A

NOT TO SCALE

**PAVING
 PROJECT
 LAYOUT #30**

PROJECT: HARTFORD - ROYALTON	PROJECT NO. : STP 212(I)S
DESIGN FILE NAME: /pave/98cl74/pci74.dgn	PLOT DATE: 21-MAR-2007
IPARM FILE NAME: pci74i30.i	SURVEY DATE: 8/99
SURVEYED BY: CLD ENGINEERS INC	DRAWN BY: REB
SQUAD LEADER: WRH	SHEET: 40 OF 64