

TEMPORARY AND DURABLE 100 mm YELLOW LINE
 STA 7+500 TO 8+061 SOLID LT & RT
 STA 8+067 DOUBLE SOLID RT (VT ROUTE 132)
 STA 8+073 TO 8+100 SOLID LT & RT

TEMPORARY AND DURABLE 100 mm WHITE LINE
 STA 7+500 TO 8+100 SOLID LT
 STA 7+500 TO 8+055 SOLID RT
 STA 8+079 TO 8+100 SOLID RT

STEEL BEAM GUARDRAIL
 STA 7+782.4 TO 7+812.00 LT
 STA 7+782 TO 7+812.08 RT

REMOVAL & DISP. OF GUARDRAIL
 STA 7+774 TO 7+812 RT
 STA 7+792 TO 7+812 LT
 STA 7+860 TO 7+871 LT
 STA 7+964 TO 7+975 LT

ANCHOR FOR STEEL BEAM RAIL
 STA 7+782 RT 84
 STA 7+782 LT
~~STA 7+812 LT~~
 STA 7+812.08 RT
 7+975 LT

RELOCATE MAILBOX - SINGLE SUPPORT
 STA 7+545 RT



MANUFACTURED TERMINAL SECTION (FLARED)
 STA 7+860 TO 7+871 LT
 STA 7+964 TO 7+975 LT
 7+800 TO 7+811 LT

SHOULDER BERM REMOVAL
 STA 7+871 TO 7+964 LT

STEE

**CHANGING ELEV. OF DI, CB OR MH
 REHABILITATION OF DI, CB OR MH**
 STA 7+883 LT
 STA 7+883 RT OTDI
 STA 7+930 RT
 STA 7+990 RT OTDI
 STA 7+998 RT CB REHAB, TYPE E GRATE
 STA 8+024 LT

**BITUMINOUS CONCRETE
 GUTTER AND TRAFFIC ISLAND**
 STA 7+883 TO 7+930 LT
 STA 7+998 TO 8+025 RT
 STA 8+024 TO 8+025 LT

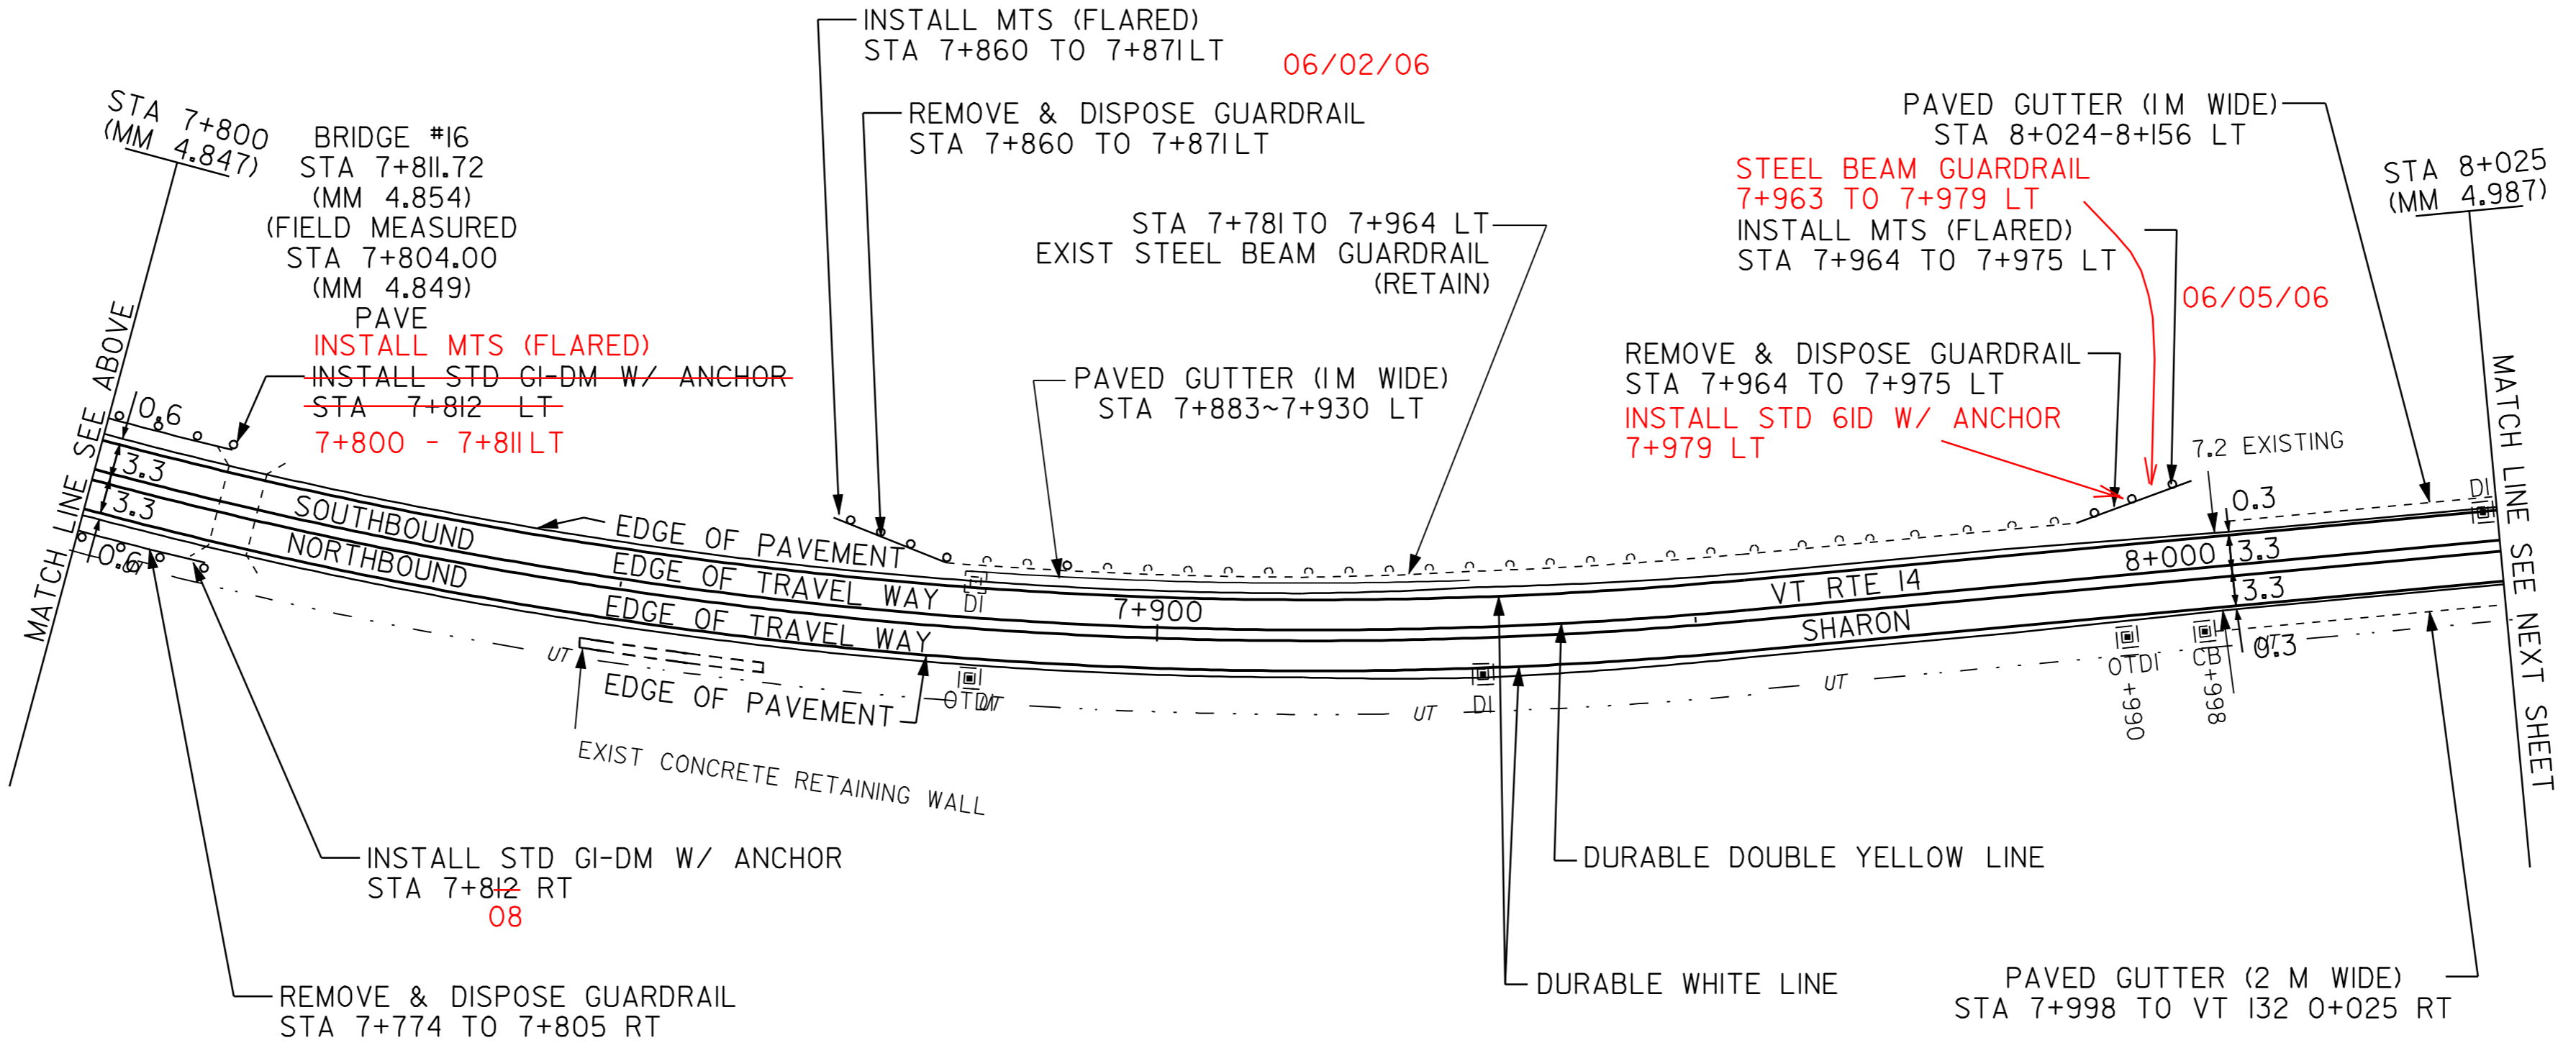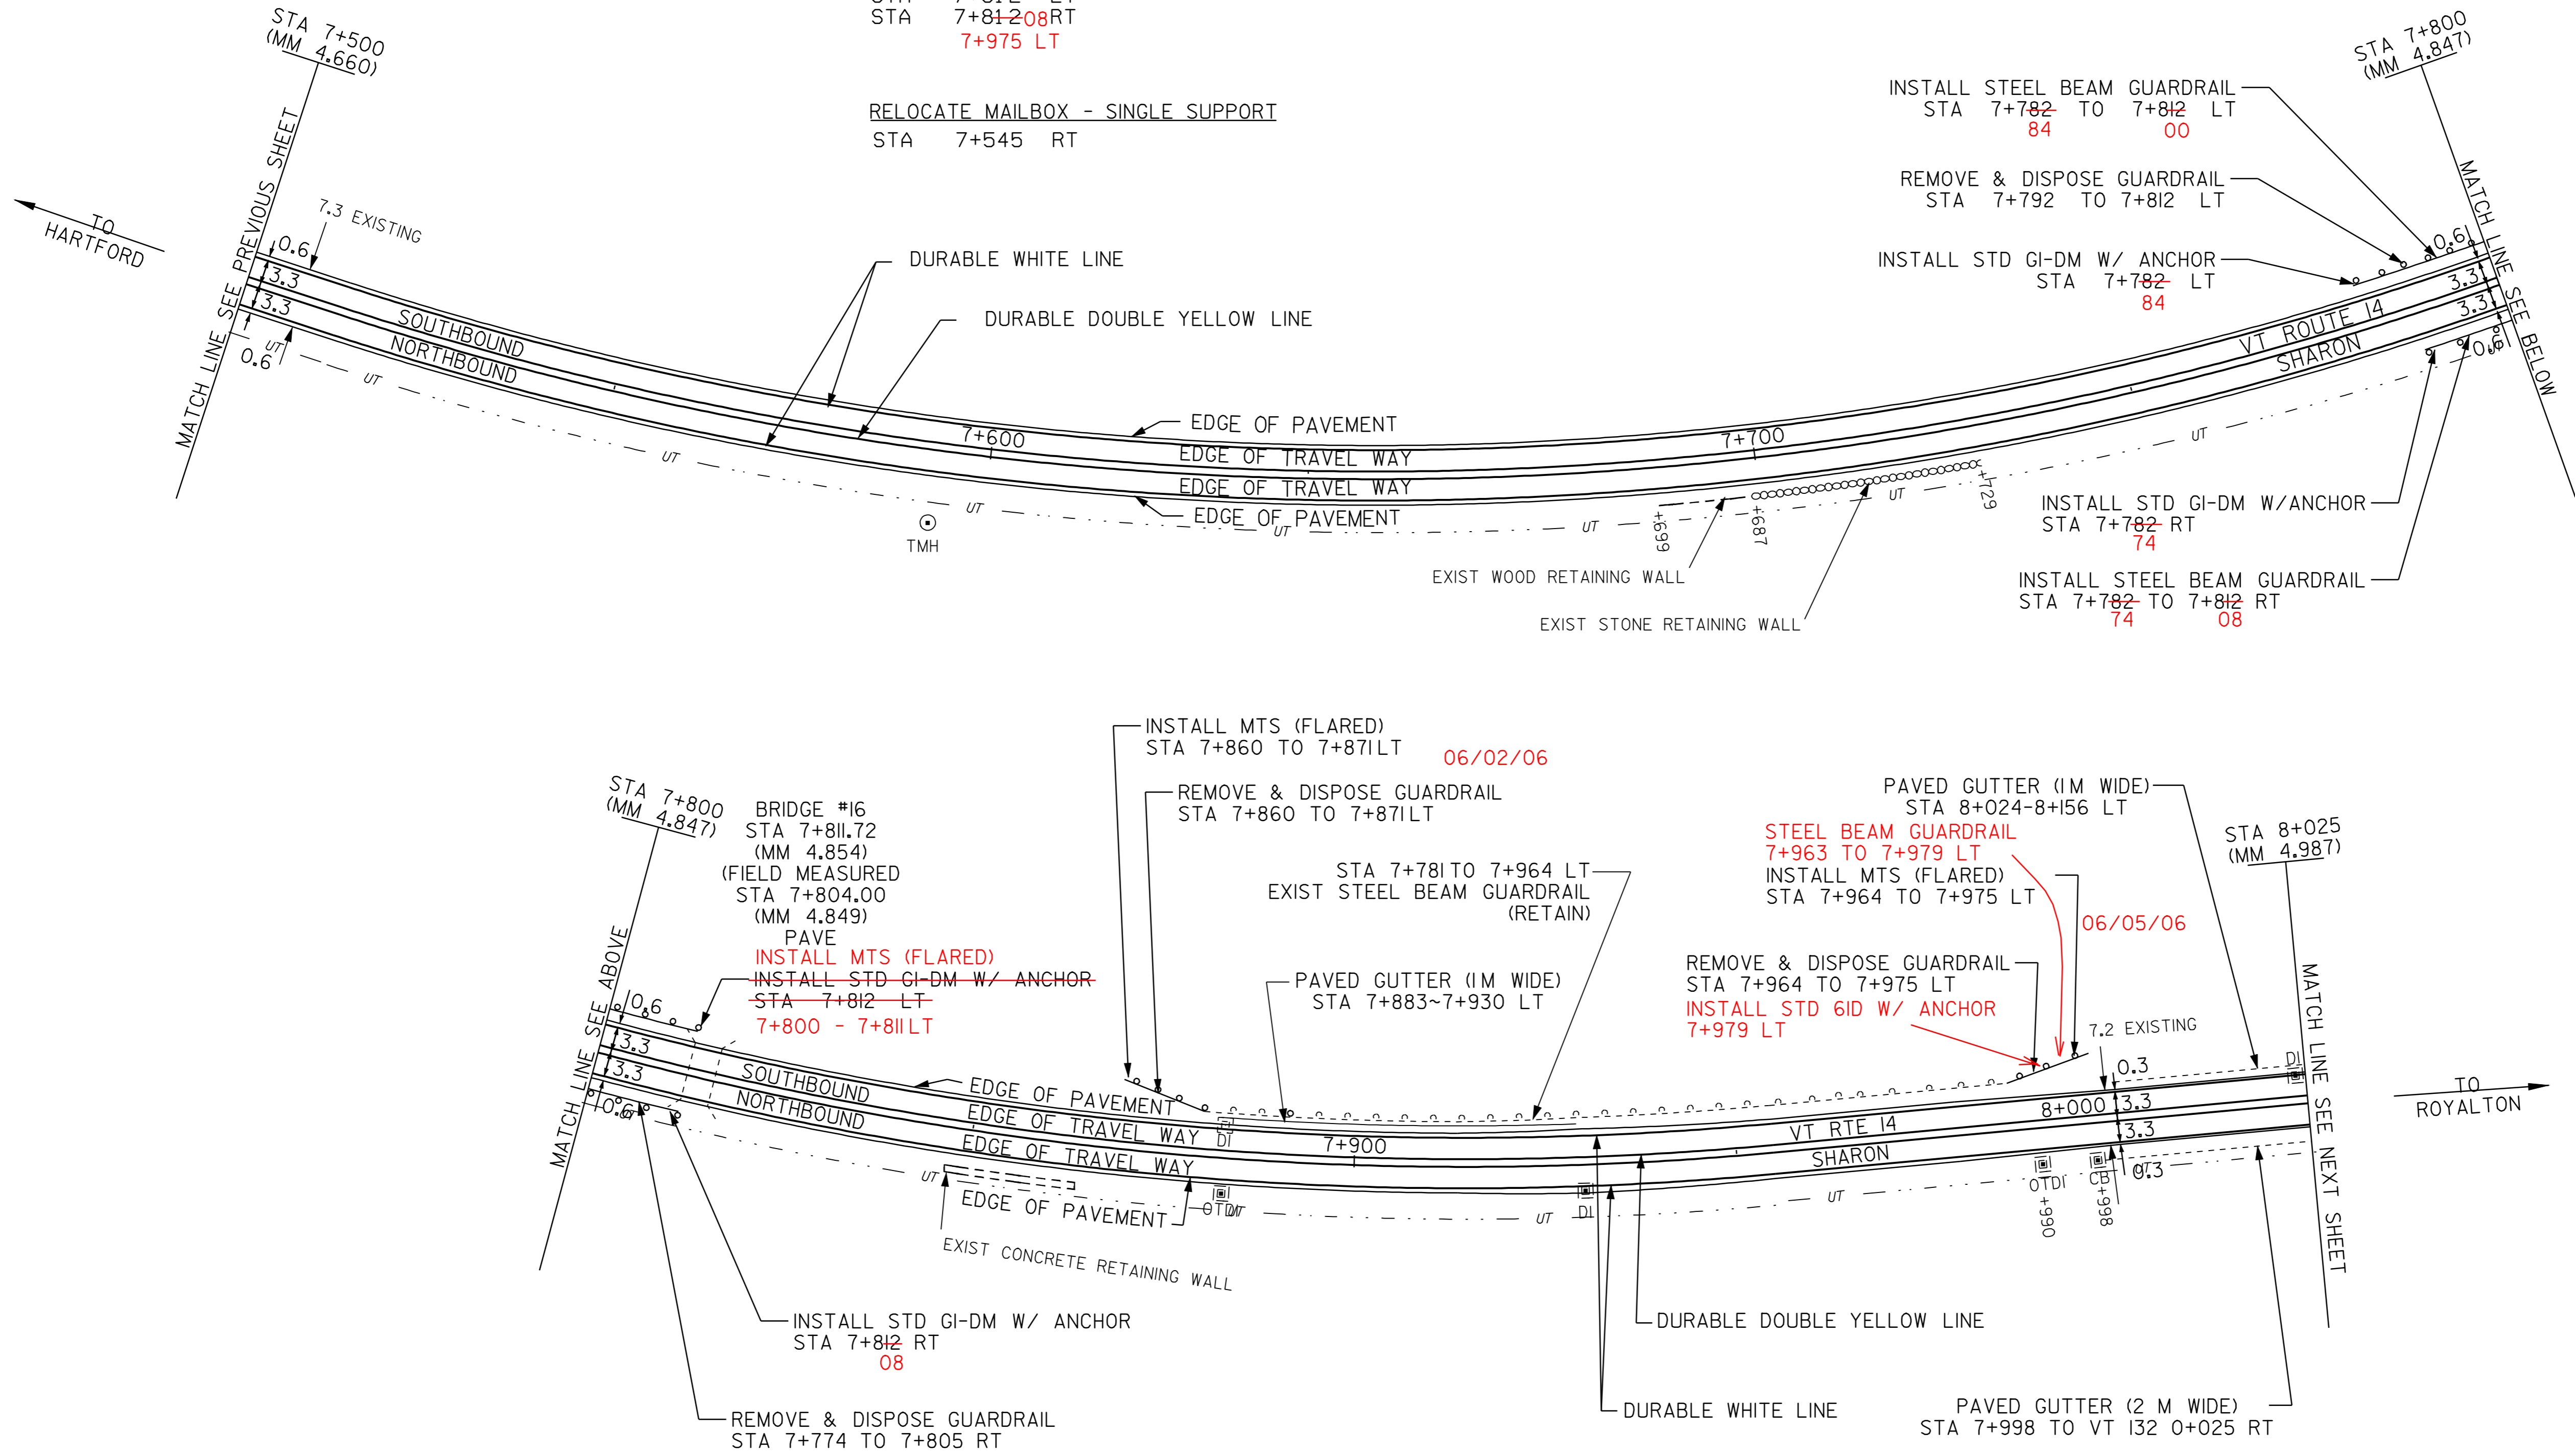

- LEGEND**
- R = REMOVE EXISTING
 - S = SALVAGE
 - R&S = REMOVE AND SALVAGE
 - N = NEW
 - RET = RETAIN
 - B-B = BACK TO BACK
 - = NEW RAIL
 - - - = EXISTING RAIL
 - ⊗ = BORING LOCATION

NOTE: ALL DIMENSIONS IN METERS EXCEPT AS INDICATED

DATUM	
VERTICAL	N/A
HORIZONTAL	N/A

NOT TO SCALE

PAVING PROJECT LAYOUT #31	PROJECT: HARTFORD - ROYALTON	PROJECT NO.: STP 212(1)S
	DESIGN FILE NAME: /pave/98cl14/pcl74.dgn	PLOT DATE: 21-MAR-2007
	IPARM FILE NAME: pcl74i31	SURVEY DATE: 8/99
	SURVEYED BY: CLD_ENGINEERS_INC	DRAWN BY: REB
SQUAD LEADER: WRH	SHEET: 41 OF 64	