
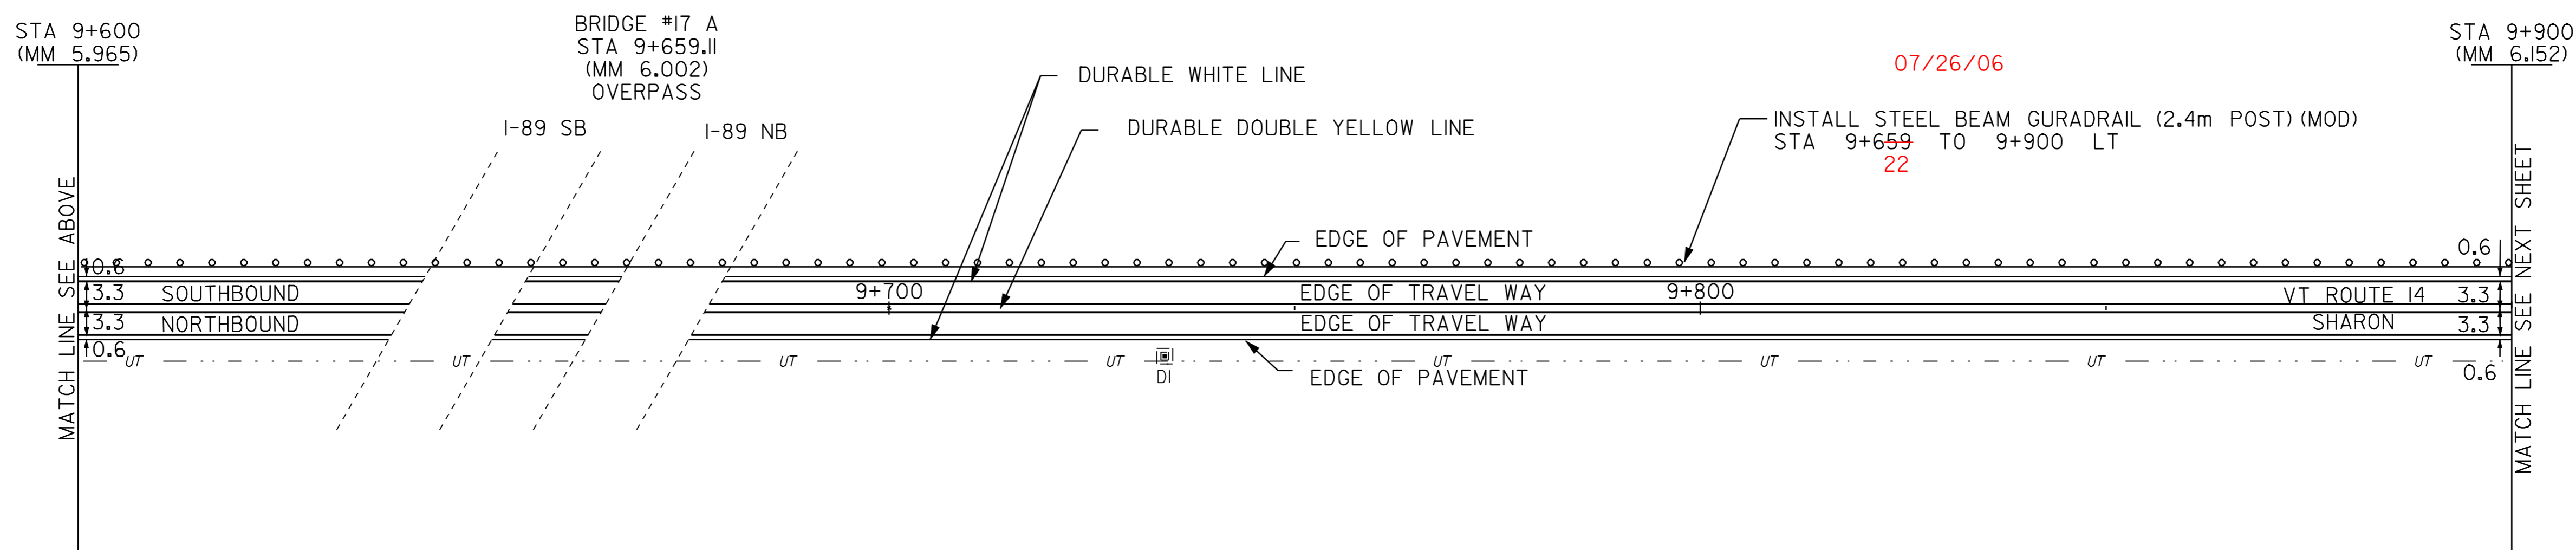


TEMPORARY AND DURABLE 100 MM YELLOW LINE  
 STA 9+300 TO 9+900 SOLID LT & RT  
 TEMPORARY AND DURABLE 100 mm WHITE LINE  
 STA 9+300 TO 9+900 SOLID LT & RT

STEEL BEAM GUARDRAIL (2.4m POST)(MOD)  
 STA 9+659 TO 9+900 LT  
 STEEL BEAM GUARDRAIL  
 STA 9+561 TO 9+659 LT  
 MANUFACTURED TERMINAL SECTION (FLARED)  
 STA 9+550 TO 9+561 LT

MULTIPLE  
 RELOCATE MAILBOX - SINGLE SUPPORT  
 STA 9+770 RT

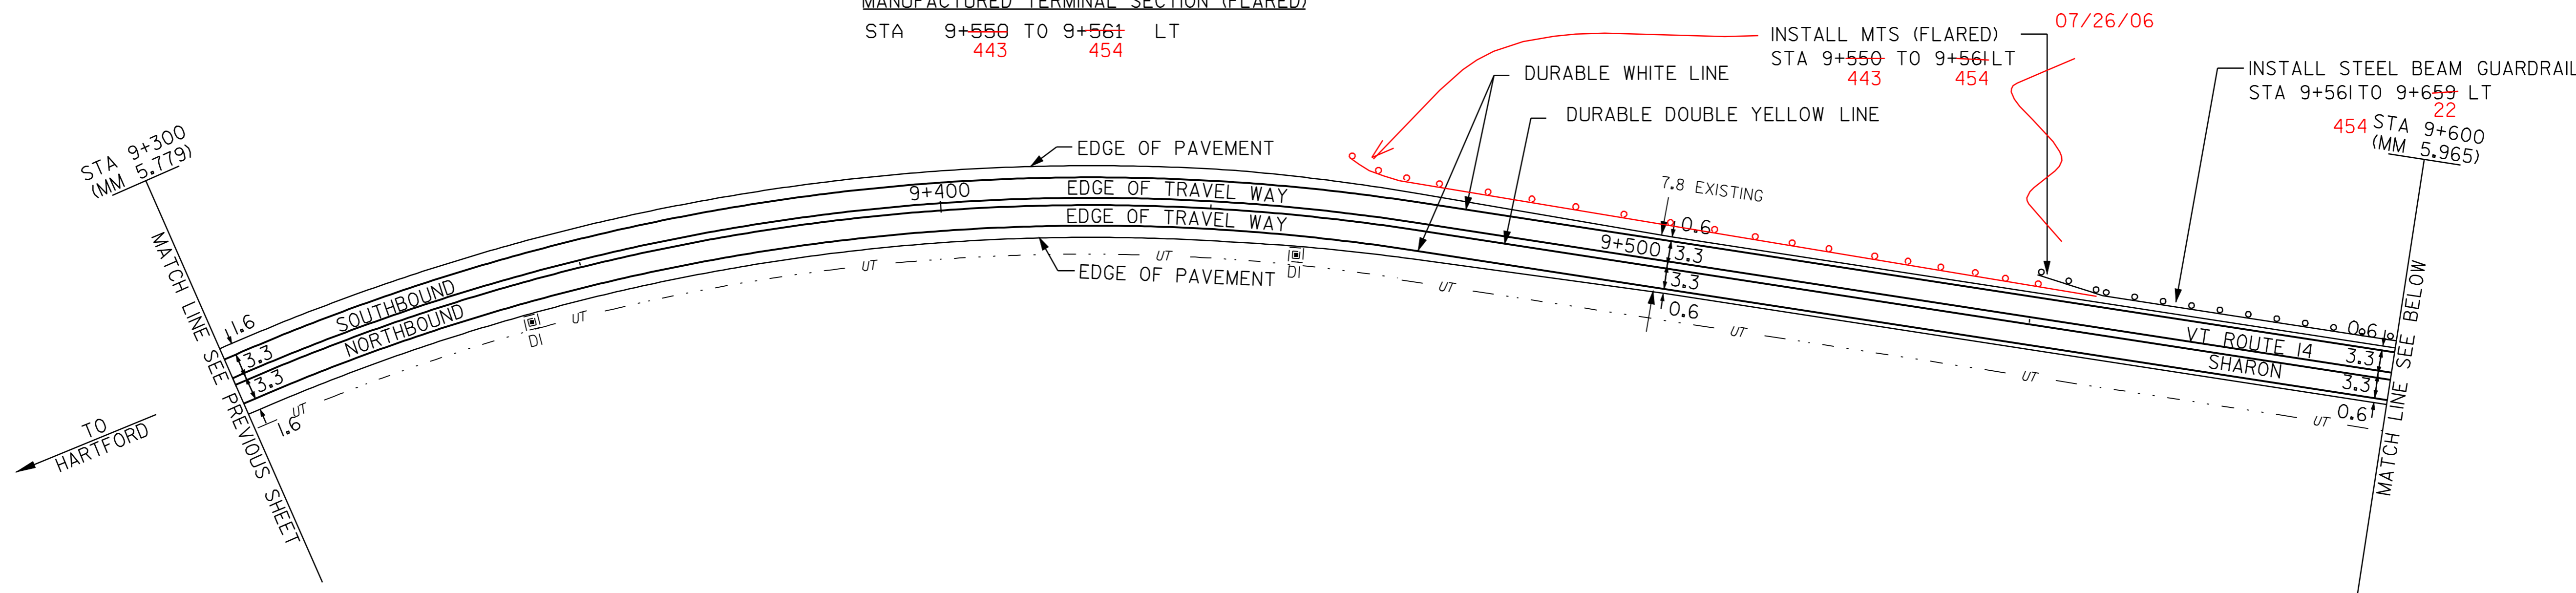

- LEGEND**
- R = REMOVE EXISTING
  - S = SALVAGE
  - R&S = REMOVE AND SALVAGE
  - N = NEW
  - RET = RETAIN
  - B-B = BACK TO BACK
  - = NEW RAIL
  - - - = EXISTING RAIL
  - ⊗ = BORING LOCATION

NOTE: ALL DIMENSIONS IN METERS EXCEPT AS INDICATED

DATUM	
VERTICAL	N/A
HORIZONTAL	N/A

NOT TO SCALE

**PAVING PROJECT LAYOUT #35**

PROJECT: HARTFORD - ROYALTON	PROJECT NO.: STP 212(1)S
DESIGN FILE NAME: /pave/98cl74/pcl74.dgn	PLOT DATE: 21-MAR-2007
IPARM FILE NAME: pcl74135.1	SURVEY DATE: 8/99
SURVEYED BY: CLD ENGINEERS INC	DRAWN BY: REB
SQUAD LEADER: WRH	SHEET: 45 OF 64