



TEMPORARY AND DURABLE 100 mm YELLOW LINE
 STA 9+900 TO 10+450 SOLID LT & RT
 TEMPORARY AND DURABLE 100 mm WHITE LINE
 STA 9+900 TO 10+450 SOLID LT & RT

STEEL BEAM GUARDRAIL (2.4m POST) (MOD)
 STA ~~9+900~~ TO 10+450 LT
 10+182
 9+900 - 10+140 LT

REMOVAL & DISP. OF GUARDRAIL
 STA 9+924 TO 10+034 LT
 STA 10+360 TO 10+450 LT

(FLARED)
 STA 10+170 - 10+182 LT

STEEL BEAM GUARDRAIL
 STA 10+140 - 10+155 RT

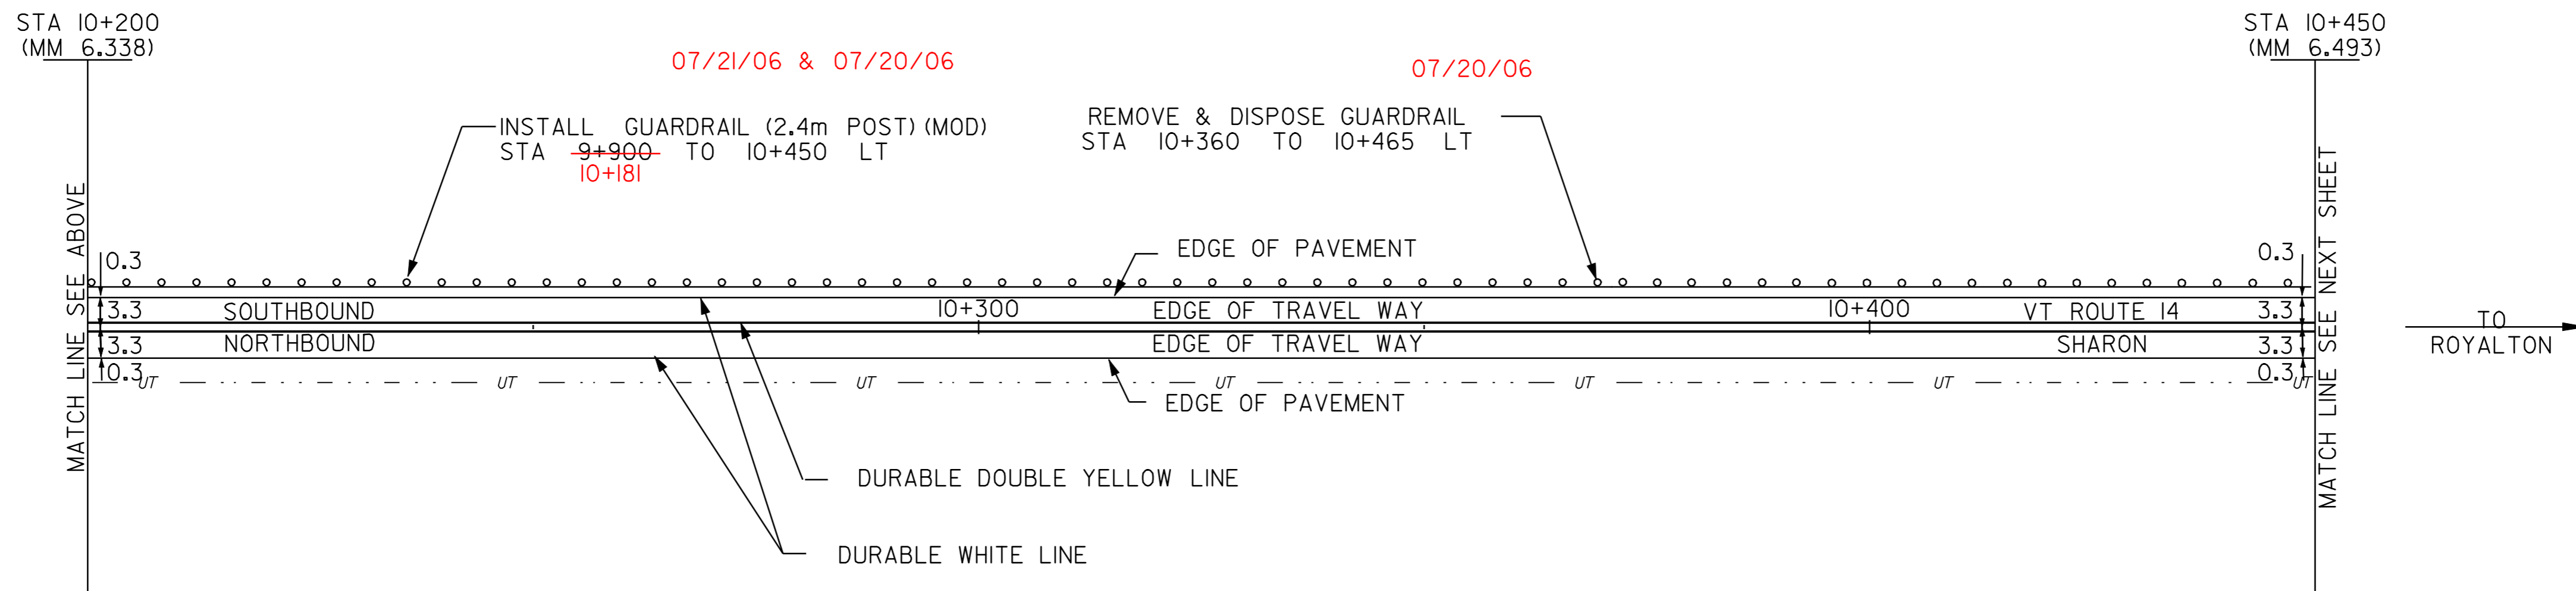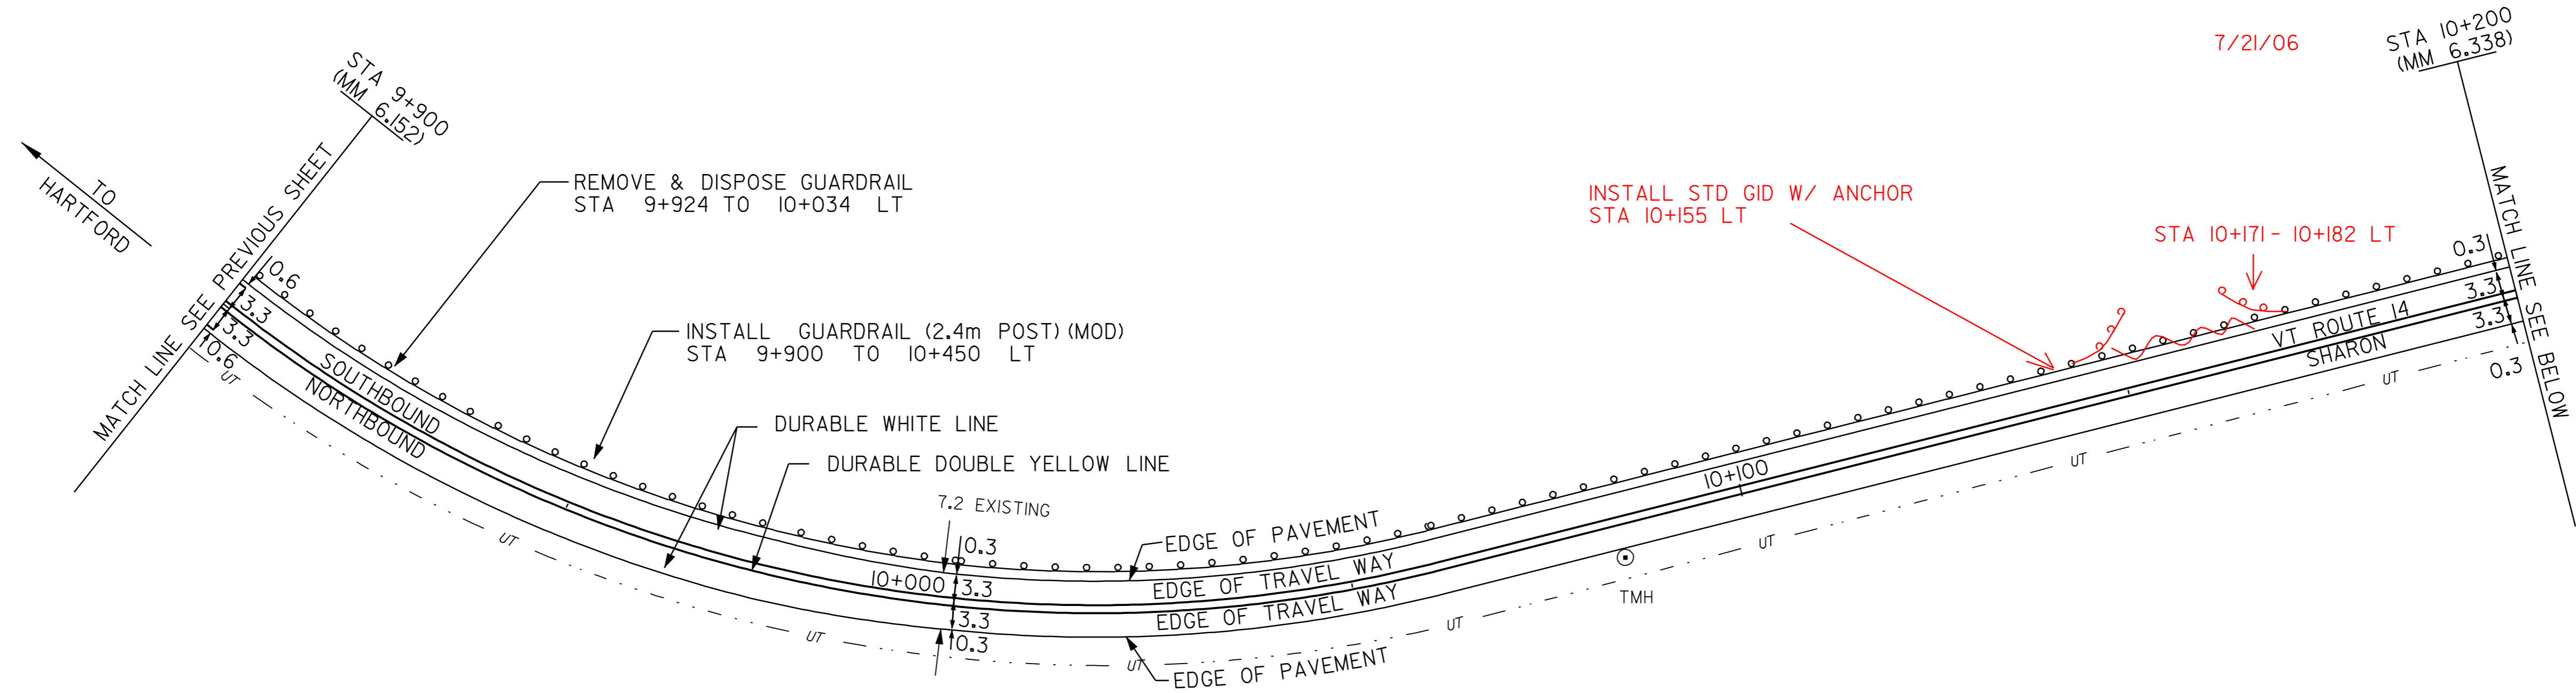

LEGEND

- R = REMOVE EXISTING
- S = SALVAGE
- R&S = REMOVE AND SALVAGE
- N = NEW
- RET = RETAIN
- B-B = BACK TO BACK
- = NEW RAIL
- - - = EXISTING RAIL
- ⊗ = BORING LOCATION

NOTE: ALL DIMENSIONS IN METERS EXCEPT AS INDICATED

| | |
|------------|-----|
| DATUM | |
| VERTICAL | N/A |
| HORIZONTAL | N/A |

NOT TO SCALE

PAVING PROJECT LAYOUT #36

| | |
|--|-----------------------------|
| PROJECT: HARTFORD - ROYALTON | PROJECT NO.: STP 212(1)S |
| DESIGN FILE NAME: /pave/98cl74/pci74.dgn | PLOT DATE: 21-MAR-2007 |
| IPARM FILE NAME: pci74136.1 | SURVEY DATE: 8/99 |
| SURVEYED BY: CLD ENGINEERS INC | DRAWN BY: REB |
| SQUAD LEADER: WRH | SHEET: 46 OF 64 |