
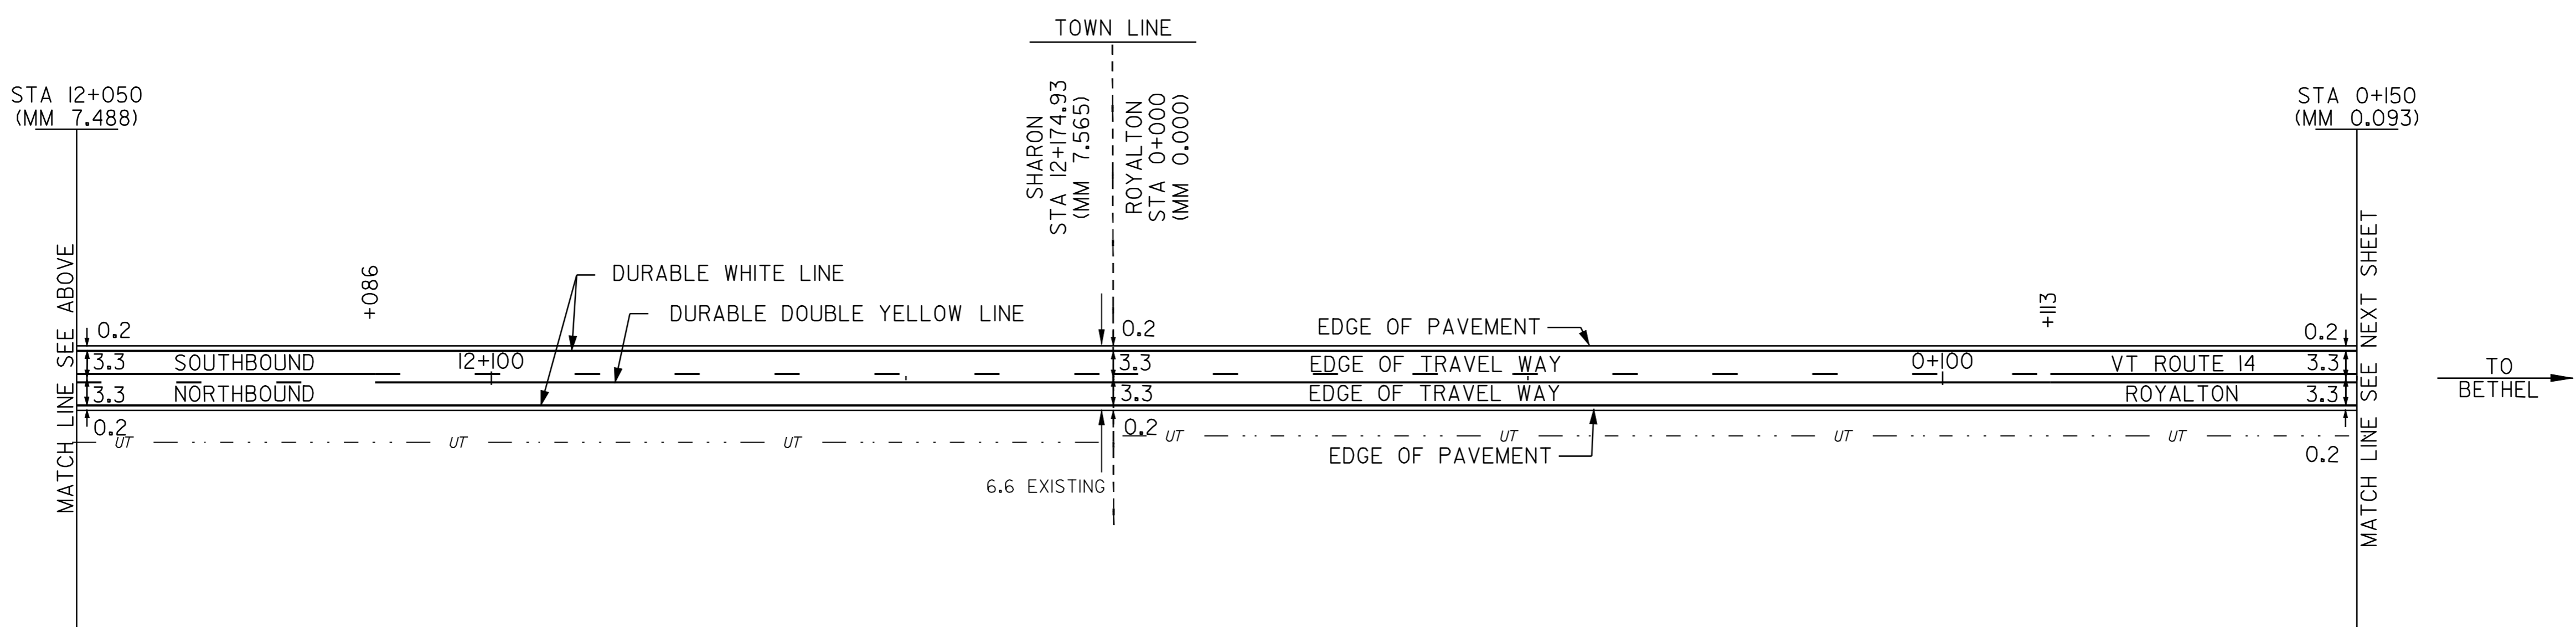


TEMPORARY AND DURABLE 100 mm YELLOW LINE  
 SHARON  
 STA 11+750 TO 11+853 SOLID LT & RT  
 STA 11+853 TO 12+086 SOLID LT, DASHED RT  
 STA 12+086 TO 12+175 DASHED LT, SOLID RT  
 ROYALTON  
 STA 0+000 TO 0+113 DASHED LT, SOLID RT  
 STA 0+113 TO 0+150 SOLID LT & RT

TEMPORARY AND DURABLE 100 MM WHITE LINE  
 SHARON  
 STA 11+750 TO 12+175 SOLID LT & RT  
 ROYALTON  
 STA 0+000 TO 0+150 SOLID LT & RT

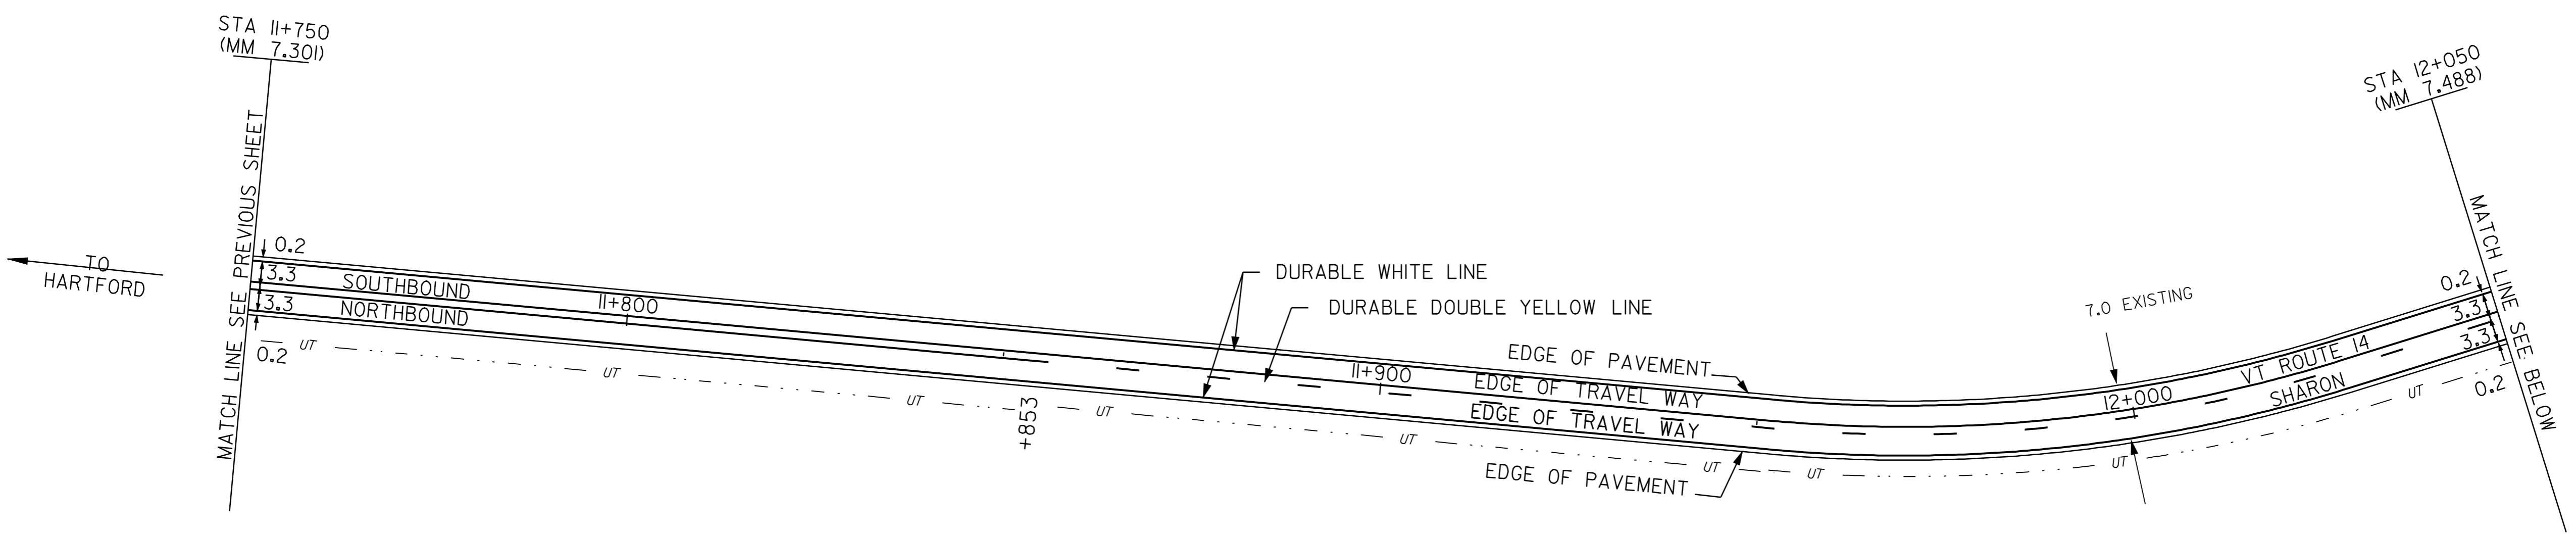

- LEGEND
- R = REMOVE EXISTING
  - S = SALVAGE
  - R&S = REMOVE AND SALVAGE
  - N = NEW
  - RET = RETAIN
  - B-B = BACK TO BACK
  - = NEW RAIL
  - - - = EXISTING RAIL
  - ⊗ = BORING LOCATION

NOTE: ALL DIMENSIONS IN METERS EXCEPT AS INDICATED

DATUM	
VERTICAL	N/A
HORIZONTAL	N/A

NOT TO SCALE

**PAVING PROJECT LAYOUT #39**

PROJECT: HARTFORD - ROYALTON	PROJECT NO.: STP 212(K)S
DESIGN FILE NAME: /pave/98ci74/pcl74.dgn	PLOT DATE: 21-MAR-2007
IPARM FILE NAME: pcl74i39.i	SURVEY DATE: 8/99
SURVEYED BY: CLD ENGINEERS INC	DRAWN BY: REB
SQUAD LEADER: WRH	SHEET: 49 OF 64