

TEMPORARY AND DURABLE 100 mm YELLOW LINE
 STA 0+150 TO 0+750 SOLID LT & RT



STEEL BEAM GUARDRAIL
 STA 0+674 TO 0+750 LT

MANUFACTURED TERMINAL SECTION (TANGENT)
 STA 0+663 TO 0+678 LT

TEMPORARY AND DURABLE 100 mm WHITE LINE
 STA 0+150 TO 0+750 SOLID LT & RT

REMOVAL & DISP. OF GUARDRAIL
 STA 0+674 TO 0+750 LT

STEEL BEAM GUARDRAIL (2.4m POSTS (MOD.))
 0+742 - 0+750 LT

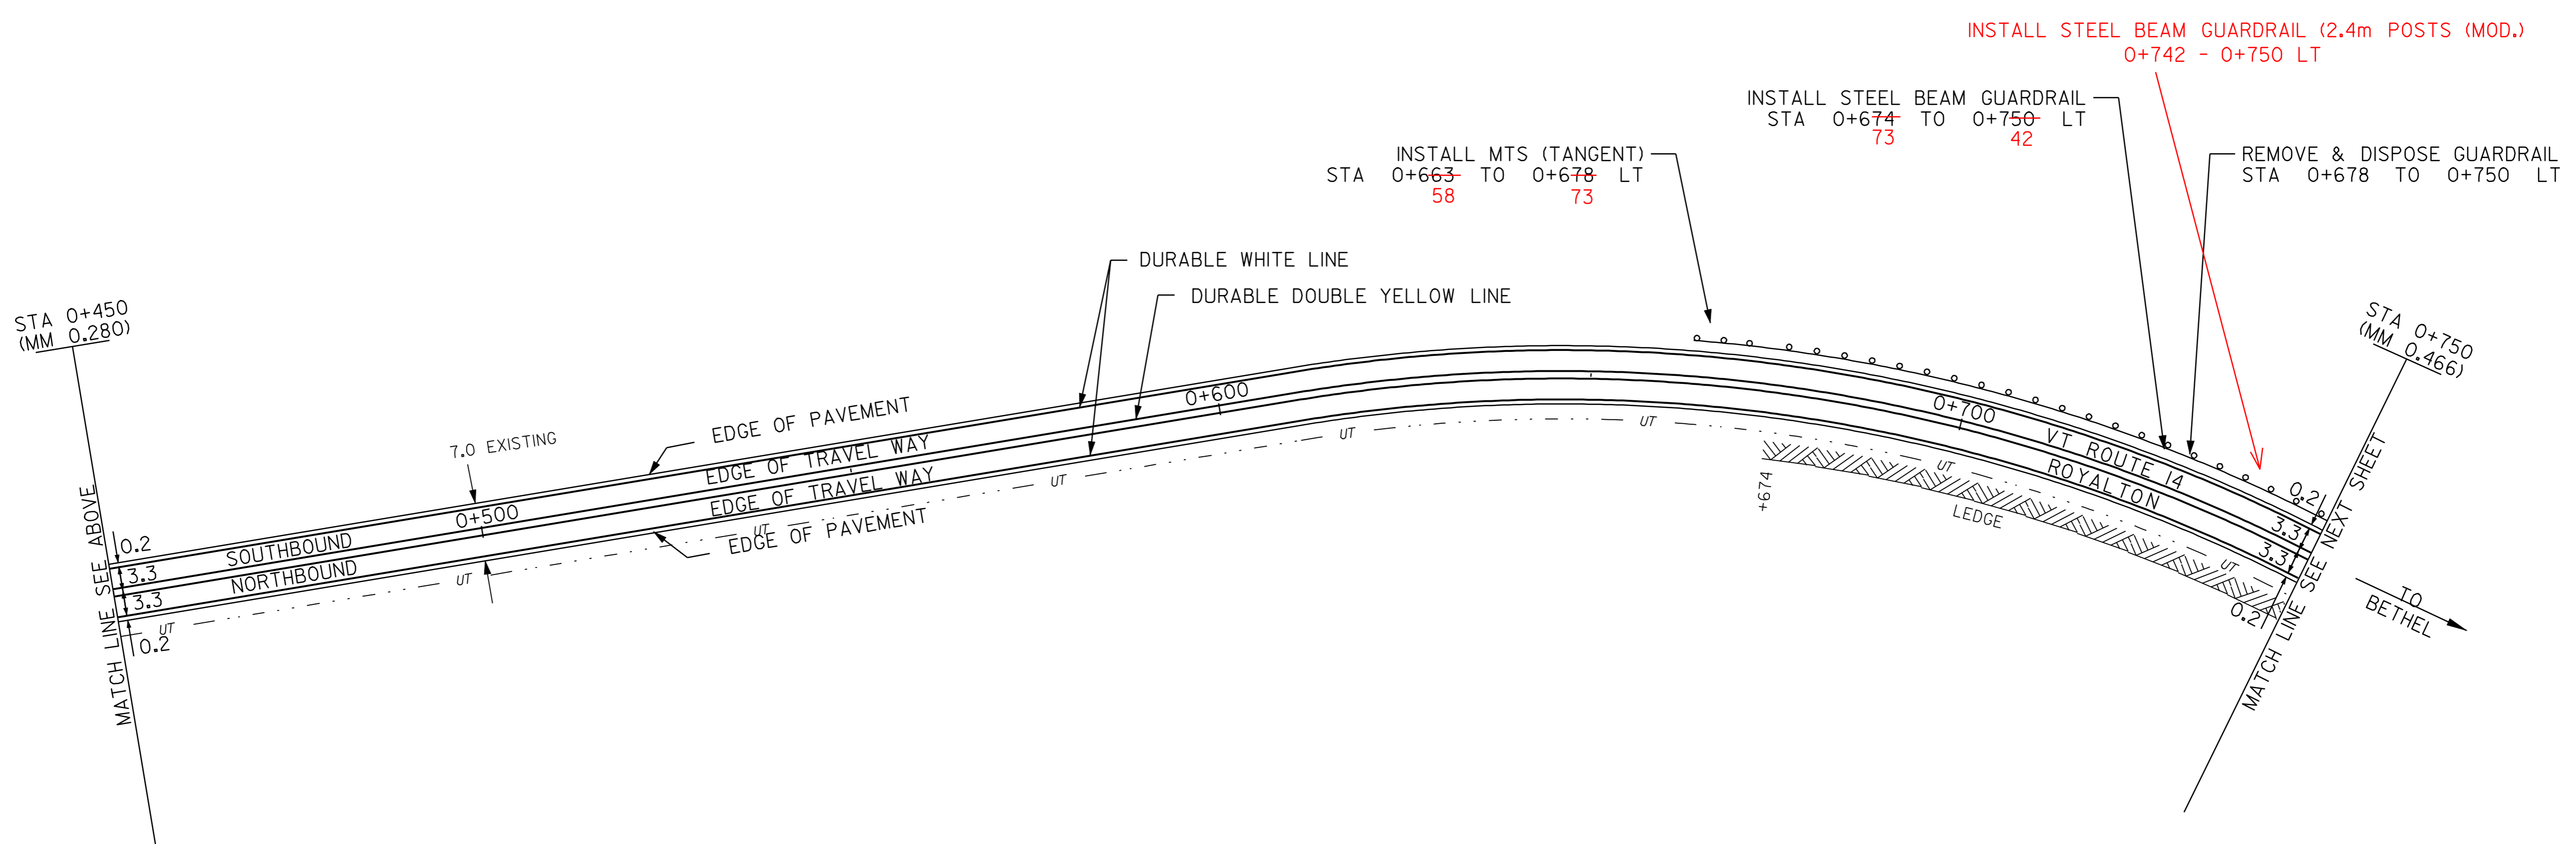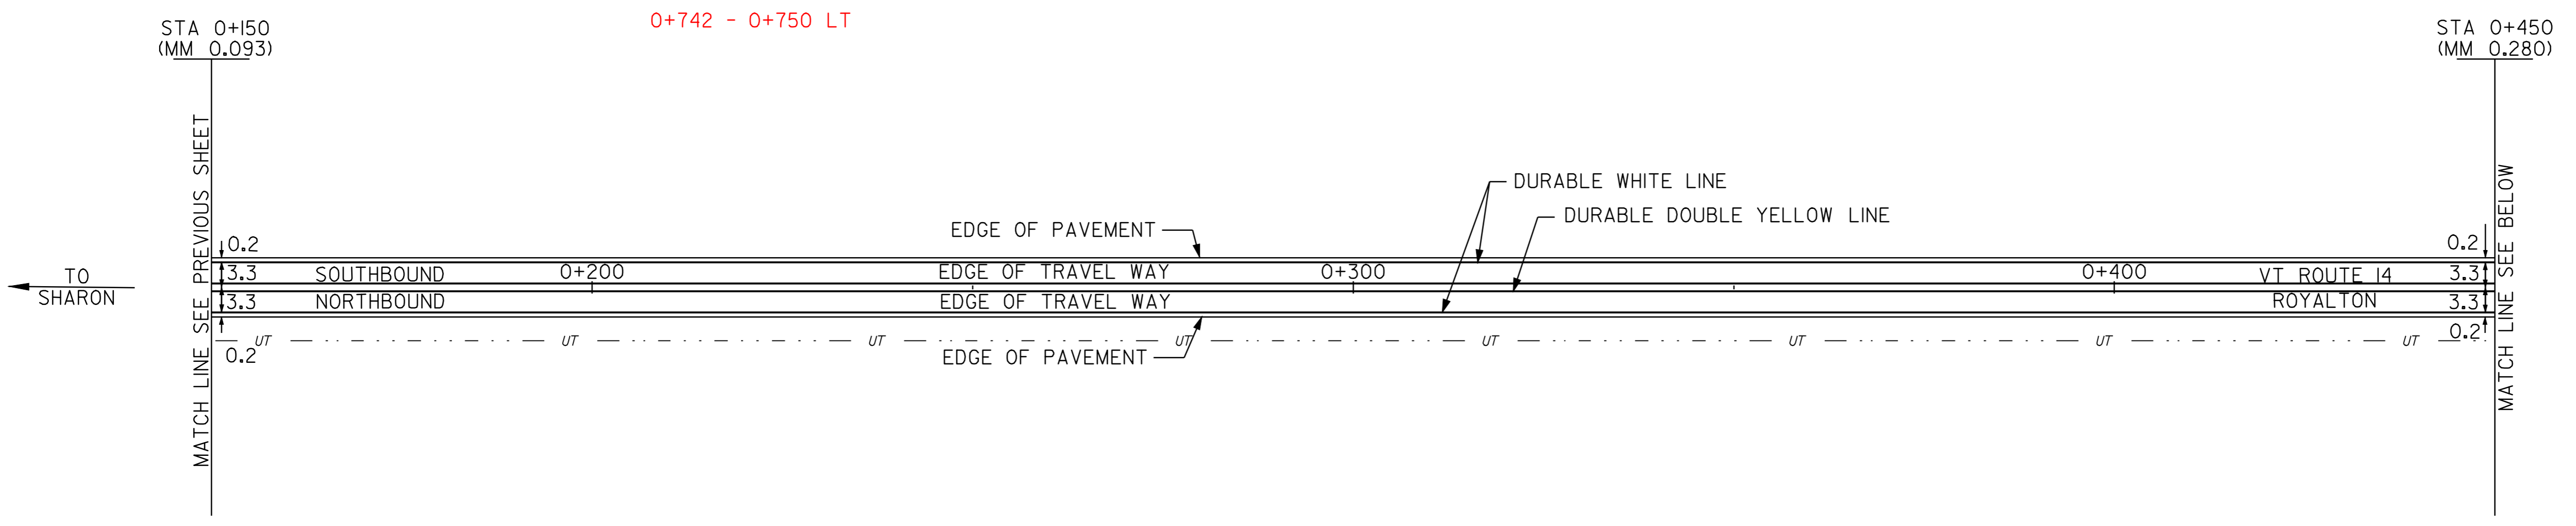

- LEGEND**
- R = REMOVE EXISTING
 - S = SALVAGE
 - R&S = REMOVE AND SALVAGE
 - N = NEW
 - RET = RETAIN
 - B-B = BACK TO BACK
 - = NEW RAIL
 - - - = EXISTING RAIL
 - ⊗ = BORING LOCATION

NOTE: ALL DIMENSIONS IN METERS EXCEPT AS INDICATED

DATUM	
VERTICAL	N/A
HORIZONTAL	N/A

NOT TO SCALE

PAVING PROJECT LAYOUT #40

PROJECT: HARTFORD - ROYALTON	PROJECT NO.: STP 212(I)S
DESIGN FILE NAME: /pave/98cl74/pcl74.dgn	PLOT DATE: 21-MAR-2007
IPARM FILE NAME: pcl74i40.i	SURVEY DATE: 8/99
SURVEYED BY: CLD ENGINEERS INC	DRAWN BY: REB
SQUAD LEADER: WRH	SHEET: 50 OF 64