

TEMPORARY AND DURABLE 100 mm YELLOW LINE
 STA 0+750 TO 1+350 SOLID LT & RT



TEMPORARY AND DURABLE 100 mm WHITE LINE
 STA 0+750 TO 1+350 SOLID LT & RT

STEEL BEAM GUARDRAIL 18
 STA 0+750 TO 0+822 LT
 STA 1+184 TO 1+199 RT
 STA 1+187 TO 1+195 LT
 I+311 TO I+350 LT

~~STEEL BEAM GUARDRAIL (2.4m POST) (MOD)~~
~~STA 1+298 TO 1+350 LT~~

REMOVAL & DISPOSAL OF GUARDRAIL
 STA 0+750 TO 0+833 LT
 STA 1+164 TO 1+201 LT
 STA 1+179 TO 1+207 RT

MANUFACTURED TERMINAL SECTION (FLARED)
 STA 0+822 TO 0+833 LT
 STA 1+173 TO 1+184 RT
 STA 1+176 TO 1+187 LT
 STA 1+195 TO 1+206 LT
 STA 1+199 TO 1+210 RT
 STA 1+287 TO 1+298 LT
 300 311

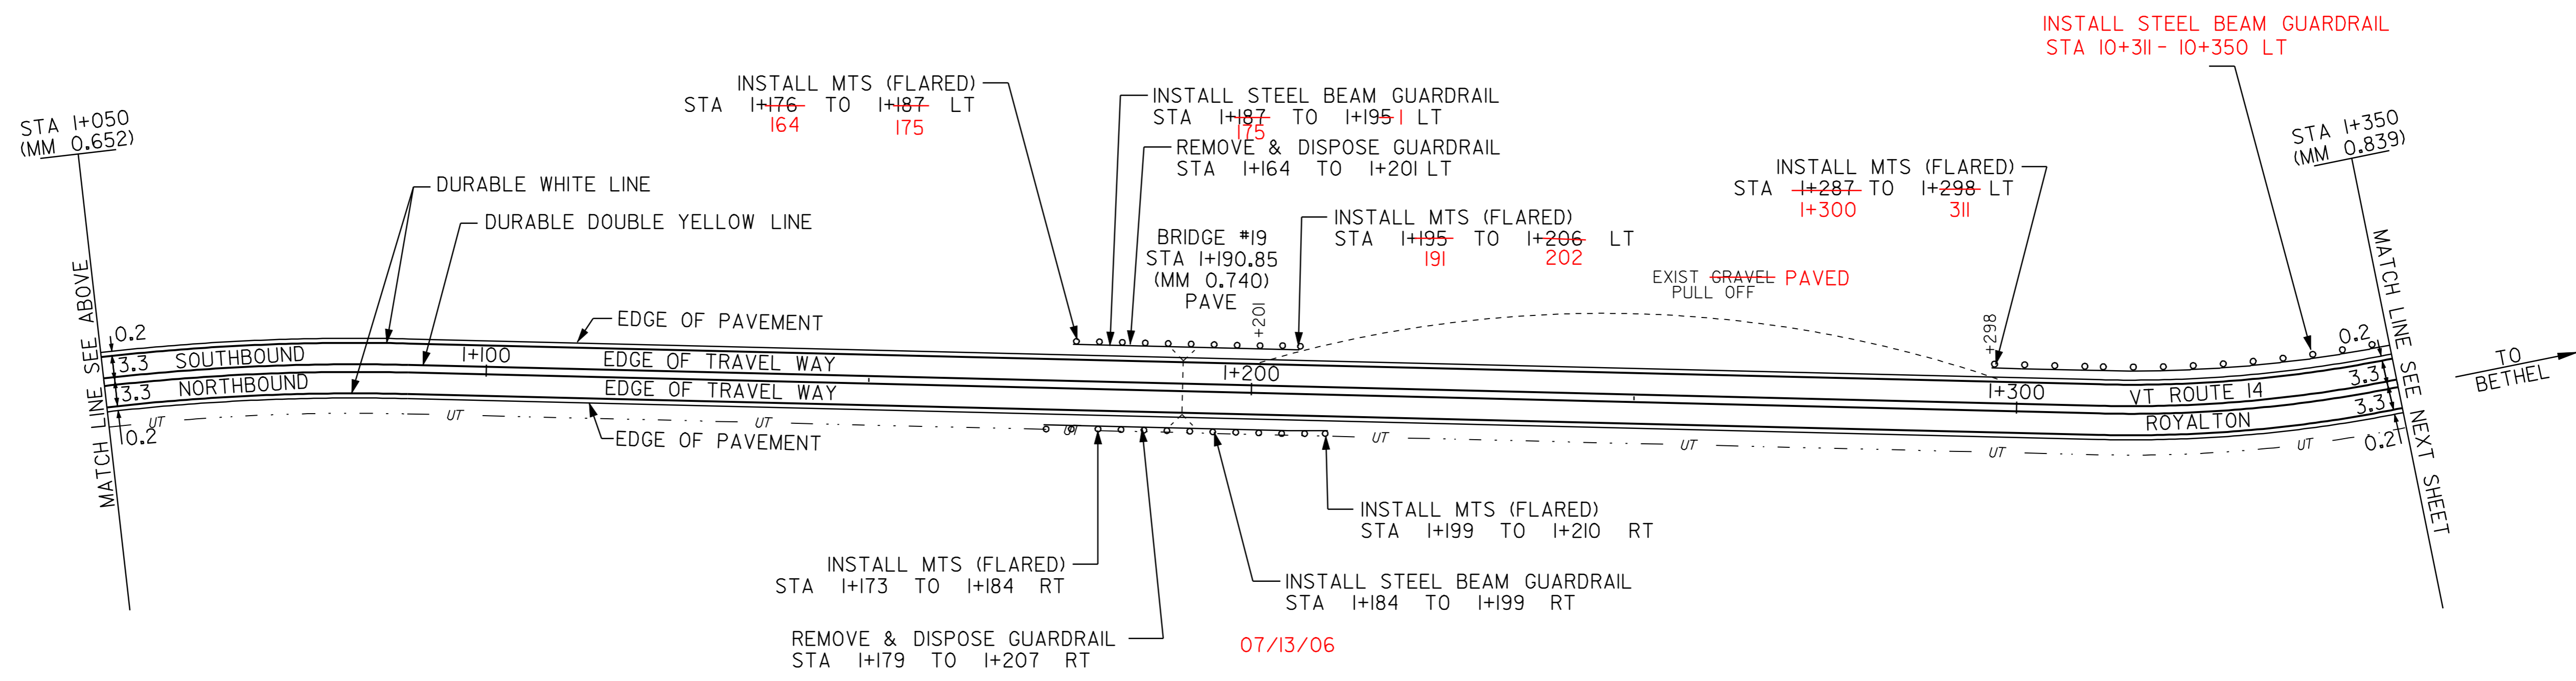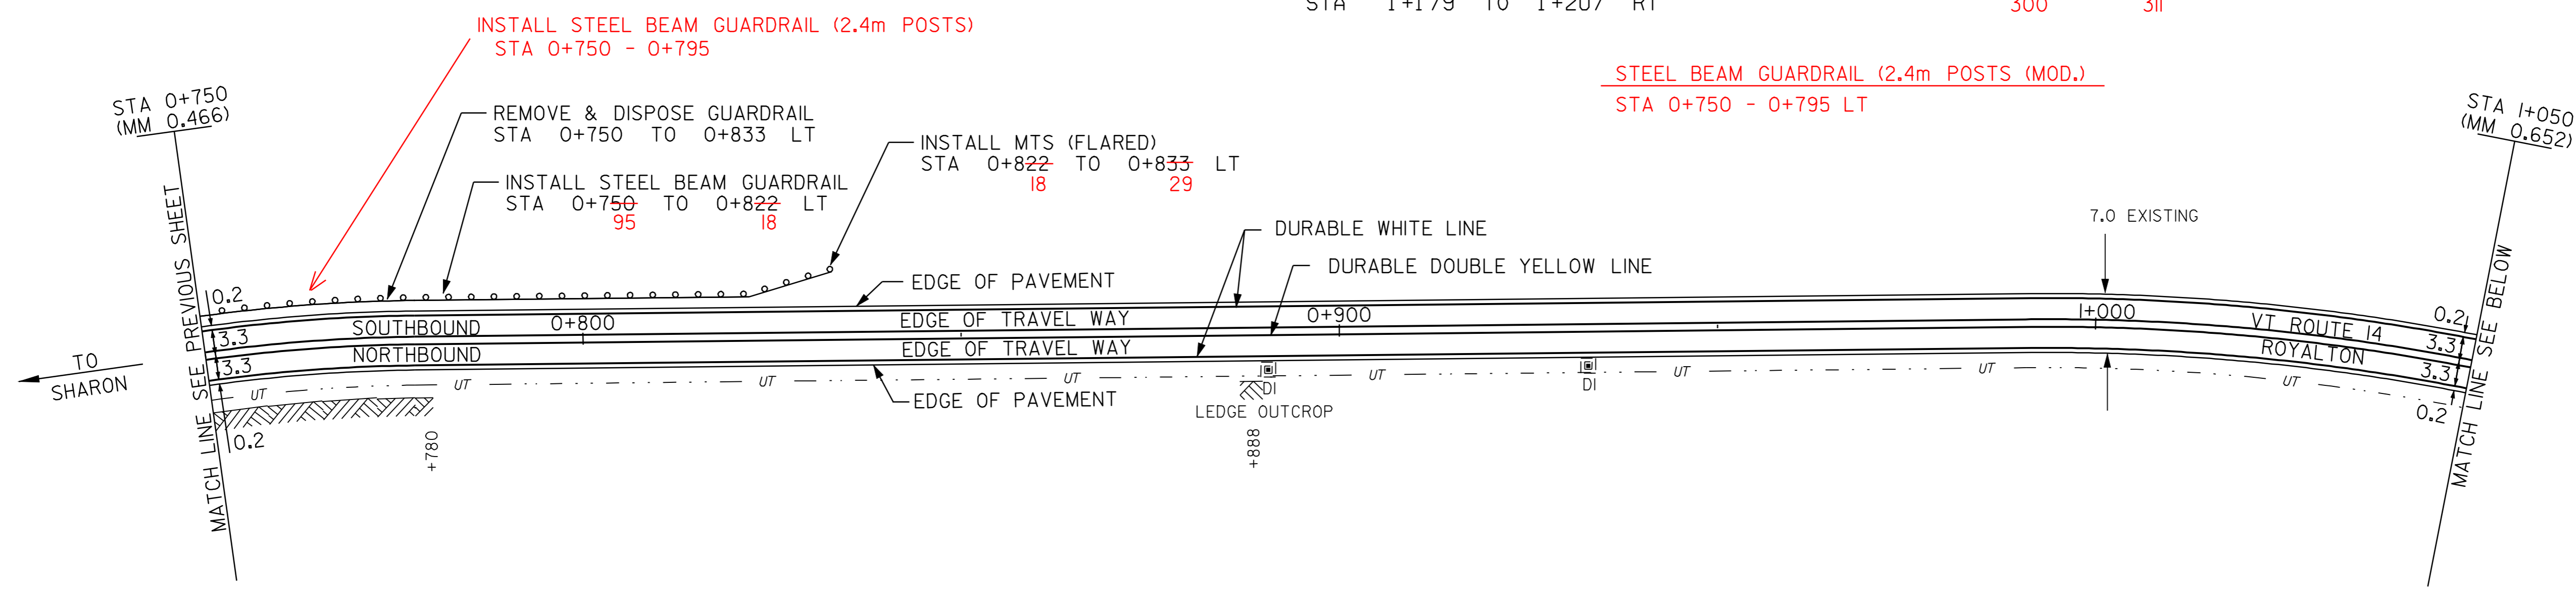

- LEGEND
- R = REMOVE EXISTING
 - S = SALVAGE
 - R&S = REMOVE AND SALVAGE
 - N = NEW
 - RET = RETAIN
 - B-B = BACK TO BACK
 - = NEW RAIL
 - - - = EXISTING RAIL
 - ⊗ = BORING LOCATION

NOTE: ALL DIMENSIONS IN METERS EXCEPT AS INDICATED

DATUM	
VERTICAL	N/A
HORIZONTAL	N/A

NOT TO SCALE

PAVING PROJECT LAYOUT #41

PROJECT: HARTFORD - ROYALTON	PROJECT NO.: STP 212(1)S
DESIGN FILE NAME: /pave/98ci74/pol74.dgn	PLOT DATE: 21-MAR-2007
IPARM FILE NAME: pol74.dgn	SURVEYED BY: CLD_ENGINEERS_INC
SURVEYED BY: CLD_ENGINEERS_INC	SURVEY DATE: 8/99
SQUAD LEADER: WRH	DRAWN BY: REB
	SHEET: 51 OF 64