
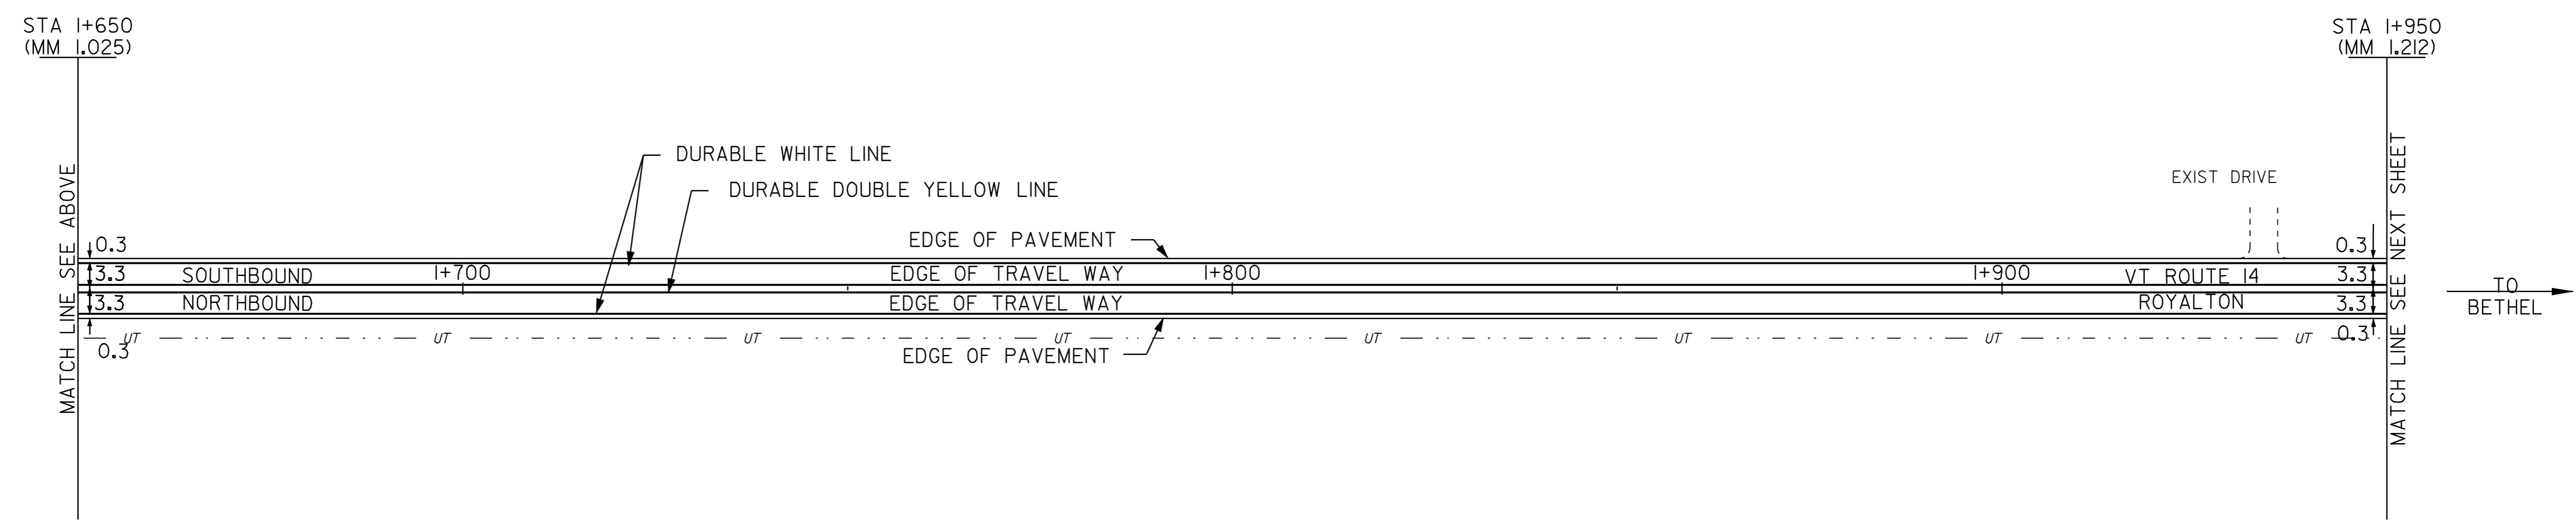


TEMPORARY AND DURABLE 100 mm YELLOW LINE  
 STA 1+350 TO 1+950 SOLID LT & RT

STEEL BEAM GUARDRAIL (2.4m POST) (MOD)  
 STA 1+350 TO 1+499 LT  
 502

MANUFACTURED TERMINAL SECTION (FLARED)  
 STA 1+499 TO 1+510 LT  
 502 513

TEMPORARY AND DURABLE 100 mm WHITE LINE  
 STA 1+350 TO 1+950 SOLID LT & RT

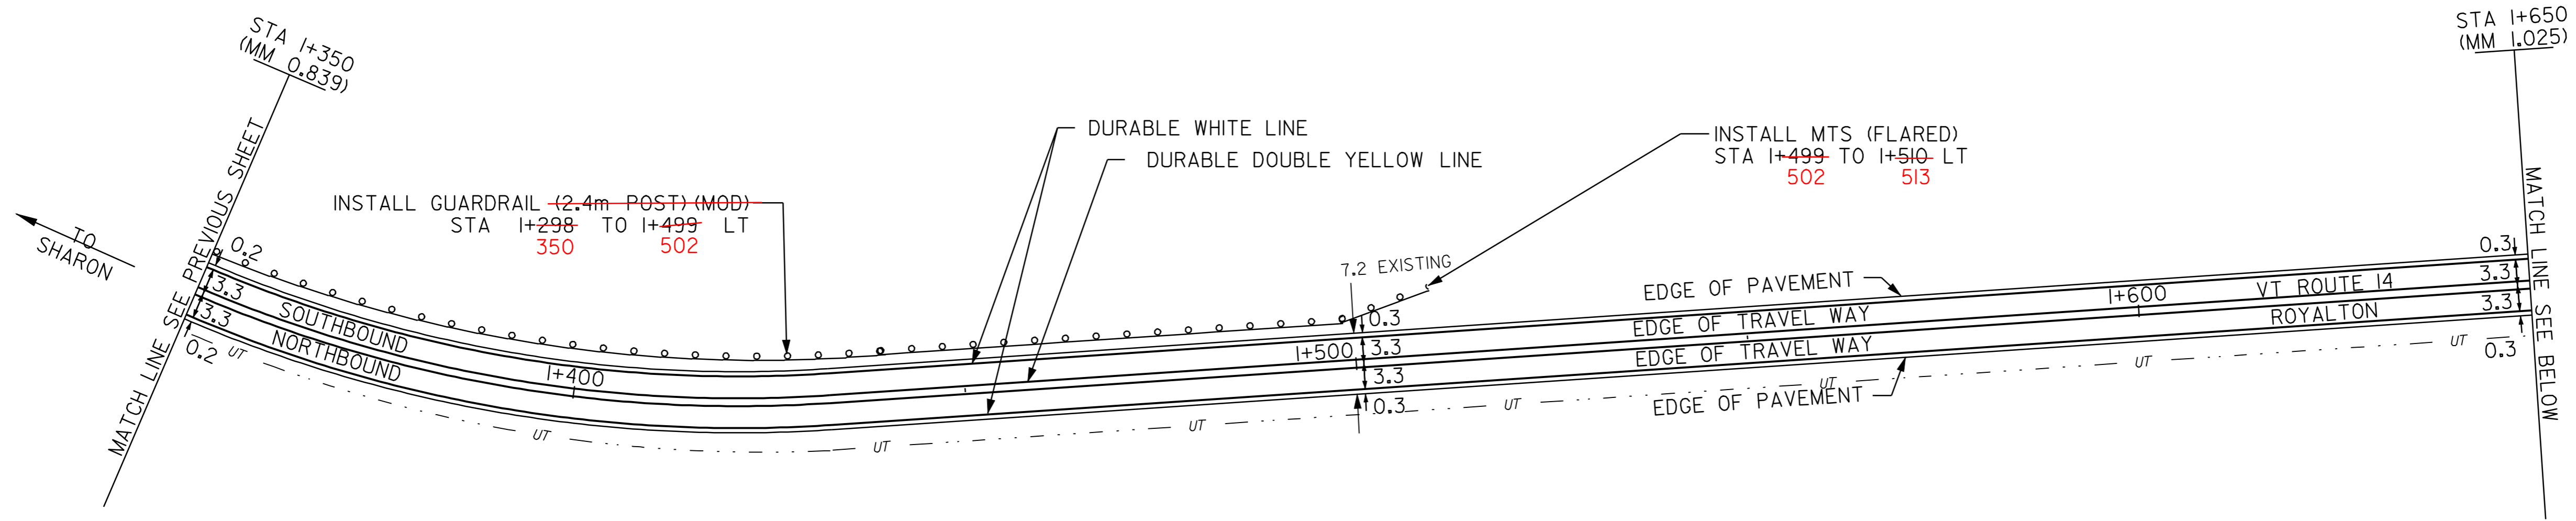

LEGEND

- R = REMOVE EXISTING
- S = SALVAGE
- R&S = REMOVE AND SALVAGE
- N = NEW
- RET = RETAIN
- B-B = BACK TO BACK
- = NEW RAIL
- - - = EXISTING RAIL
- ⊗ = BORING LOCATION

NOTE: ALL DIMENSIONS IN METERS EXCEPT AS INDICATED

DATUM	
VERTICAL	N/A
HORIZONTAL	N/A

NOT TO SCALE

**PAVING  
PROJECT  
LAYOUT #42**

PROJECT: HARTFORD - ROYALTON	PROJECT NO.: STP 212(I)S
DESIGN FILE NAME: /pave/98c174/pcl74.dgn	PLOT DATE: 21-MAR-2007
IPARM FILE NAME: pcl74142.i	SURVEY DATE: 8/99
SURVEYED BY: CLD_ENGINEERS_INC	DRAWN BY: REB
SQUAD LEADER: WRH	SHEET: 52 OF 64