



**BENCHING DETAIL**  
**STA 12+345 ~ 12+425 LT**

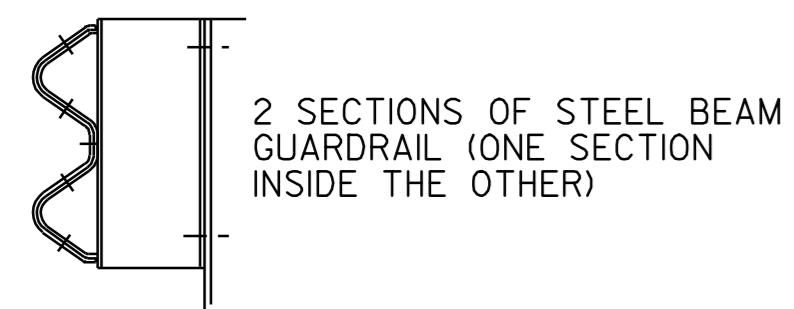

**DETAIL A**

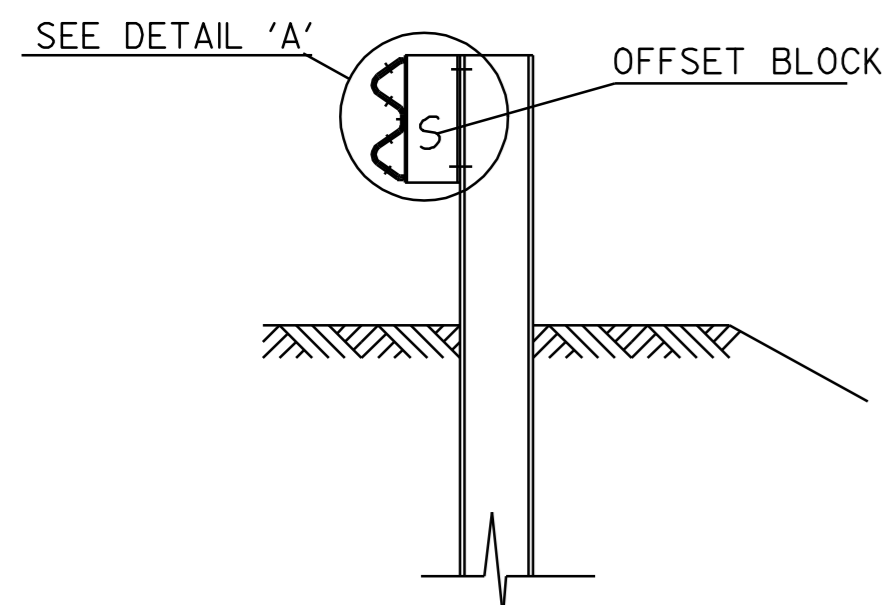


**SECTION A-A**

NOT TO SCALE

**NOTES**

1. SEE STANDARD G-1M & G-1dM FOR STEEL BEAM GUARDRAIL DETAILS.
2. THIS DETAIL TO BE USED AS INDICATED ON THE ITEM DETAIL SHEET OR AS DIRECTED BY THE ENGINEER.
3. THIS WORK SHALL BE PAID FOR AS STEEL BEAM GUARDRAIL AT A PAY FACTOR OF 1.0.

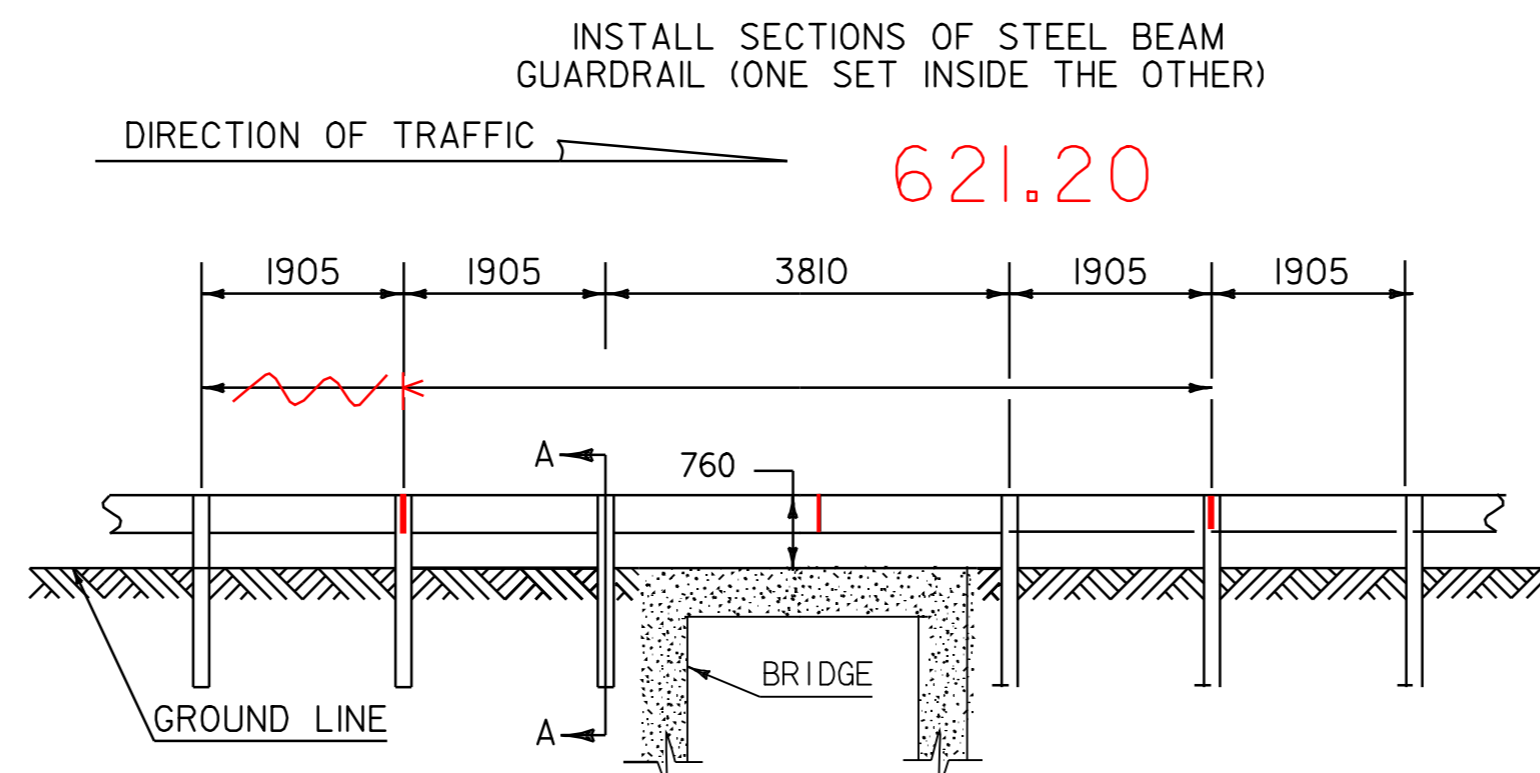


**DETAIL OF STEEL BEAM GUARDRAIL AT BRIDGE #6 @ STA 8+076, HARTFORD (MM 5.018)**

**CULVERT @ STA 11+326, HARTFORD (MM 7.037)**

**BRIDGE #9 @ STA 11+662, HARTFORD (MM 7.246) (FM STA 11+667 MM 7.250)**

**CULVERT @ STA 12+130 HARTFORD**

**BRIDGE #18 @ STA 10+597, SHARON (MM 6.584) (FM STA 10+607 MM 6.591)**

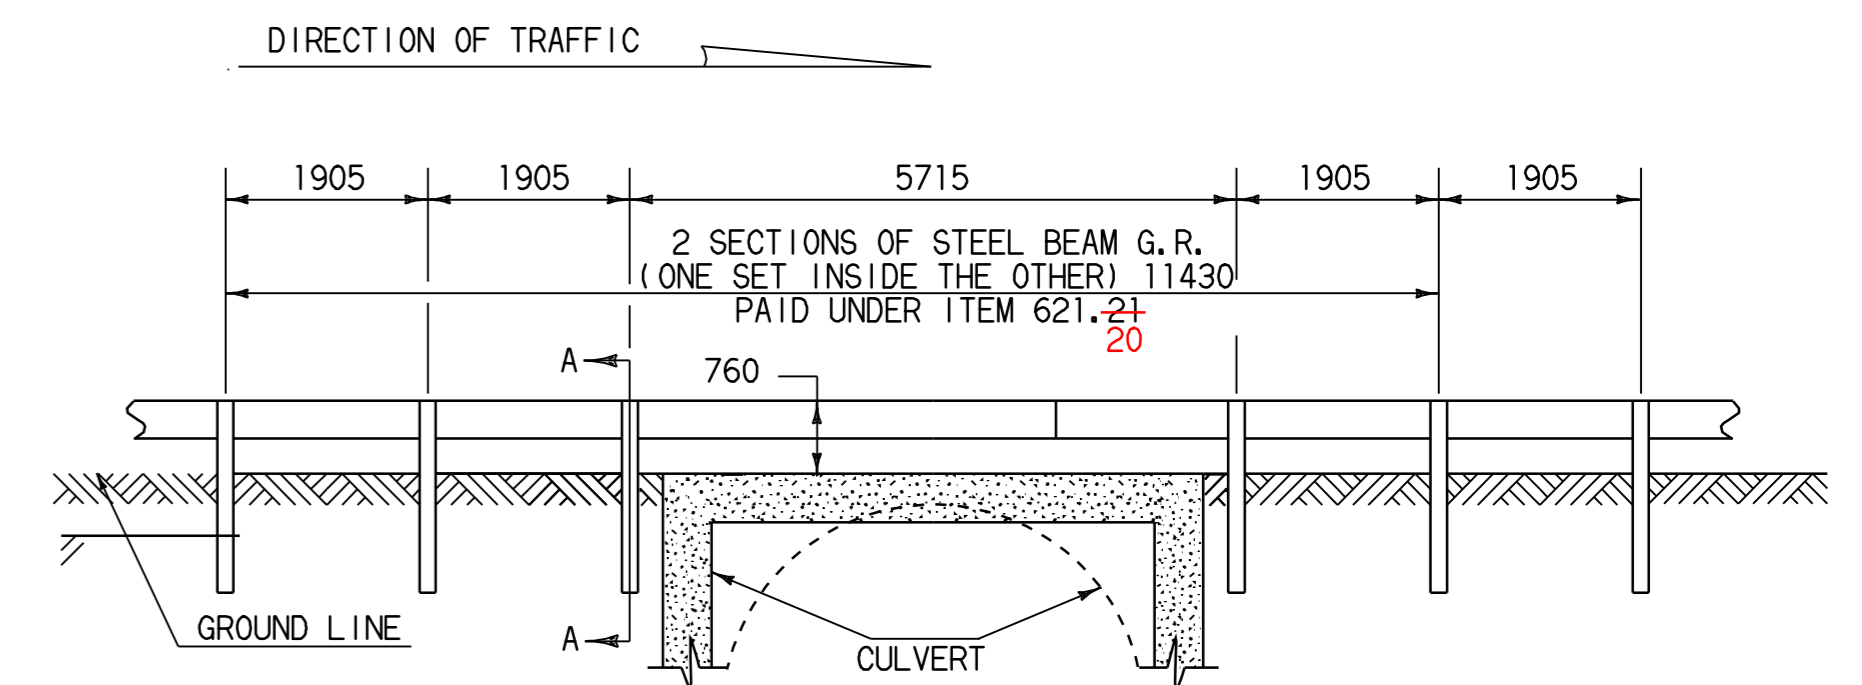

**DETAIL OF STEEL BEAM GUARD RAIL AT LARGE CULVERTS**

NOTE: ALL DIMENSIONS IN MILLIMETERS EXCEPT AS INDICATED

DATUM	
VERTICAL	N/A
HORIZONTAL	N/A

<b>BRIDGE DETAIL SHEET #2</b>	PROJECT: HARTFORD-ROYALTON	PROJECT NO.: STP 212(1)S
	DESIGN FILE NAME: /pave/98cl74/pcl74.dgn	
	IPARM FILE NAME: psi74br02.f	PLOT DATE: 21-MAR-2007 0
	SURVEYED BY: CLD_ENGINEERS_INC	SURVEY DATE: 8/99
	SQUAD LEADER:	DRAWN BY: _REB_
		SHEET: 63 OF 64

NOT TO SCALE