

TEMPORARY AND DURABLE 4in YELLOW LINE
 STA 430+75 TO 444+25 SOLID LT&RT
 STA 443+15 DOUBLE SOLID LT
 (WITH CENTERLINE BREAKS FOR TOWN HIGHWAYS)

TEMPORARY AND DURABLE 4in WHITE LINE
 STA 430+75 TO 444+25 SOLID LT&RT
 (WITH EDGE LINE BREAKS FOR TOWN HIGHWAYS)

TEMPORARY AND DURABLE 24in STOP BAR
 STA 443+15 LT COMSTOCK BRIDGE RD

TEMPORARY AND DURABLE LETTER OR SYMBOL
 STA 443+15 LT "STOP"

REMOVING SIGNS
 7

DITCHING LOCATIONS
 STA 443+53 - 444+25 LT

REMOVAL AND DISPOSAL OF GUARD RAIL
 STA 439+74 TO 440+62 RT
 STA 439+77 TO 440+39 LT
 STA 442+12 TO 442+52 LT
 STA 442+36 TO 443+86 RT

TERMINAL CONNECTOR FOR S.B. GUARD RAIL
 STA 440+14 TO 440+39 LT
 STA 440+37 TO 440+62 RT
 STA 442+12 TO 442+37 LT
 STA 442+36 TO 442+61 RT

STEEL BEAM GUARD RAIL, GALVANIZED
 STA 440+12 TO 440+37 RT
 STA 442+37 TO 442+52 LT
 STA 442+61 TO 443+49 RT

ANCHOR FOR STEEL BEAM RAIL
 STA 442+52 LT

MANUFACTURED TERMINAL SECTION, FLARED
 STA 439+74 TO 440+12 RT
 STA 439+77 TO 440+14 LT
 STA 443+49 TO 443+86 RT

STA 439+77 TO 440+39 LT
 REMOVAL AND DISPOSAL
 OF GUARD RAIL
 STA 439+77 TO 440+14 LT
 INSTALL MANUFACTURED
 TERMINAL SECTION, FLARED
 STA 440+14 TO 440+39 LT
 INSTALL TERMINAL
 CONNECTOR

STA 442+52 LT
 INSTALL ANCHOR FOR
 STEEL BEAM RAIL
 STA 442+37 TO 442+52 LT
 INSTALL STEEL BEAM
 GUARD RAIL, GALVANIZED

STA 442+12 TO 442+52 LT
 REMOVAL AND DISPOSAL
 OF GUARD RAIL
 STA 442+12 TO 442+37 LT
 INSTALL TERMINAL
 CONNECTOR


STA 442+36 TO 443+86 RT
 REMOVAL AND DISPOSAL
 OF GUARD RAIL
 STA 442+36 TO 442+61 RT
 INSTALL TERMINAL
 CONNECTOR
 STA 442+61 TO 443+49 RT
 INSTALL STEEL BEAM
 GUARD RAIL, GALVANIZED
 STA 443+49 TO 443+86 RT
 INSTALL MANUFACTURED
 TERMINAL SECTION, FLARED

- LEGEND
- N = NEW
 - R = REMOVE
 - R&S = REMOVE & SALVAGE
 - S = SALVAGE
 - RET = RETAIN
 - B-T-O-B = BACK TO BACK
 - ⊕ □ □ = CATCH BASIN/DI
 - ⊕ □ □ = EXISTING THROAT DI
 - I = MARKER POST
 - ⊗ = UTILITY POLE
 - ⊗ / ⊗ = UTIL. POLE W/UNDERGROUND UTIL.
 - ⊗ / ⊗ = DRIVE

PAVEMENT CORES - ⊕

#	TOTAL DEPTH (in)	SOLID CORE	DRAINABLE BASE	COMMENTS
13	3.25	YES	NO	LITTLE RUTTING

NOTE:
 - NO PCC UNDER ANY CORES
 - NO CORES OVER ASPHALTED
 - NO SHOULDER CORES

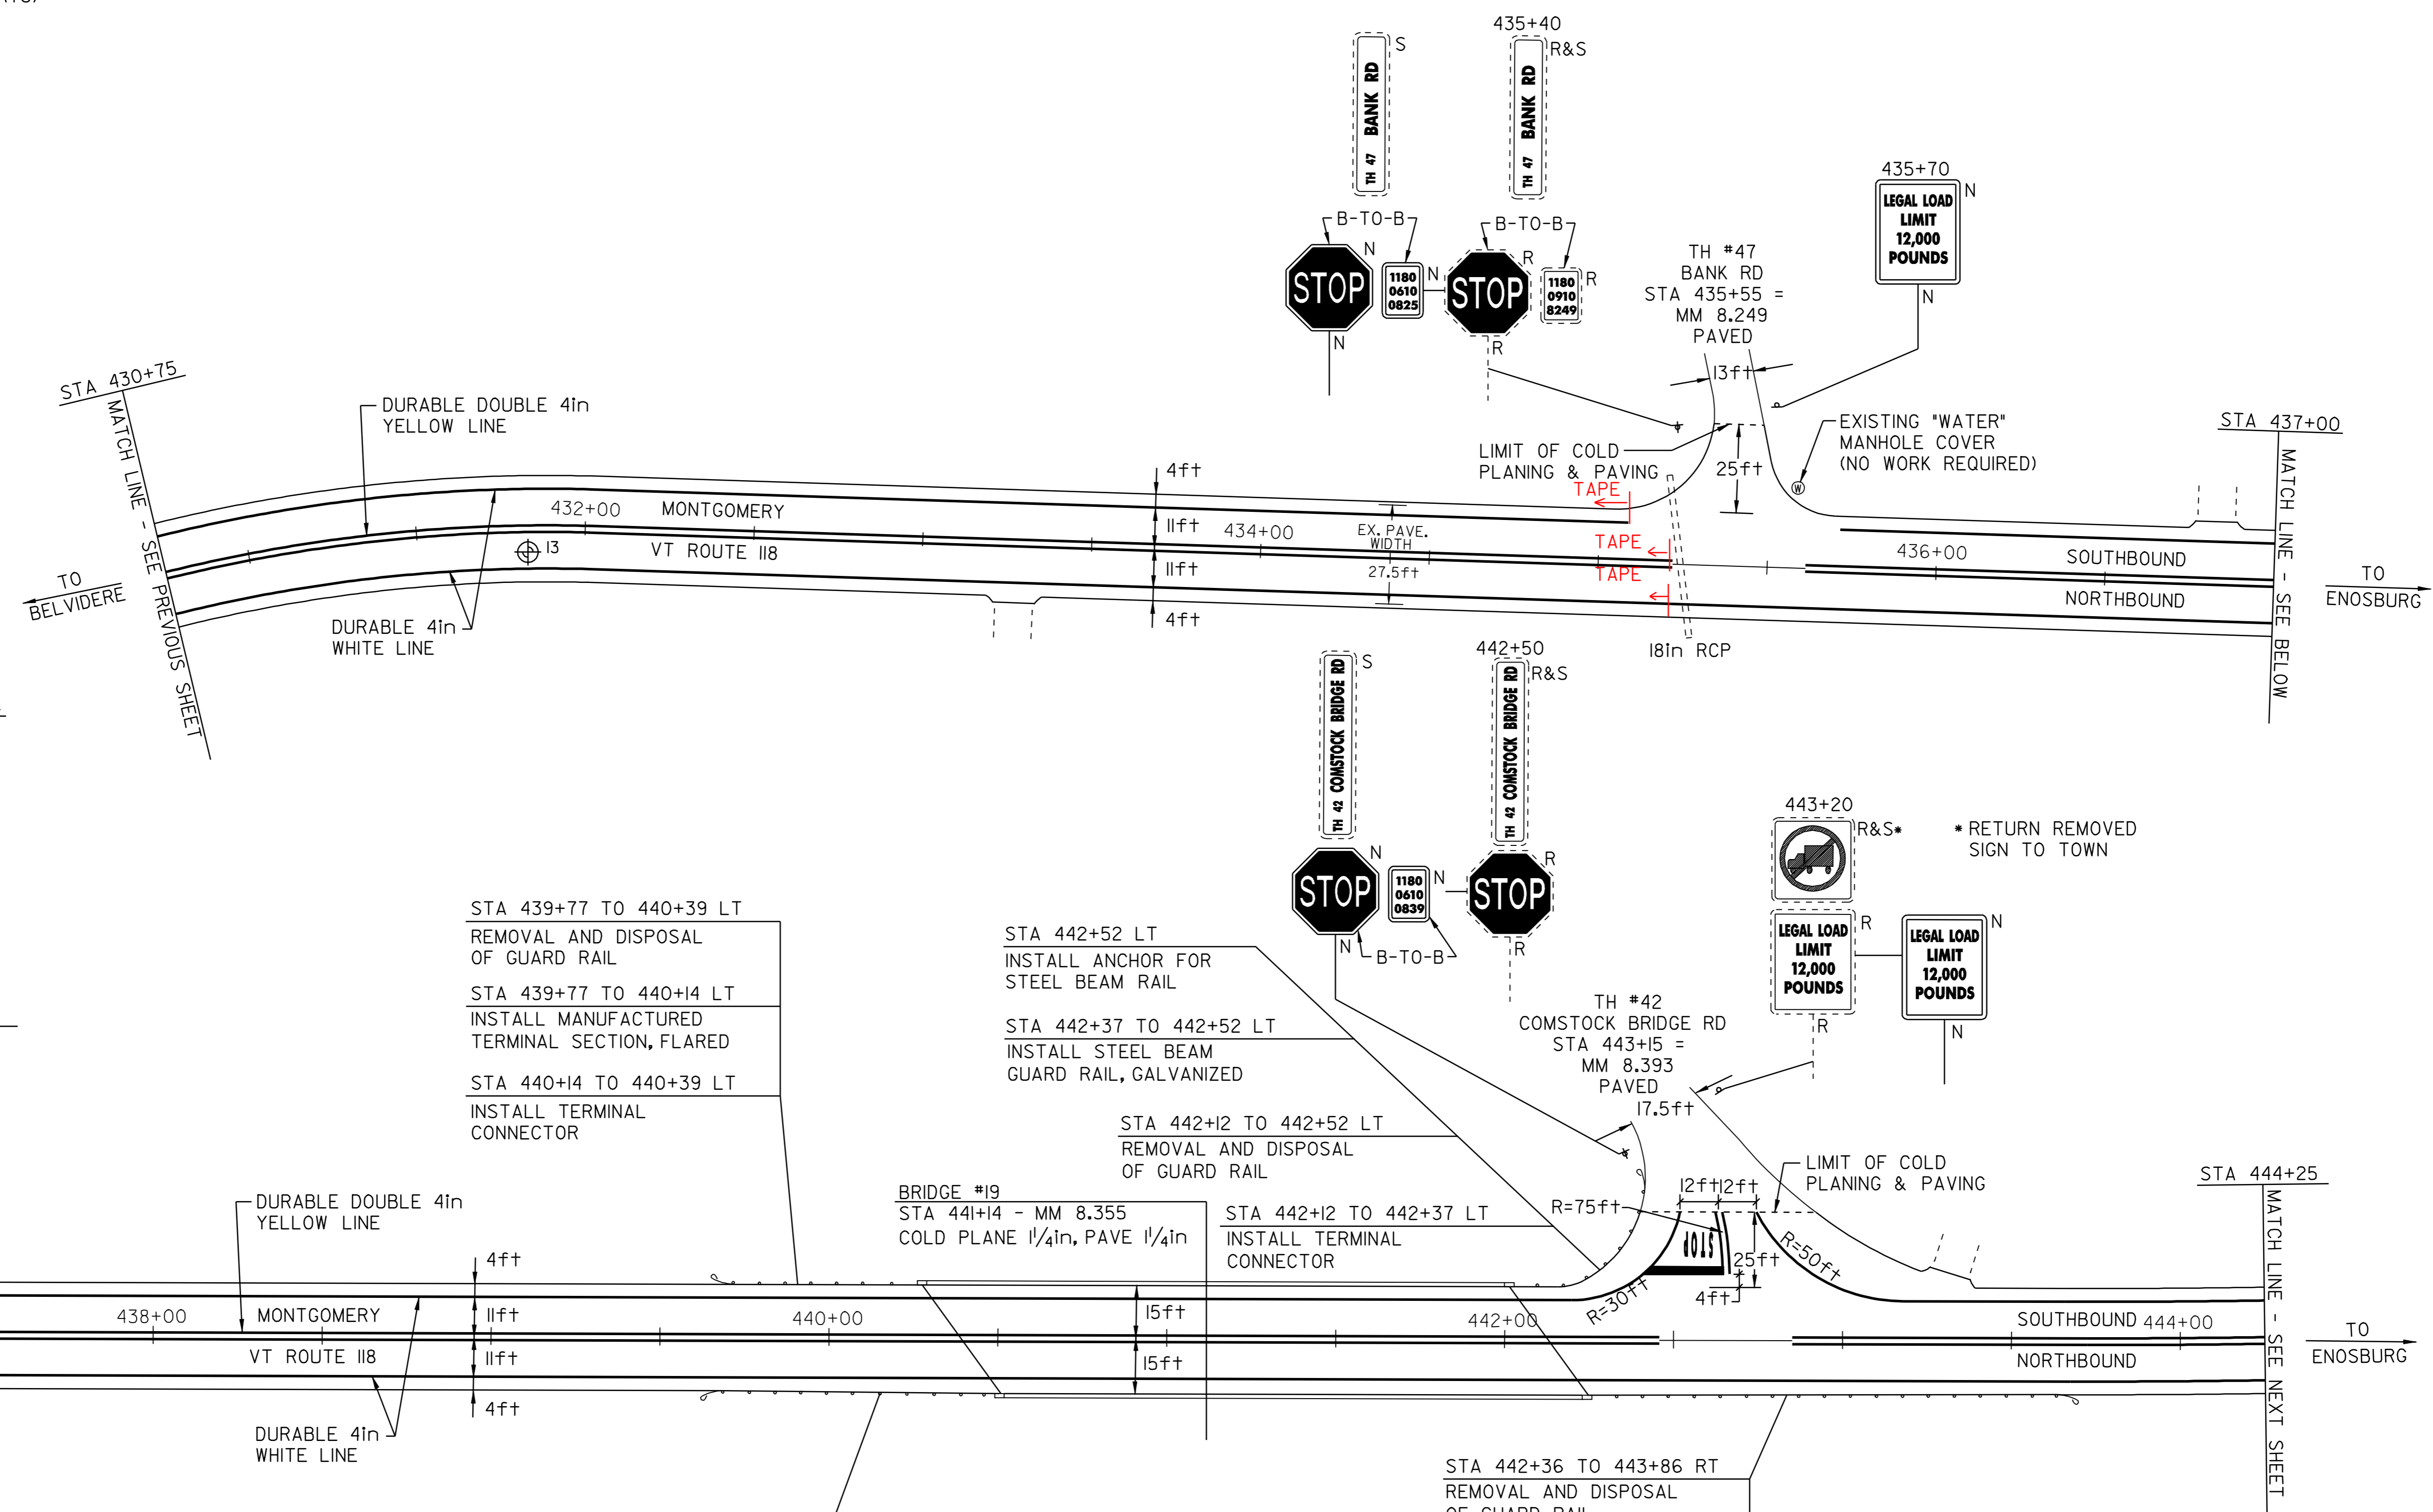

PAVING PROJECT LAYOUT SHEET #6

DESIGNED BY BCE/PJM DATE 6-06
 DRAWN BY C.E.A., INC. DATE 6-06
 DESIGN FILE NO. p98cl82.dgn
 PRF FILE p98cl82106.i DATE PLOTTED 10-FEB-2010 14:
 PROJ. NAME **MONTGOMERY - BERKSHIRE**
 PROJ. NO. **STP 2125(1)S**
 SHEET **16** OF **41** SHEETS