

TEMPORARY AND DURABLE 4in YELLOW LINE

STA 444+25 TO 456+00 SOLID LT&RT  
 STA 448+27 DOUBLE SOLID LT  
 STA 451+12 DOUBLE SOLID LT  
 (WITH CENTERLINE BREAKS FOR TOWN HIGHWAYS)

TEMPORARY AND DURABLE 4in WHITE LINE

STA 444+25 TO 456+00 SOLID LT&RT  
 (WITH EDGE LINE BREAKS FOR TOWN HIGHWAYS)

TEMPORARY AND DURABLE 24in STOP BAR

STA 448+27 LT HILL WEST RD  
 STA 451+12 LT WEST HILL RD

TEMPORARY AND DURABLE LETTER OR SYMBOL


STA 448+27 LT "STOP"  
 STA 451+12 LT "STOP"

REMOVING SIGNS

4

DITCHING LOCATIONS (REFER TO SHEET 10 FOR DETAILS)

STA ~~446+20 TO 448+20~~ LT  
 444+25 TO 446+72 LT

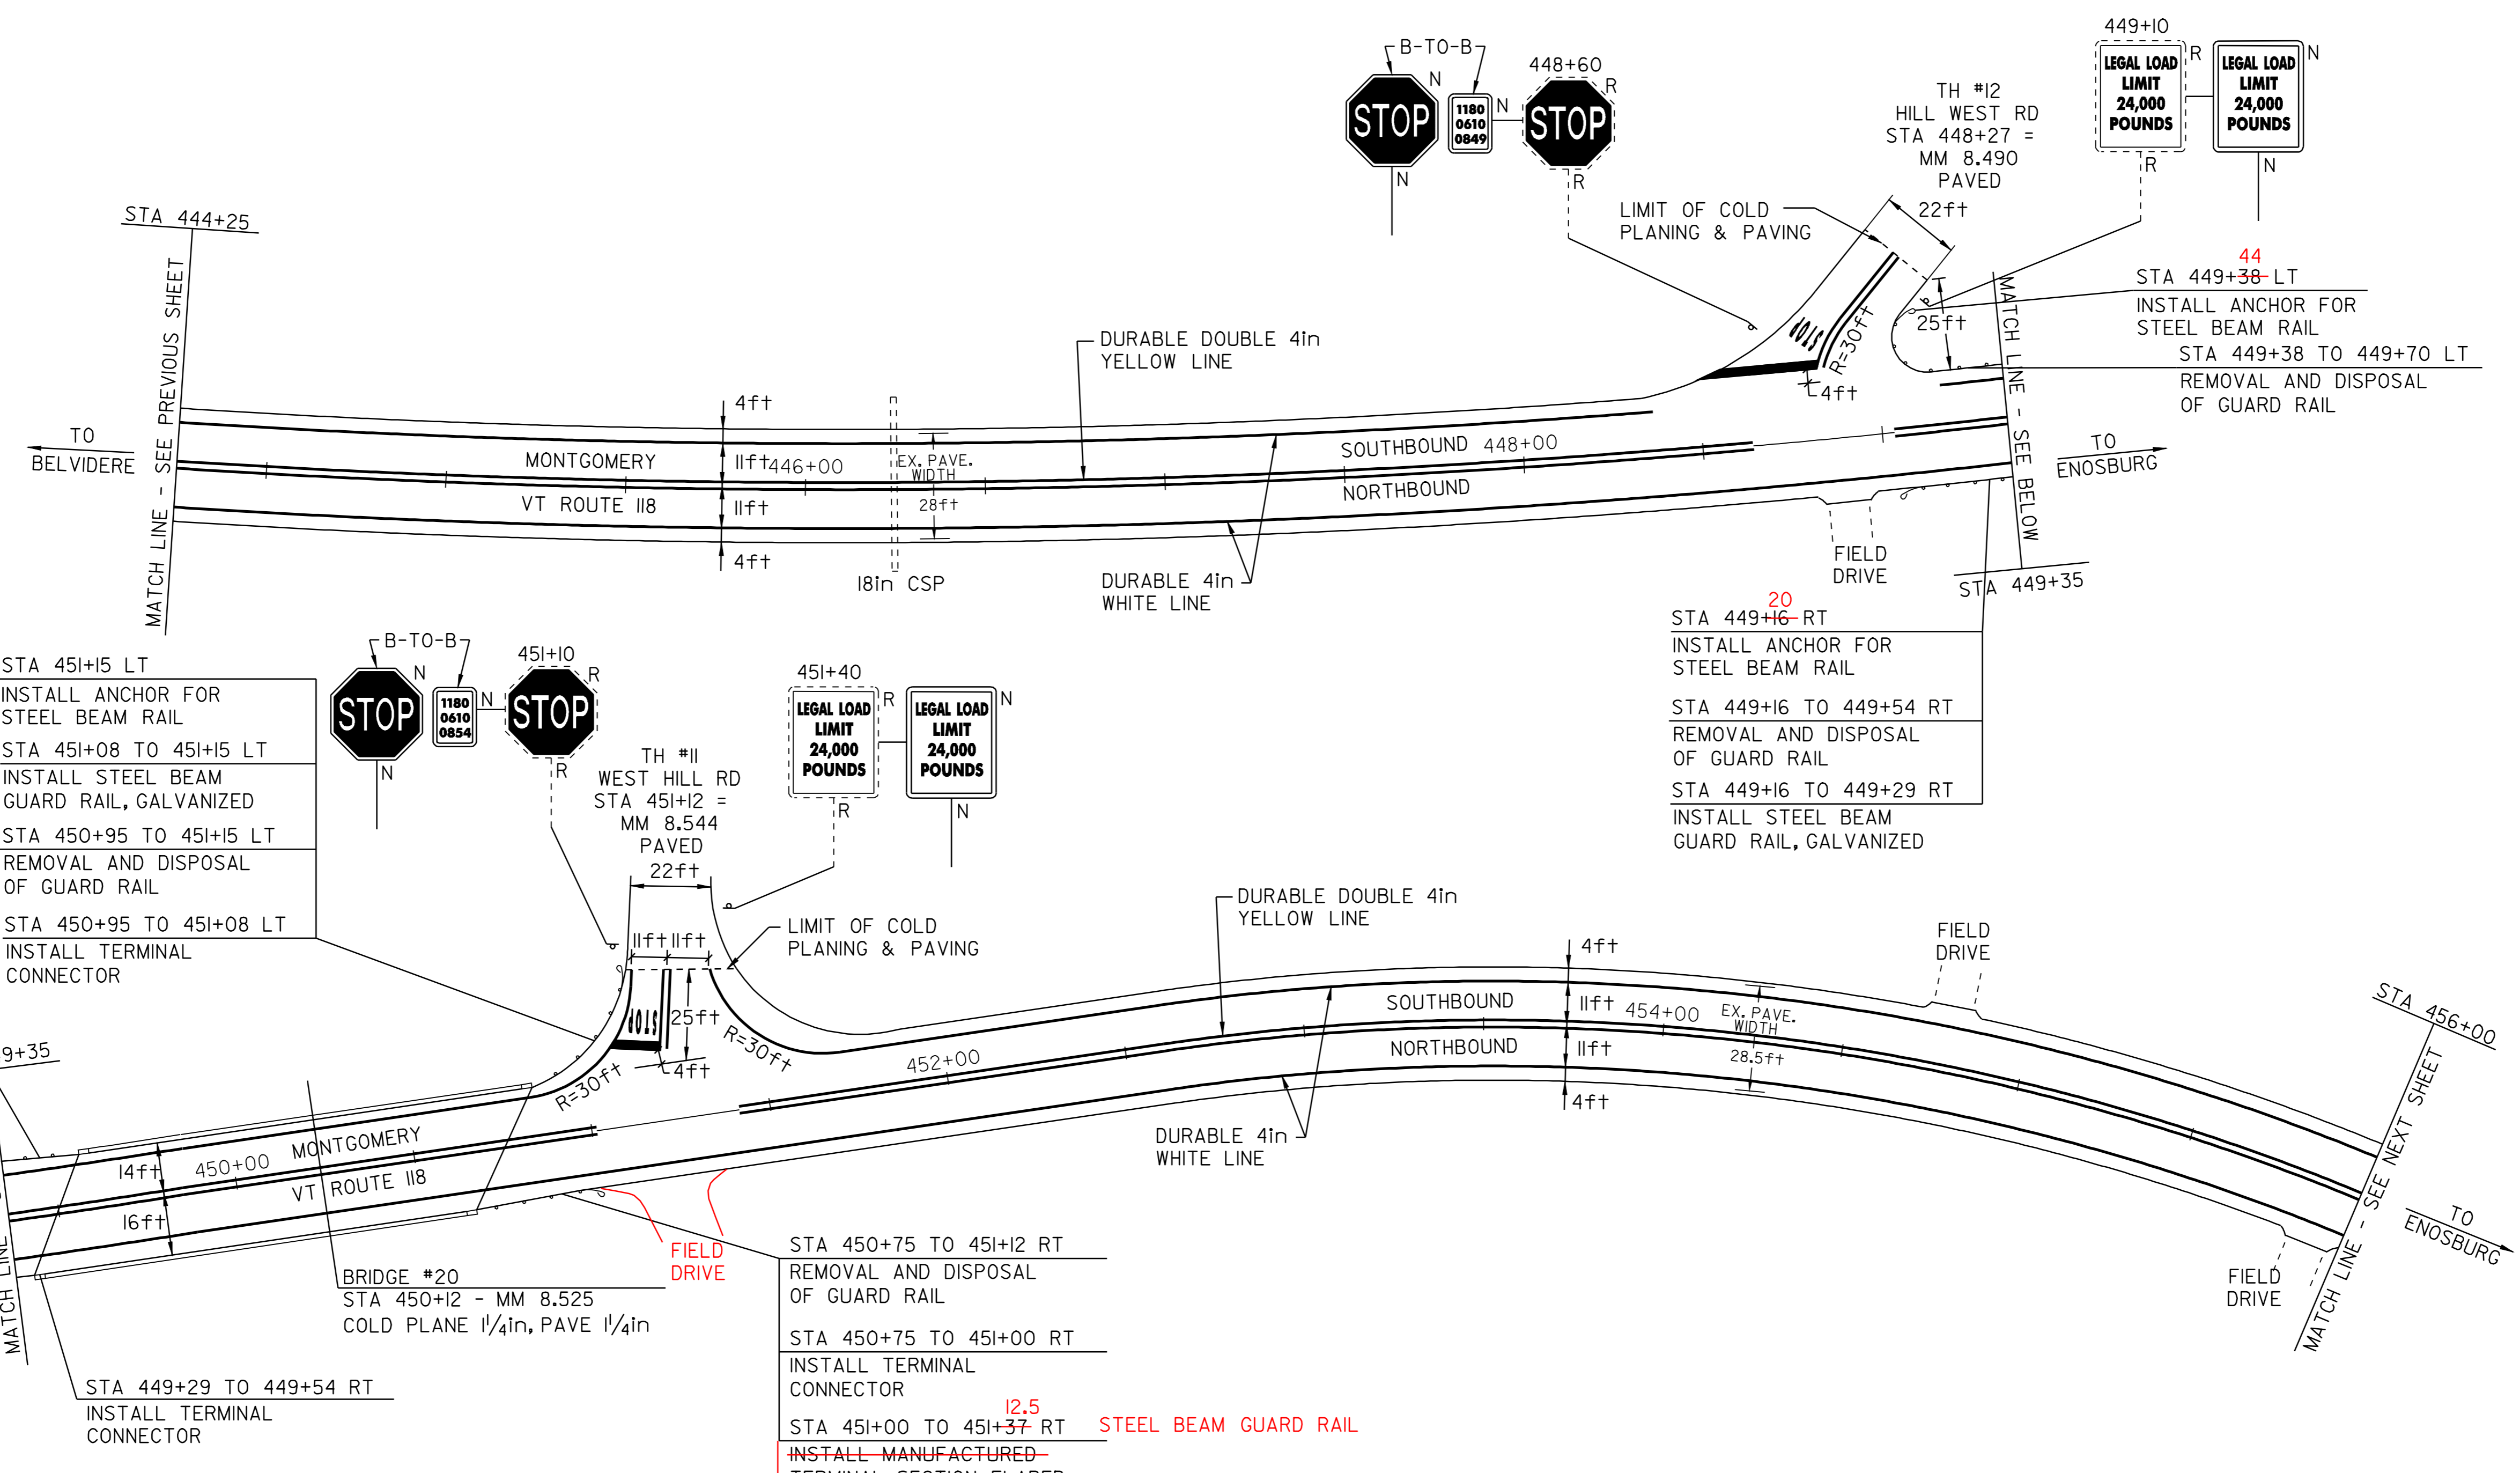

REMOVAL AND DISPOSAL OF GUARD RAIL

STA 449+16 TO 449+54 RT  
 STA 449+38 TO 449+70 LT  
 STA 450+75 TO 451+12 RT  
 STA 450+95 TO 451+15 LT

TERMINAL CONNECTOR FOR S.B. GUARD RAIL

STA 449+29 TO 449+54 RT  
 STA 449+45 TO 449+70 LT  
 STA 450+75 TO 451+00 RT  
 STA 450+95 TO 451+08 LT

STEEL BEAM GUARD RAIL, GALVANIZED

STA 449+16 TO 449+29 RT  
 STA 449+38 TO 449+45 LT  
 STA 451+08 TO 451+15 LT  
 STA 451+00 TO 451+2.5 RT

ANCHOR FOR STEEL BEAM RAIL

STA 449+16 RT <sup>20</sup>  
 STA 449+38 LT <sup>44</sup>  
 STA 451+15 LT  
 STA 451+07 RT  
 MANUFACTURED TERMINAL SECTION, FLARED

ANCHOR FOR STEEL BEAM RAIL

STA 451+00 TO 451+37 RT

STA 450+75 TO 451+12 RT

REMOVAL AND DISPOSAL OF GUARD RAIL

STA 450+75 TO 451+00 RT

INSTALL TERMINAL CONNECTOR

STA 451+00 TO 451+37 RT

INSTALL ~~MANUFACTURED~~ STEEL BEAM GUARD RAIL  
 TERMINAL SECTION, FLARED

STA 451+07 RT

ANCHOR FOR STEEL BEAM RAIL

LEGEND

- N = NEW
- R = REMOVE
- R&S = REMOVE & SALVAGE
- S = SALVAGE
- RET = RETAIN
- B-TO-B = BACK TO BACK
- ⊕ ⊞ ⊠ CATCH BASIN/DI
- ⊙ ⊠ EXISTING THROAT DI
- I MARKER POST
- ⊗ UTILITY POLE
- ⊗/I UTIL. POLE W/UNDERGROUND UTIL.
- - - DRIVE

## PAVING PROJECT LAYOUT SHEET #7

DESIGNED BY	BCE/PJM	DATE	6-06
DRAWN BY	C.E.A., INC.	DATE	6-06
DESIGN FILE NO.	p98cl82.dgn		
PRF FILE	p98cl82107.1	DATE PLOTTED	10-FEB-2010 14:
PROJ. NAME	MONTGOMERY - BERKSHIRE		
PROJ. NO.	STP 2125(1)S		
SHEET	17	OF	41 SHEETS