


TEMPORARY AND DURABLE 4in YELLOW LINE  
 STA 0+00 TO ~~20+54~~  
 STA ~~41+18~~ TO 43+25  
 SOLID LT&RT  
 SOLID LT&RT

TEMPORARY AND DURABLE 4in WHITE LINE  
 STA 0+00 TO ~~20+54~~  
 STA ~~41+18~~ TO 43+25  
 SOLID LT&RT  
 SOLID LT&RT

REHABILITATION OF C.B.'S, D.I.'S, OR M.H.'S  
 STA 5+35 LT&RT CLASS III  
 STA 5+35 RT CLASS I

DITCHING LOCATIONS (REFER TO SHEET 10 FOR DETAILS)  
 STA 4+25 TO 8+90 RT  
 I+00 TO 5+04

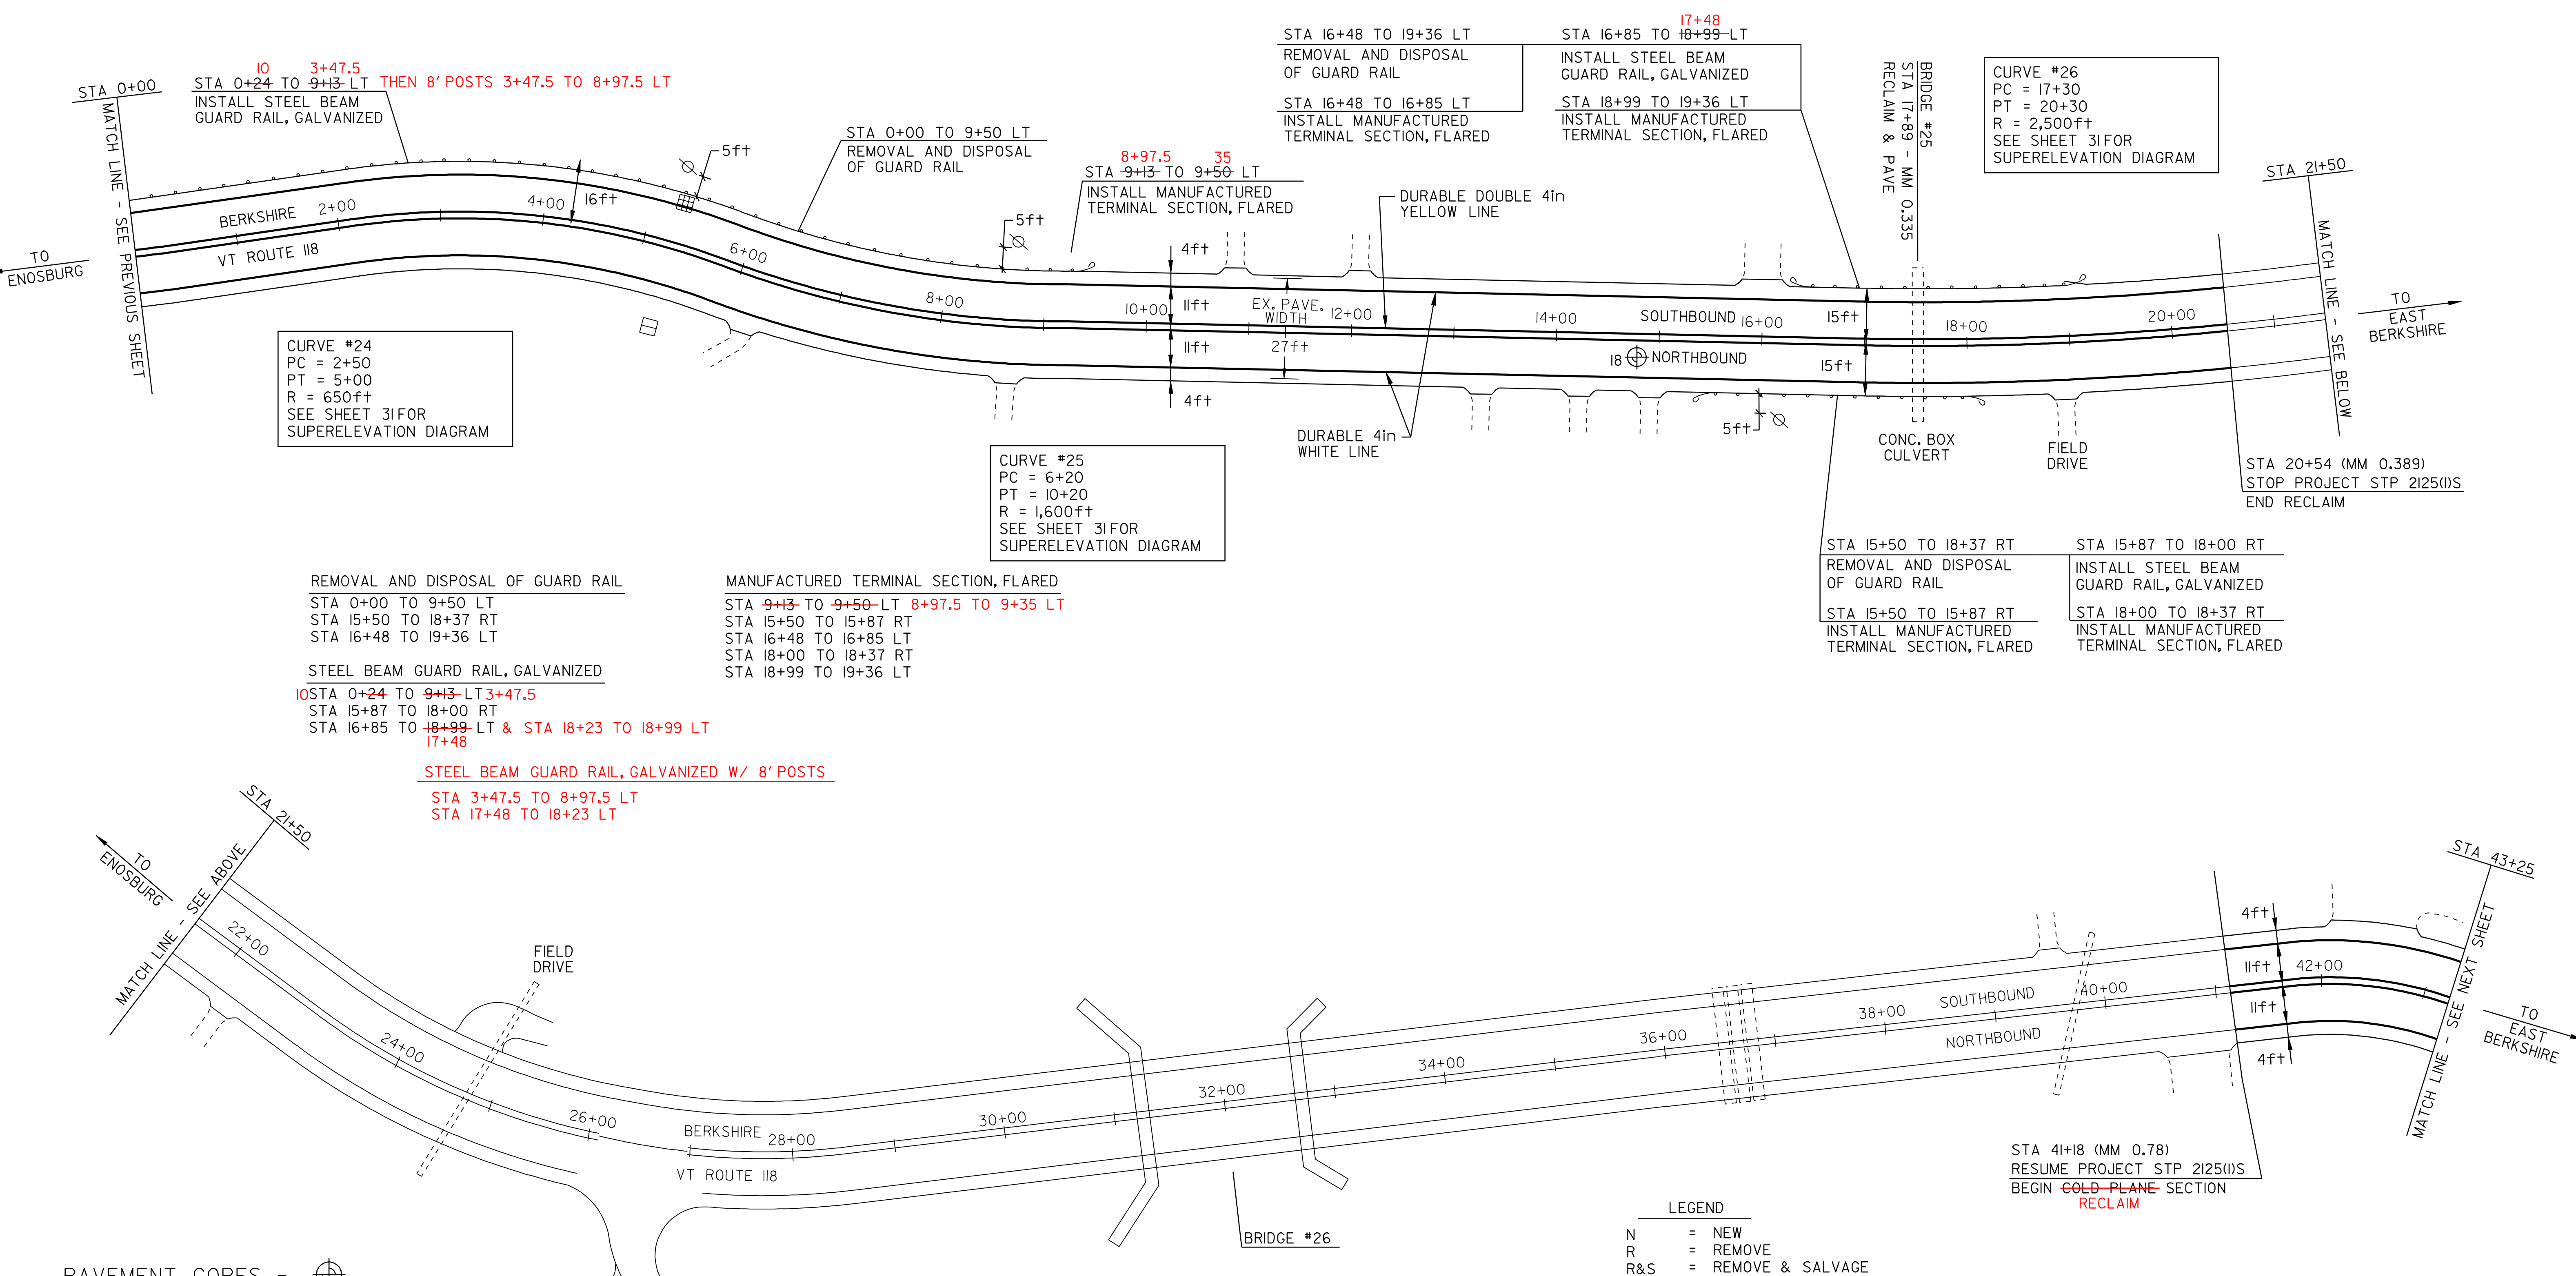

CURVE #24  
 PC = 2+50  
 PT = 5+00  
 R = 650ft  
 SEE SHEET 31 FOR  
 SUPERELEVATION DIAGRAM

CURVE #25  
 PC = 6+20  
 PT = 10+20  
 R = 1,600ft  
 SEE SHEET 31 FOR  
 SUPERELEVATION DIAGRAM

CURVE #26  
 PC = 17+30  
 PT = 20+30  
 R = 2,500ft  
 SEE SHEET 31 FOR  
 SUPERELEVATION DIAGRAM

REMOVAL AND DISPOSAL OF GUARD RAIL  
 STA 0+00 TO 9+50 LT  
 STA 15+50 TO 18+37 RT  
 STA 16+48 TO 19+36 LT

MANUFACTURED TERMINAL SECTION, FLARED  
 STA 9+13 TO 9+50 LT 8+97.5 TO 9+35 LT  
 STA 15+50 TO 15+87 RT  
 STA 16+48 TO 16+85 LT  
 STA 18+00 TO 18+37 RT  
 STA 18+99 TO 19+36 LT

STA 15+50 TO 18+37 RT  
 REMOVAL AND DISPOSAL  
 OF GUARD RAIL  
 STA 15+50 TO 15+87 RT  
 INSTALL MANUFACTURED  
 TERMINAL SECTION, FLARED

STA 15+87 TO 18+00 RT  
 INSTALL STEEL BEAM  
 GUARD RAIL, GALVANIZED  
 STA 18+00 TO 18+37 RT  
 INSTALL MANUFACTURED  
 TERMINAL SECTION, FLARED

STEEL BEAM GUARD RAIL, GALVANIZED  
 STA 0+24 TO 9+13 LT 3+47.5  
 STA 15+87 TO 18+00 RT  
 STA 16+85 TO 18+99 LT & STA 18+23 TO 18+99 LT  
 17+48

STEEL BEAM GUARD RAIL, GALVANIZED W/ 8' POSTS  
 STA 3+47.5 TO 8+97.5 LT  
 STA 17+48 TO 18+23 LT

PAVEMENT CORES -

#	TOTAL DEPTH (In)	SOLID CORE	DRAINABLE BASE	COMMENTS
18	5.0	NO	YES	3" SOLID CORE

NOTE:  
 - NO PCC UNDER ANY CORES  
 - NO CORES OVER ASPHALTED  
 - NO SHOULDER CORES

- LEGEND
- N = NEW
  - R = REMOVE
  - R&S = REMOVE & SALVAGE
  - S = SALVAGE
  - RET = RETAIN
  - B-T-O-B = BACK TO BACK
  - ⊕ □ = CATCH BASIN/DI
  - ⊙ □ = EXISTING THROAT DI
  - I = MARKER POST
  - ⊗ = UTILITY POLE
  - ⊗ ⊕ = UTIL. POLE W/UNDERGROUND UTIL.
  - - - = DRIVE

## PAVING PROJECT LAYOUT SHEET #11

DESIGNED BY	BCE/PJM	DATE	6-06
DRAWN BY	C.E.A., INC.	DATE	6-06
DESIGN FILE NO.	p98c182.dgn		
PRF FILE	p98c182III.i	DATE PLOTTED	10-FEB-2010 14:
PROJ. NAME	MONTGOMERY - BERKSHIRE		
PROJ. NO.	STP 2125(1)S		
SHEET	21	OF	41 SHEETS