
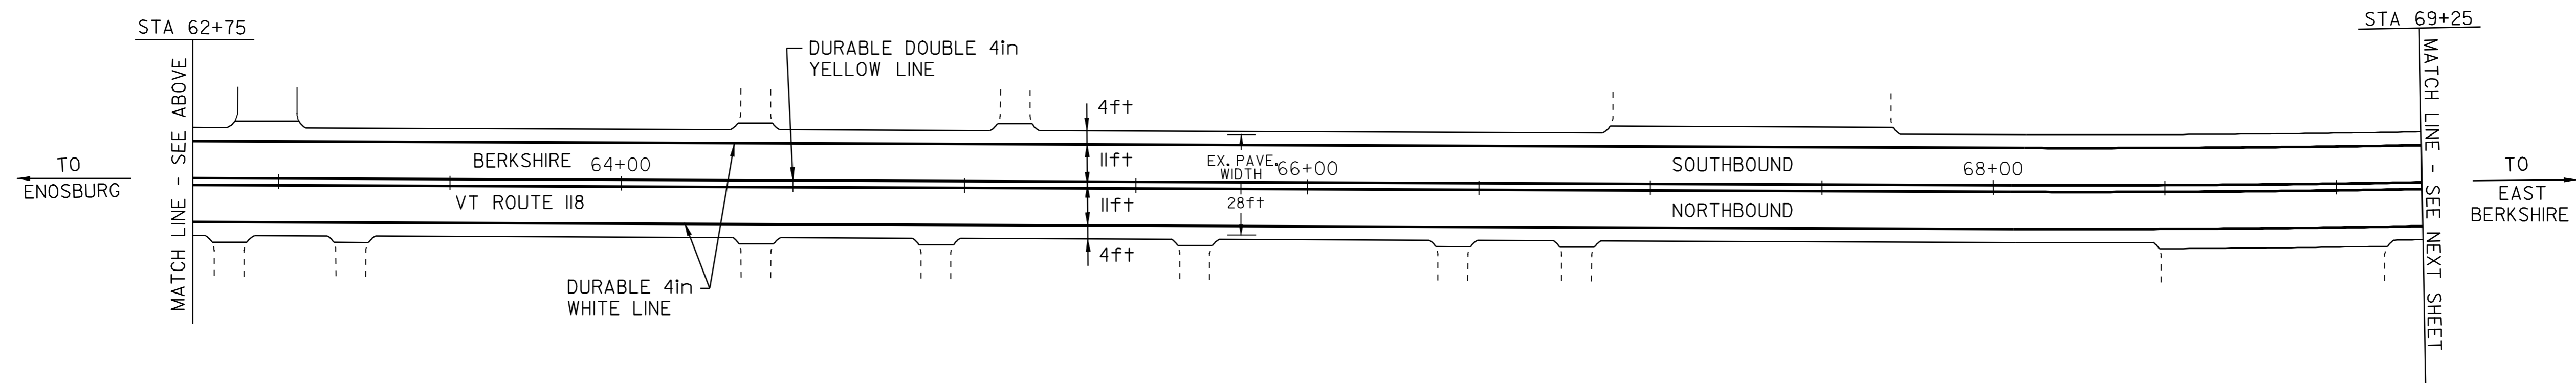


TEMPORARY AND DURABLE 4in YELLOW LINE
 STA 56+25 TO 69+25 SOLID LT&RT

DITCHING LOCATIONS (REFER TO SHEET 10 FOR DETAILS)
 STA ~~68+50~~ TO 69+25 LT
 67+72

TEMPORARY AND DURABLE 4in WHITE LINE
 STA 56+25 TO 69+25 SOLID LT&RT

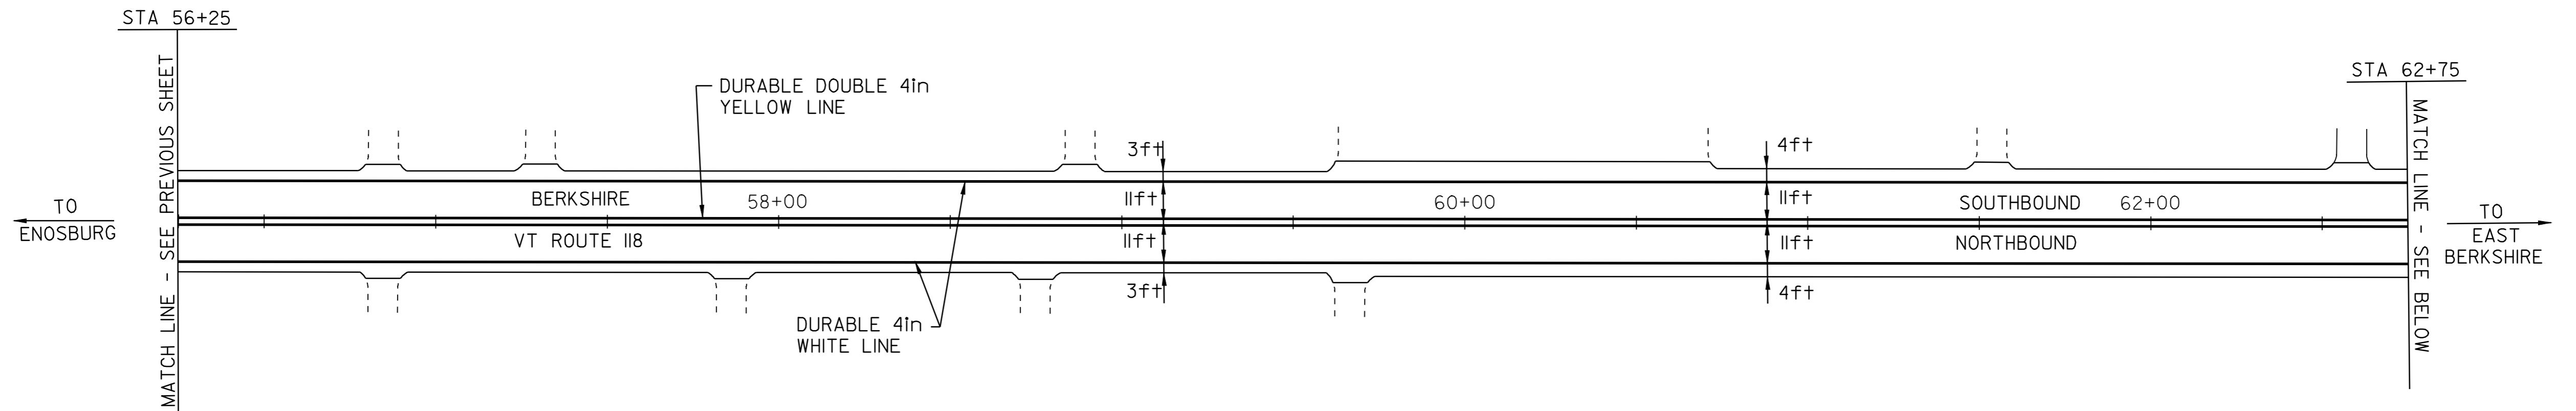

- LEGEND**
- N = NEW
 - R = REMOVE
 - R&S = REMOVE & SALVAGE
 - S = SALVAGE
 - RET = RETAIN
 - B-TO-B = BACK TO BACK
 - ⊕ □ CATCH BASIN/DI
 - ⊙ □ EXISTING THROAT DI
 - I MARKER POST
 - ⊗ UTIL. POLE
 - ⊗ UTIL. POLE W/UNDERGROUND UTIL.
 - - - DRIVE

<h1>PAVING PROJECT LAYOUT SHEET #13</h1>	DESIGNED BY	BCE/PJM	DATE	6-06
	DRAWN BY	C.E.A., INC.	DATE	6-06
	DESIGN FILE NO.	p98cl82.dgn		
	PRF FILE	p98cl82i3.1	DATE PLOTTED	10-FEB-2010 14:44
	PROJ. NAME	MONTGOMERY - BERKSHIRE		
PROJ. NO.	STP 2125(1)S			
SHEET	23	OF	41	SHEETS