

SIGN LEGEND

- N = NEW
- R = REMOVE
- S = SALVAGE
- RET = RETAIN
- R & S = REMOVE & SALVAGE

DURABLE 100mm WHITE LINE, THERMOPLASTIC
0+000 - 0+700 SOLID LT. & SOLID RT.

DURABLE 100mm YELLOW LINE, THERMOPLASTIC
0+000 - 0+700 SOLID LT. & SOLID RT.

TEMPORARY 100mm WHITE LINE, PAINT
0+000 - 0+700 SOLID LT. & SOLID RT.

TEMPORARY 100mm YELLOW LINE, PAINT
0+000 - 0+700 SOLID LT. & SOLID RT.


DURABLE 600mm STOP BAR, THERMOPLASTIC
0+024 RT.

DURABLE LETTER OR SYMBOL, THERMOPLASTIC
0+024 RT. (S,T,O,P) (4 EA.)

TEMPORARY 600mm STOP BAR, PAINT
0+024 RT.

TEMPORARY LETTER OR SYMBOL, PAINT
0+024 RT. (S,T,O,P) (4 EA.)

BEGIN PROJECT IN MASS
VERNON M.M. 0.000
STA. 0+000
-0+015.5

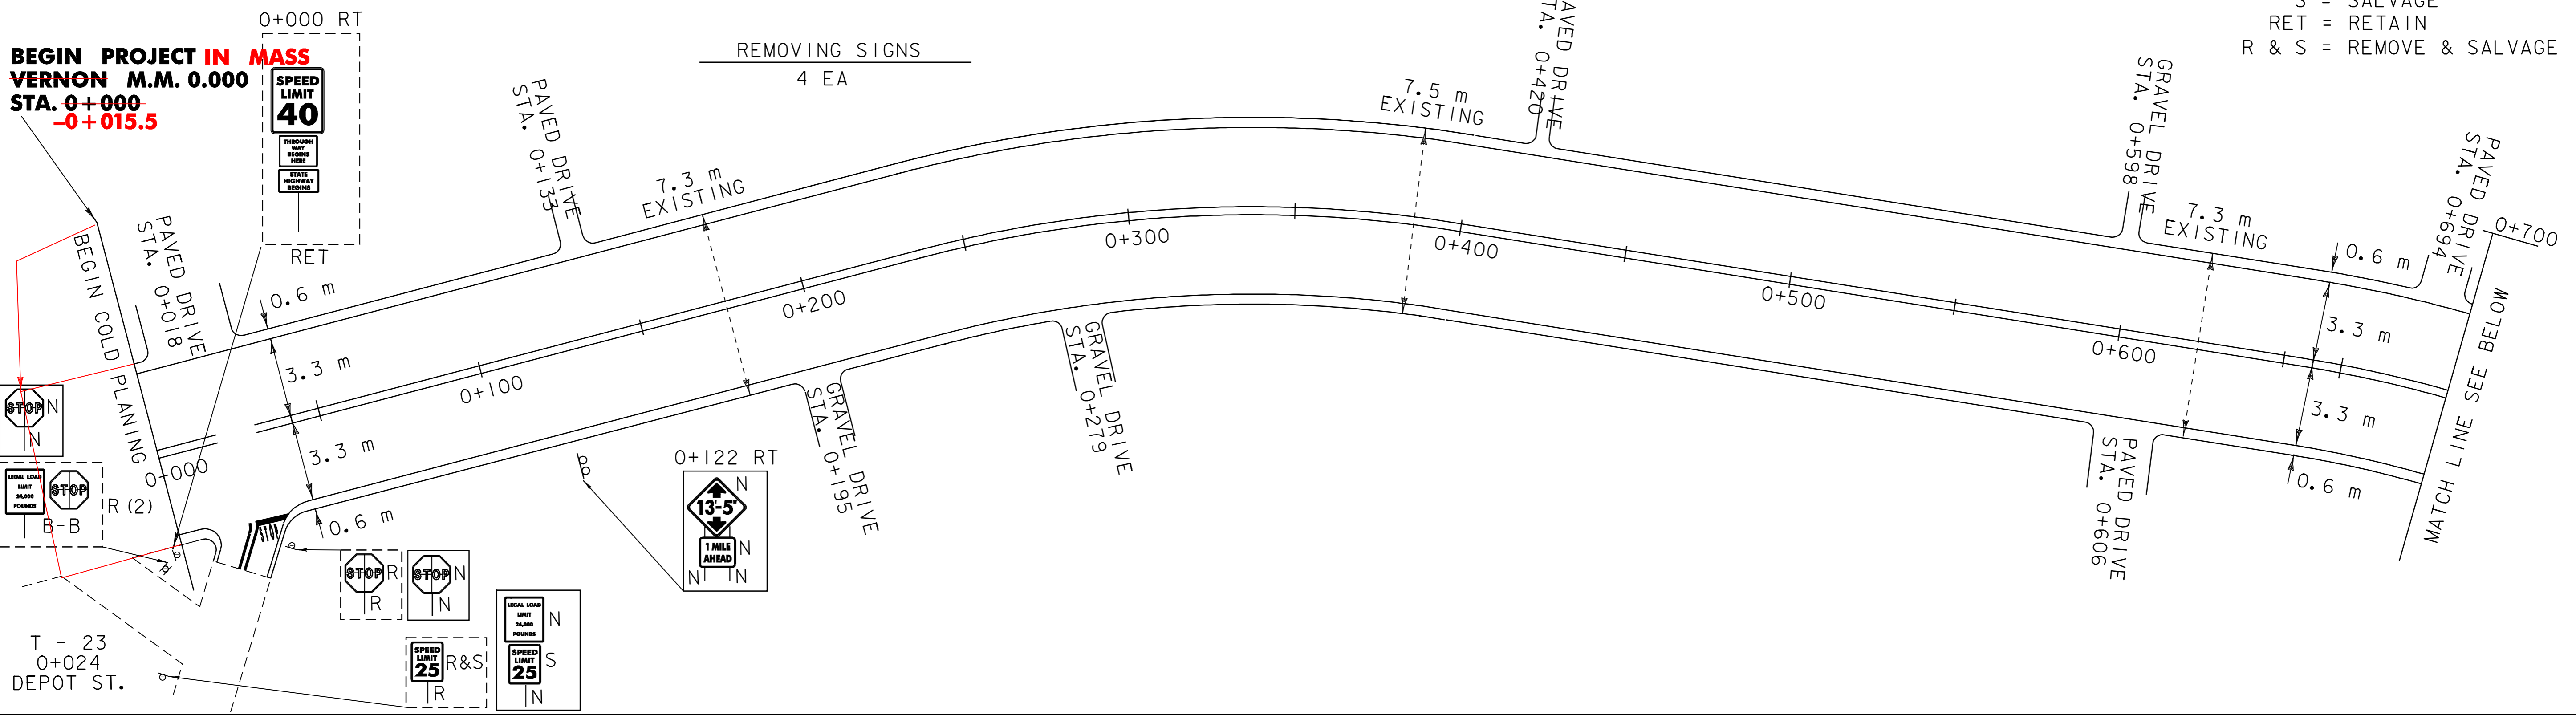

STEEL BEAM GUARDRAIL, GALVANIZED
0+907 LT. (2 - 4.88 m radius panels)
0+907 - 0+922 LT.
0+907 - 0+930 RT.

DURABLE 100mm WHITE LINE, THERMOPLASTIC
0+700 - 1+400 SOLID LT. & SOLID RT.

DURABLE 600mm STOP BAR, THERMOPLASTIC
1+280 LT.

REMOVING SIGNS
3 EA

MANUFACTURED TERMINAL SECTION, FLARED
0+895.6 - 0+907 RT. (1 EA.)
0+922 - 0+933.4 LT. (1 EA.)
~~0+930 - 0+941.4 RT. (1 EA.)~~

TEMPORARY 100mm WHITE LINE, PAINT
0+700 - 1+400 SOLID LT. & SOLID RT.

TEMPORARY 600mm STOP BAR, PAINT
1+280 LT.

DURABLE 100mm YELLOW LINE, THERMOPLASTIC
0+700 - 1+400 SOLID LT. & SOLID RT.


DURABLE LETTER OR SYMBOL, THERMOPLASTIC
1+280 LT. (S,T,O,P) (4 EA.)

ANCHOR FOR STEEL BEAM GUARD RAIL
0+907 LT. (2 EA.) **0+938 RT. (1 EA.)**

TEMPORARY 100mm YELLOW LINE, PAINT
0+700 - 1+400 SOLID LT. & SOLID RT.

TEMPORARY LETTER OR SYMBOL, PAINT
1+280 LT. (S,T,O,P) (4 EA.)

REMOVAL AND DISPOSAL OF GUARD RAIL
0+907 - 0+930 RT.

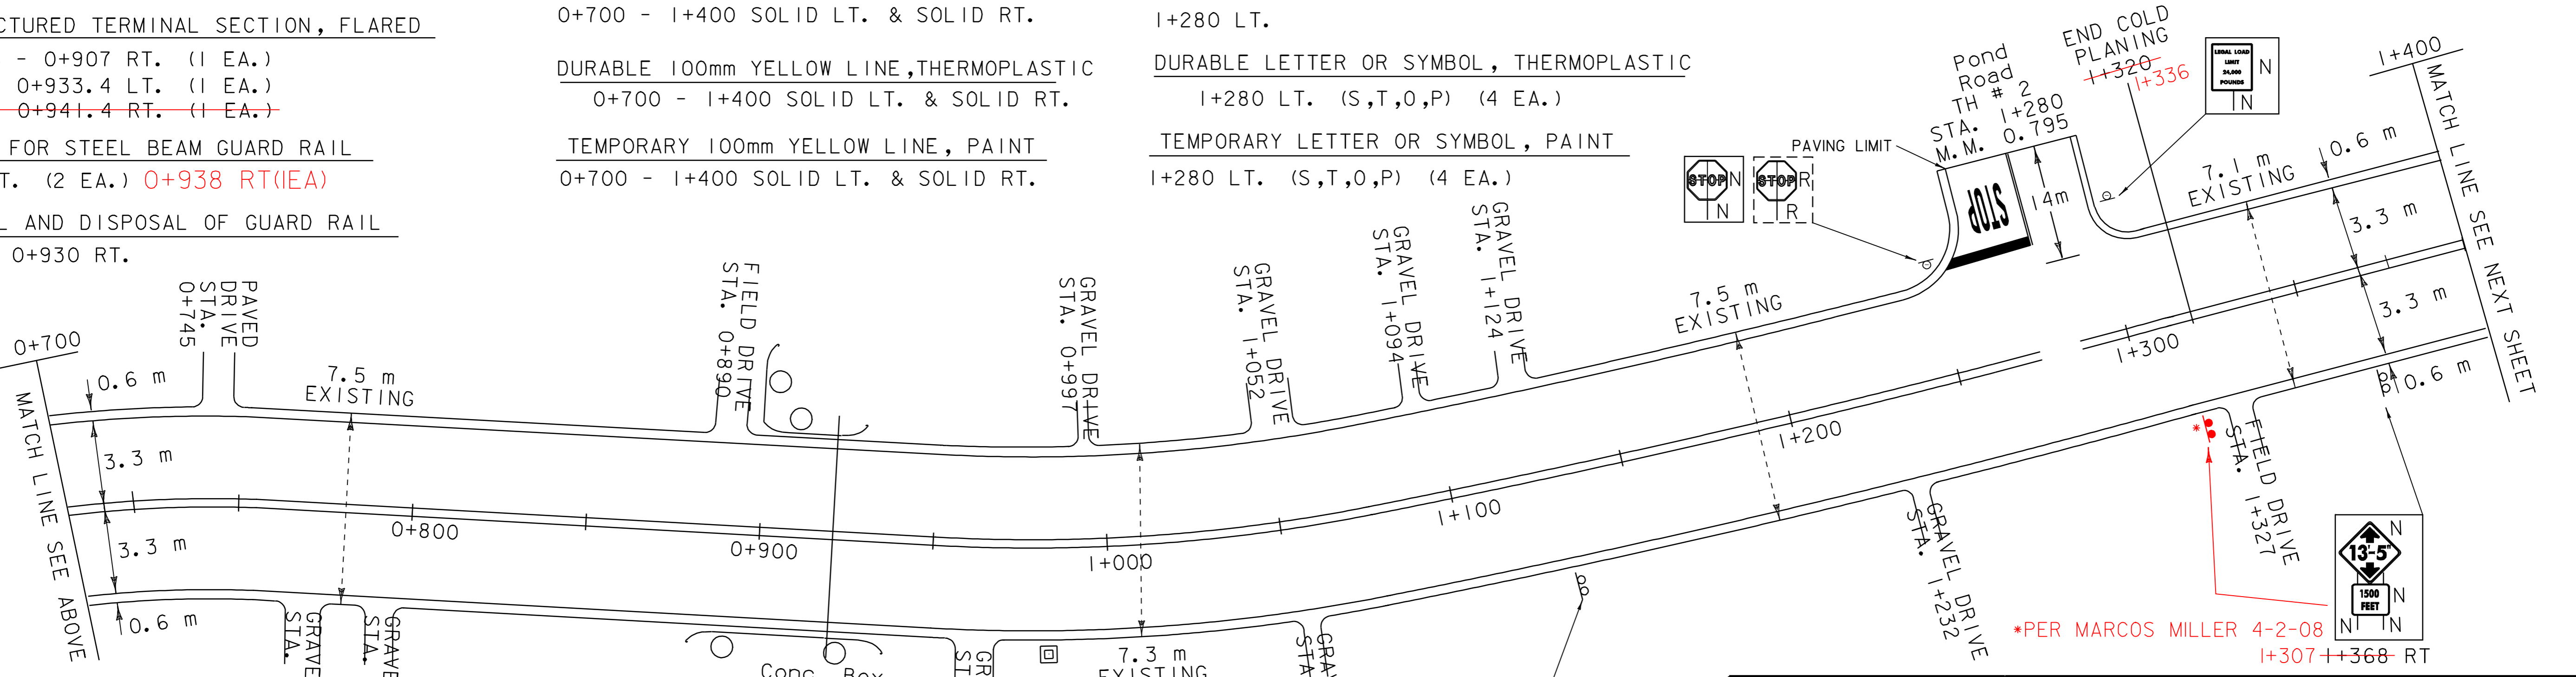

PROJECT LAYOUT SHEET
1

PROJECT NAME:	VERNON - BRATTLEBORO
PROJECT NUMBER:	AC STP 2126(1)S
FILE NAME:	zpqve298cl84\pcl84.dgn
PROJECT LEADER:	WILDER
IPARM NAME:	pcl84i01
PLOT DATE:	08-SEP-2009 13:3
DRAWN BY:	WILDER
CHECKED BY:	PAVI_MGM
SHEET	12 OF 33