

DURABLE 100mm WHITE LINE, THERMOPLASTIC  
2+800 - 3+500 SOLID LT. & SOLID RT.

DURABLE 100mm YELLOW LINE, THERMOPLASTIC  
2+800 - 3+009 SOLID LT. & SOLID RT.  
3+009 - 3+259 SOLID LT. & DASH RT.  
3+259 - 3+500 SOLID LT. & SOLID RT.

TEMPORARY 100mm WHITE LINE, PAINT  
2+800 - 3+500 SOLID LT. & SOLID RT.

TEMPORARY 100mm YELLOW LINE, PAINT  
2+800 - 3+009 SOLID LT. & SOLID RT.  
3+009 - 3+259 SOLID LT. & DASH RT.  
3+259 - 3+500 SOLID LT. & SOLID RT.


DURABLE 600mm STOP BAR, THERMOPLASTIC  
3+411 LT.

DURABLE LETTER OR SYMBOL, THERMOPLASTIC  
3+411 LT. (S,T,O,P) (4 EA.)

REMOVING SIGNS  
4 EA

TEMPORARY 600mm STOP BAR, PAINT  
3+411 LT.

TEMPORARY LETTER OR SYMBOL, PAINT  
3+411 LT. (S,T,O,P) (4 EA.)

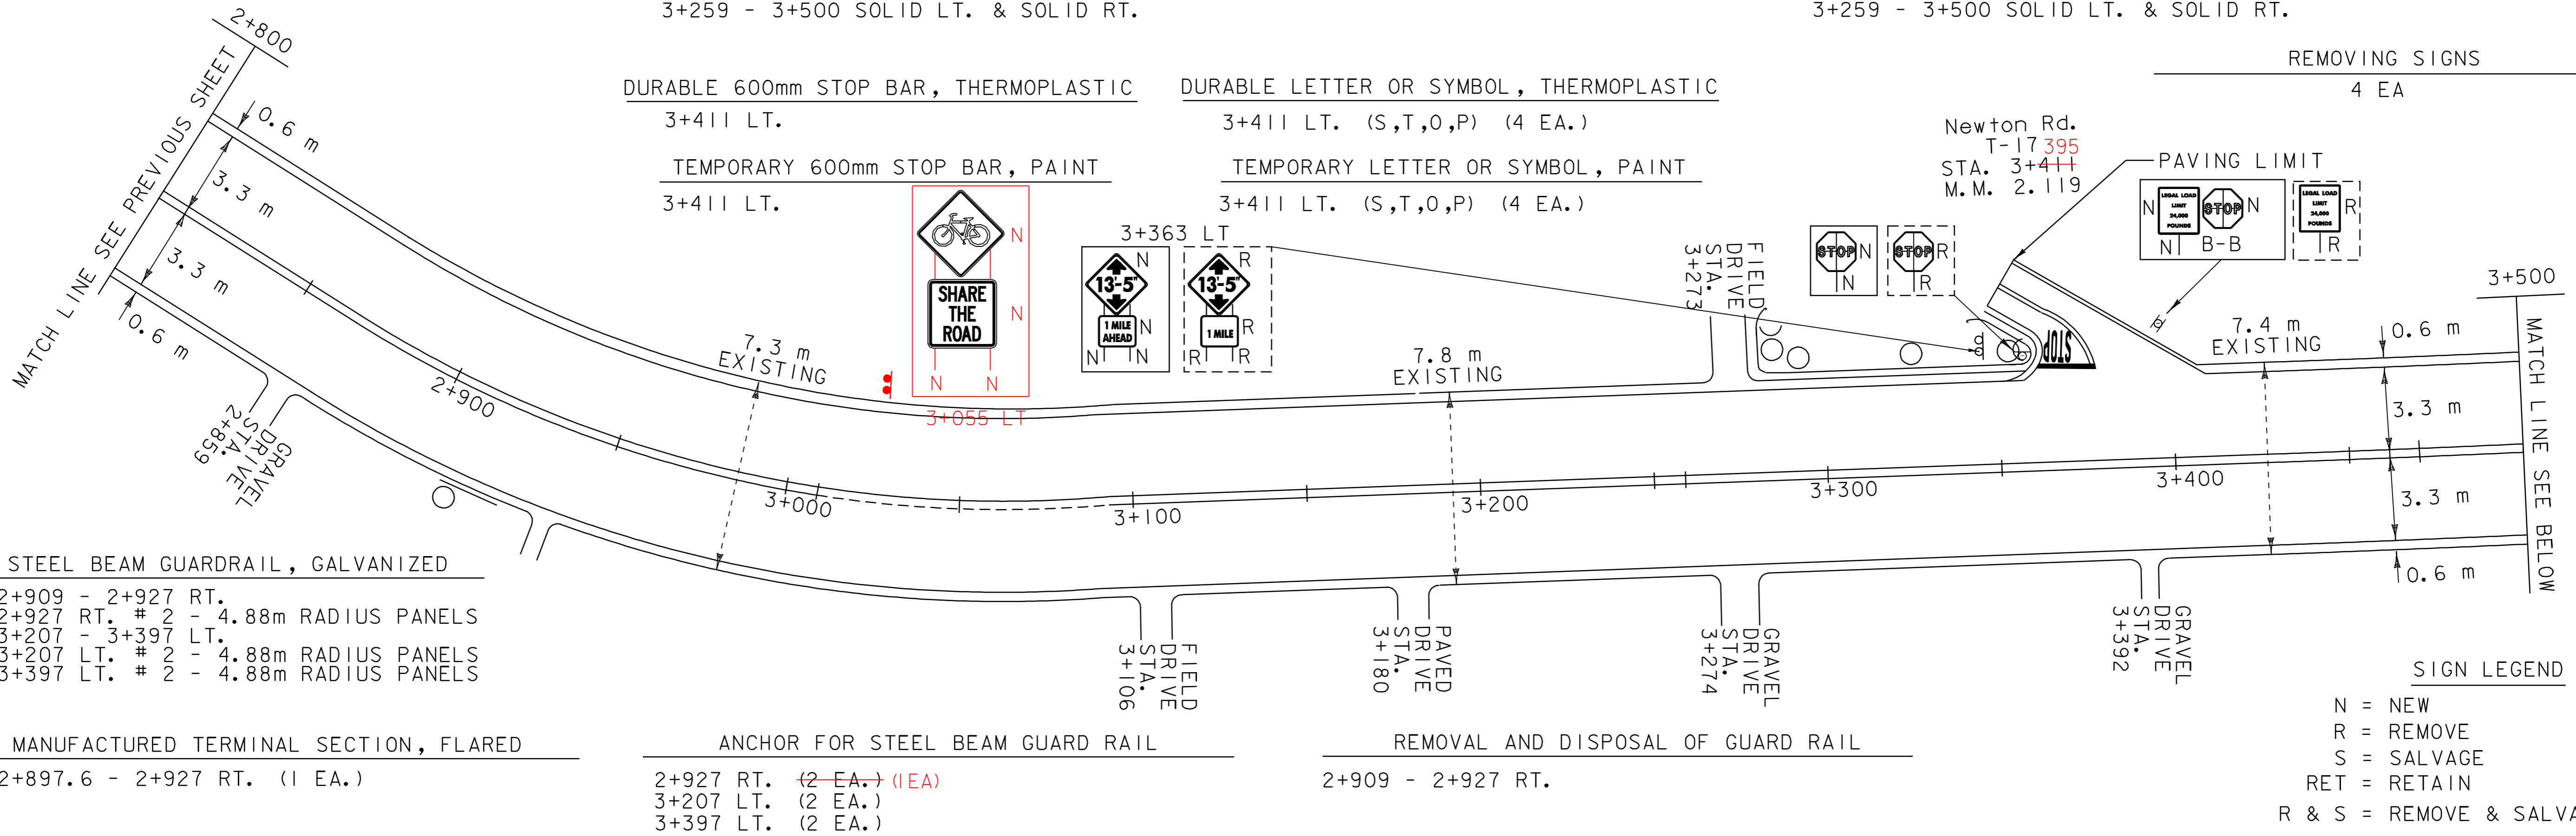

SIGN LEGEND  
N = NEW  
R = REMOVE  
S = SALVAGE  
RET = RETAIN  
R & S = REMOVE & SALVAGE

DURABLE 100mm WHITE LINE, THERMOPLASTIC  
3+500 - 4+200 SOLID LT. & SOLID RT.

DURABLE 100mm YELLOW LINE, THERMOPLASTIC  
3+500 - 3+556 SOLID LT. & SOLID RT.  
3+556 - 3+798 SOLID LT. & DASH RT.  
3+798 - 3+894 DASH  
3+894 - 4+200 SOLID LT. & SOLID RT.

TEMPORARY 100mm WHITE LINE, PAINT  
3+500 - 4+200 SOLID LT. & SOLID RT.

TEMPORARY 100mm YELLOW LINE, PAINT  
3+500 - 3+556 SOLID LT. & SOLID RT.  
3+556 - 3+798 SOLID LT. & DASH RT.  
3+798 - 3+894 DASH  
3+894 - 4+200 SOLID LT. & SOLID RT.


DURABLE 600mm STOP BAR, THERMOPLASTIC  
4+035 RT.

DURABLE LETTER OR SYMBOL, THERMOPLASTIC  
4+035 RT. (S,T,O,P) (4 EA.)

REMOVING SIGNS  
4 EA

TEMPORARY 600mm STOP BAR, PAINT  
4+035 RT.

TEMPORARY LETTER OR SYMBOL, PAINT  
4+035 RT. (S,T,O,P) (4 EA.)

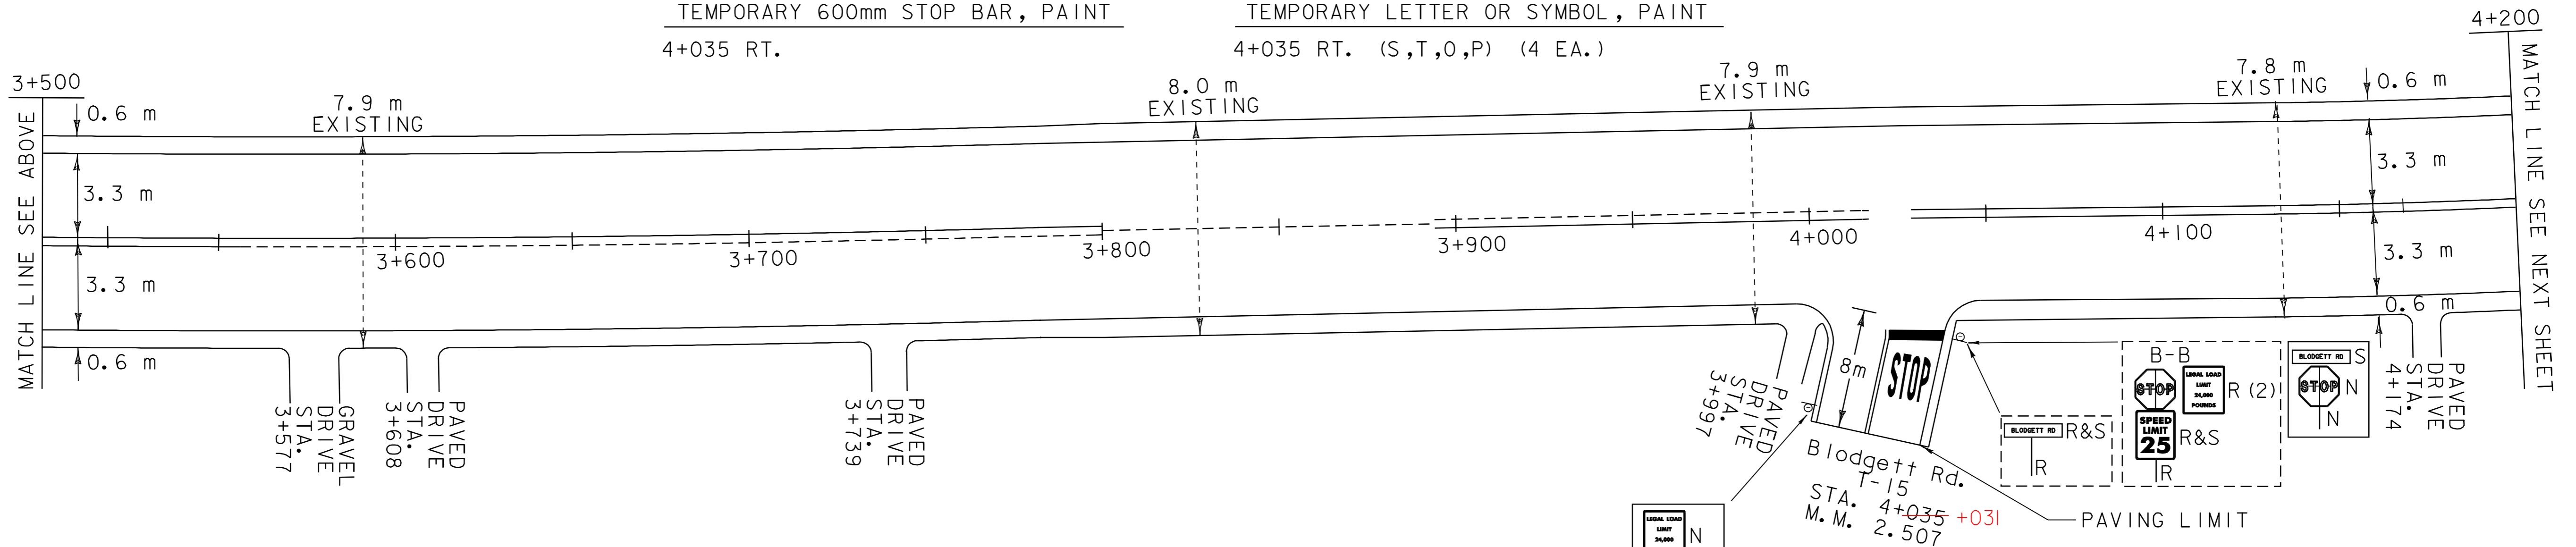

LEGAL LOAD LIMIT 24,000 POUNDS  
SPEED LIMIT 25  
N  
S  
IN

**PROJECT LAYOUT SHEET**  
**# 3**

PROJECT NAME: **VERNON - BRATTLEBORO**  
PROJECT NUMBER: **AC STP 2126(1)S**  
FILE NAME: Z:\pave\98\cl84\pcl84.dgn PLOT DATE: 08-SEP-2009 13:3  
PROJECT LEADER: DRAWN BY: WILDER  
IPARM NAME: pci8403.1 CHECKED BY: PAVI.MGM  
SHEET 14 OF 33