

DURABLE 100mm WHITE LINE, THERMOPLASTIC
4+200 - 4+900 SOLID LT. & SOLID RT.

DURABLE 100mm YELLOW LINE, THERMOPLASTIC
4+200 - 4+900 SOLID LT. & SOLID RT.

TEMPORARY 100mm WHITE LINE, PAINT
4+200 - 4+900 SOLID LT. & SOLID RT.


TEMPORARY 100mm YELLOW LINE, PAINT
4+200 - 4+900 SOLID LT. & SOLID RT.

DURABLE 600mm STOP BAR, THERMOPLASTIC
4+582 RT.

DURABLE LETTER OR SYMBOL, THERMOPLASTIC
4+582 RT. (S,T,O,P) (4 EA.)

TEMPORARY 600mm STOP BAR, PAINT
4+582 RT.

TEMPORARY LETTER OR SYMBOL, PAINT
4+582 RT. (S,T,O,P) (4 EA.)

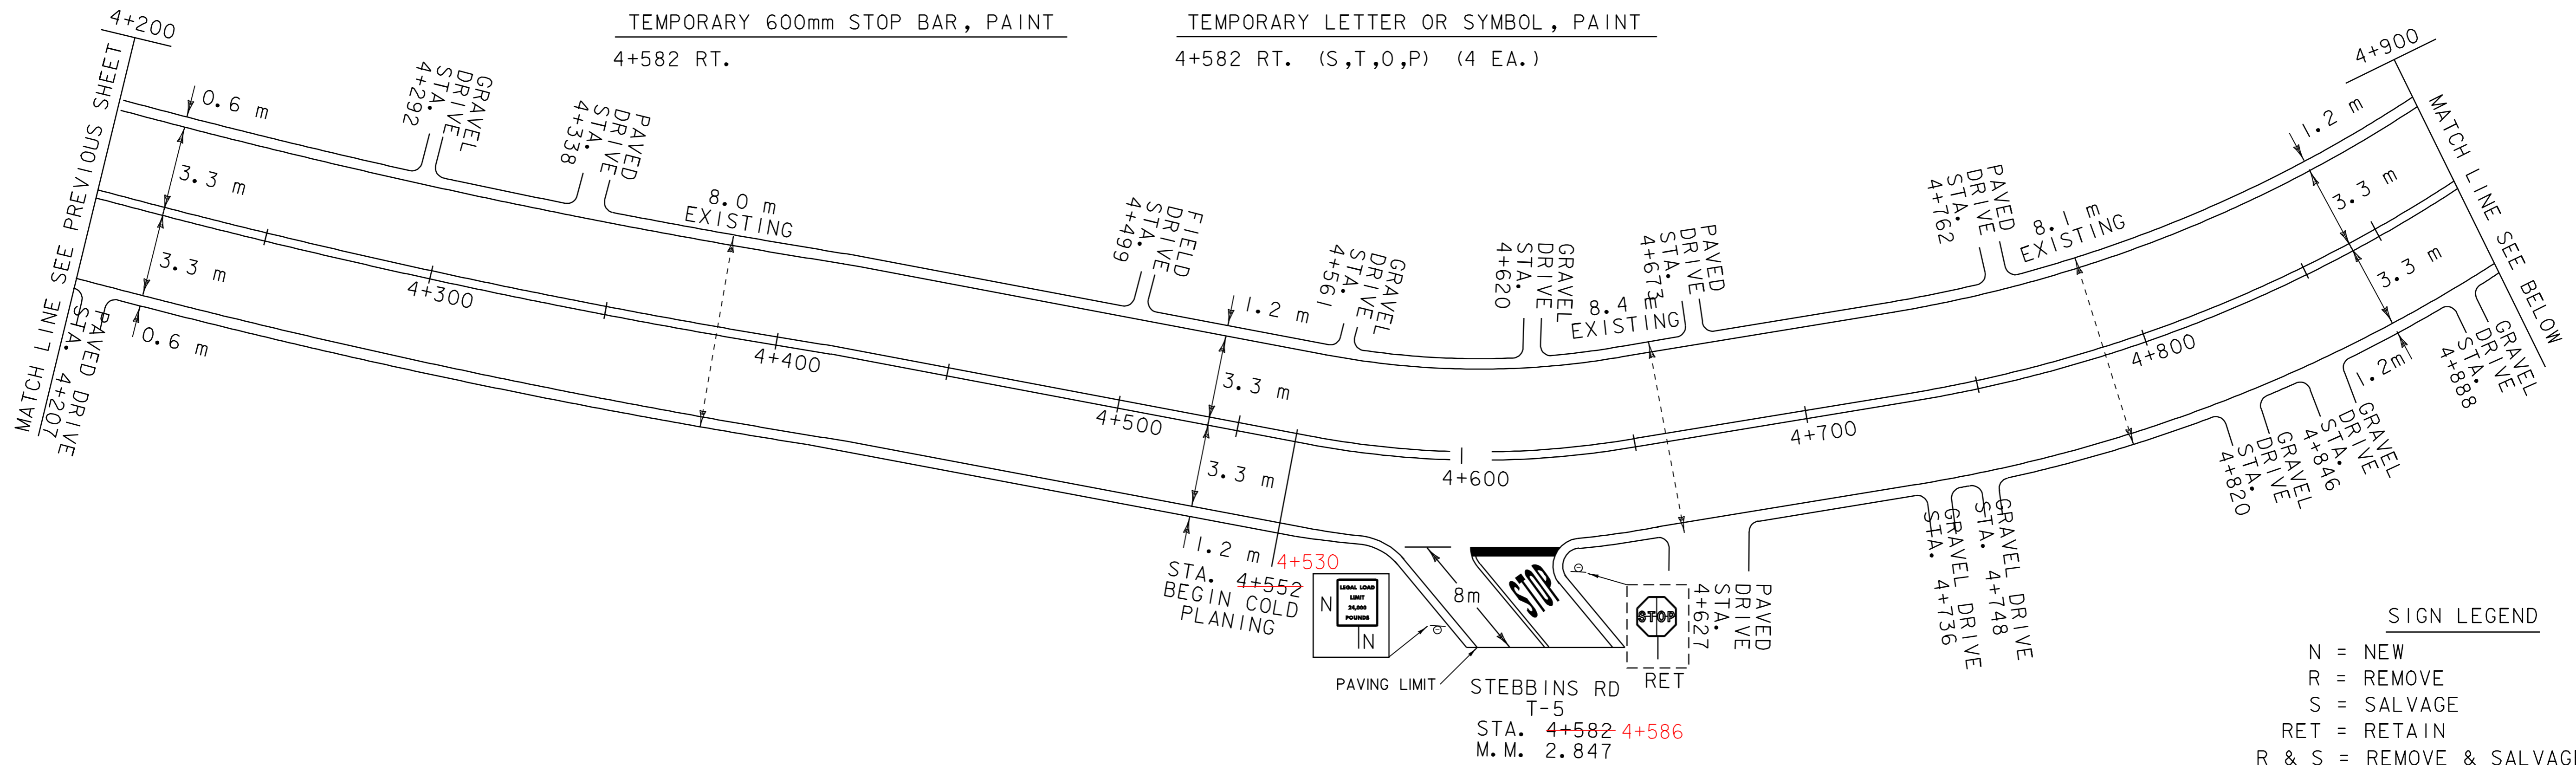

SIGN LEGEND


- N = NEW
- R = REMOVE
- S = SALVAGE
- RET = RETAIN
- R & S = REMOVE & SALVAGE

DURABLE 100mm WHITE LINE, THERMOPLASTIC
4+900 - 5+600 SOLID LT. & SOLID RT.

TEMPORARY 100mm WHITE LINE, PAINT
4+900 - 5+600 SOLID LT. & SOLID RT.

TEMPORARY 100mm YELLOW LINE, PAINT
4+900 - 5+600 SOLID LT. & SOLID RT.

DURABLE 100mm YELLOW LINE, THERMOPLASTIC
4+900 - 5+600 SOLID LT. & SOLID RT.

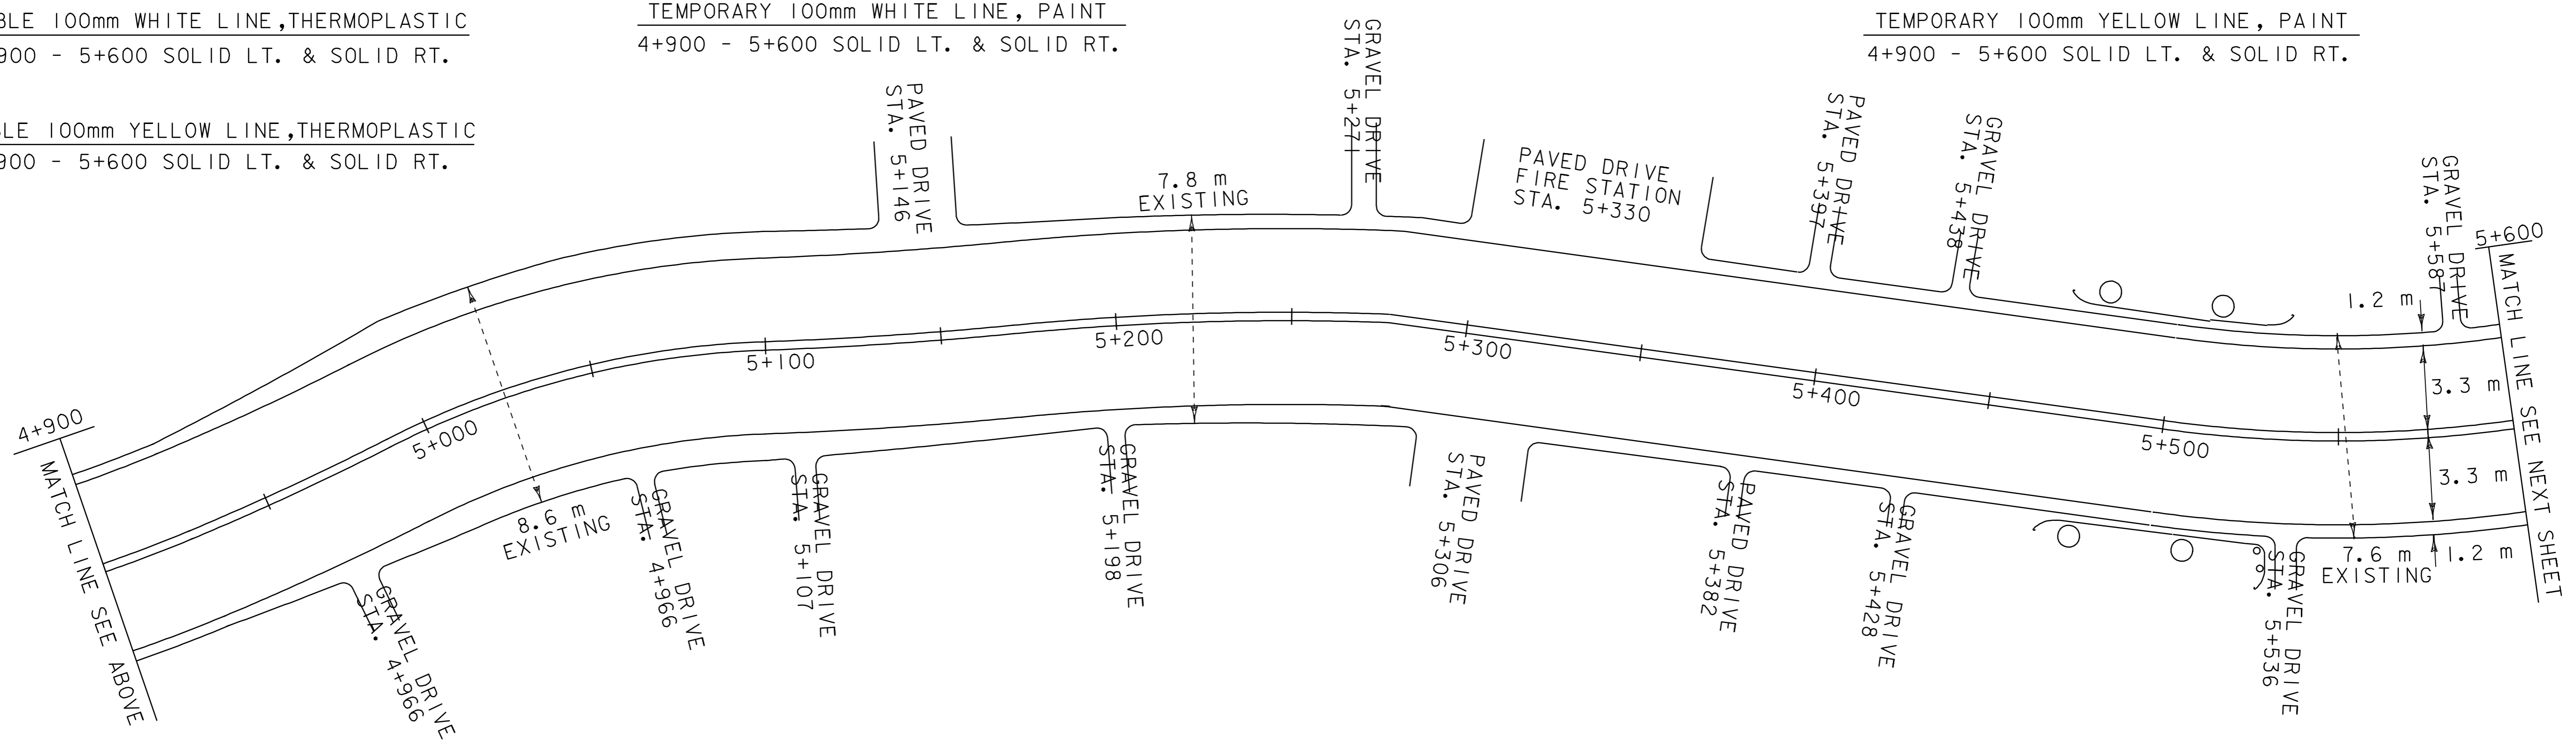

STEEL BEAM GUARDRAIL, GALVANIZED
5+488 - 5+527 LT.

ANCHOR FOR STEEL BEAM GUARD RAIL
5+475 RT.
5+528 RT.
5+488 LT.
5+527 LT. (~~BURY IN BACKSLOPE~~)

REMOVAL AND DISPOSAL OF GUARD RAIL
5+488 - 5+527 LT.
5+489 - 5+525 RT.

STEEL BEAM GUARDRAIL, GALVANIZED W/2.4 M POSTS
5+475 - 5+528 RT.

PROJECT LAYOUT SHEET
4

PROJECT NAME:	VERNON - BRATTLEBORO		
PROJECT NUMBER:	AC STP 2126(1)S		
FILE NAME:	zpqve298cl84\pci84.dgn	PLOT DATE:	08-SEP-2009 13:3
PROJECT LEADER:		DRAWN BY:	WILDER
IPARM NAME:	pci84104.i	CHECKED BY:	PAVI_MGMI
		SHEET	15 OF 33