

DURABLE 100mm WHITE LINE, THERMOPLASTIC  
5+600 - 6+200 SOLID LT. & SOLID RT.

DURABLE 100mm YELLOW LINE, THERMOPLASTIC  
5+600 - 6+200 SOLID LT. & SOLID RT.

TEMPORARY 100mm WHITE LINE, PAINT  
5+600 - 6+200 SOLID LT. & SOLID RT.

TEMPORARY 100mm YELLOW LINE, PAINT  
5+600 - 6+200 SOLID LT. & SOLID RT.

DURABLE 600mm STOP BAR, THERMOPLASTIC  
5+681 RT.

DURABLE LETTER OR SYMBOL, THERMOPLASTIC  
5+681 RT. (S,T,O,P) (4 EA.)

DURABLE 600mm STOP BAR, THERMOPLASTIC  
5+681 RT.

DURABLE LETTER OR SYMBOL, THERMOPLASTIC  
5+681 RT. (S,T,O,P) (4 EA.)


TEMPORARY 600mm STOP BAR, PAINT  
5+681 RT.

TEMPORARY LETTER OR SYMBOL, PAINT  
5+681 RT. (S,T,O,P) (4 EA.)

TEMPORARY 600mm STOP BAR, PAINT  
5+681 RT.

TEMPORARY LETTER OR SYMBOL, PAINT  
5+681 RT. (S,T,O,P) (4 EA.)

**SIGN LEGEND**  
N = NEW  
R = REMOVE  
S = SALVAGE  
RET = RETAIN  
R&S = REMOVE & SALVAGE

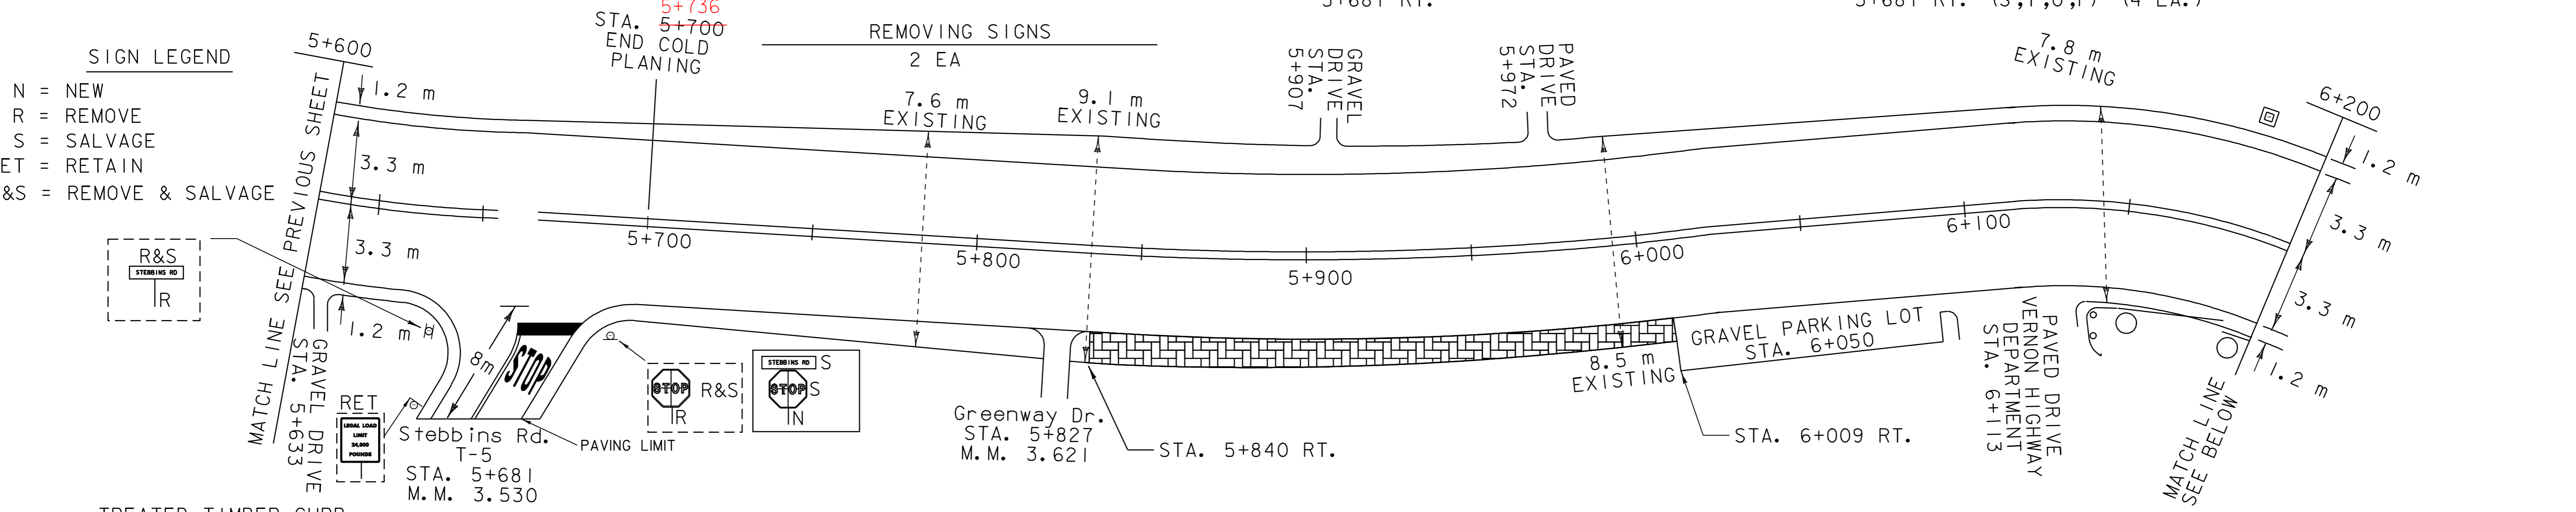

TREATED TIMBER CURB  
~~6+131 - 6+200 RT~~  
~~6+156~~

~~REHABING DI, CB, OR MH CLASS I~~  
~~6+181 LT. (1 EA.)~~

SPECIAL PROVISION, IMPRINTED/COLORIZED SURFACE  
~~STA. 5+840 - 6+009 RT. (195 SM)~~  
~~5+852~5+998~~

STEEL BEAM GUARDRAIL, GALVANIZED  
6+131 RT 2 - 4.88m RADIUS PANELS

STEEL BEAM GUARDRAIL, GALVANIZED W/2.4 M POSTS  
6+131 - 6+200 RT.

ANCHOR FOR STEEL BEAM GUARD RAIL  
6+131 RT. (2 EA.)

REMOVAL AND DISPOSAL OF GUARD RAIL  
6+131 - 6+200 RT.

DURABLE 100mm WHITE LINE, THERMOPLASTIC  
6+200 - 6+900 SOLID LT. & SOLID RT.

DURABLE 100mm YELLOW LINE, THERMOPLASTIC  
6+200 - 6+900 SOLID LT. & SOLID RT.

TEMPORARY 100mm WHITE LINE, PAINT  
6+200 - 6+900 SOLID LT. & SOLID RT.

TEMPORARY 100mm YELLOW LINE, PAINT  
6+200 - 6+900 SOLID LT. & SOLID RT.

DURABLE 600mm STOP BAR, THERMOPLASTIC  
6+302 RT.  
6+881 RT.

DURABLE LETTER OR SYMBOL, THERMOPLASTIC  
6+302 RT. (S,T,O,P) (4 EA.)  
6+881 RT. (S,T,O,P) (4 EA.)


604.412 : REHABING DI, CB, OR MH CLASS I  
6+216 RT. (1 EA.)  
~~6+232 LT. (1 EA.)~~  
~~6+254 LT. (1 EA.)~~  
6+265

~~CHANGING ELEVATION OF SEWER MANHOLE~~  
~~6+795 RT. (1 EA.)~~

203.28: EXCAVATION OF SURFACES AND PAVEMENTS\*  
STA 6+900(20.4CM)  
\* THIS WAS DONE AT THE TOWN'S REQUEST

TEMPORARY 600mm STOP BAR, PAINT  
6+302 RT.  
6+881 RT.

TEMPORARY LETTER OR SYMBOL, PAINT  
6+302 RT. (S,T,O,P) (4 EA.)  
6+881 RT. (S,T,O,P) (4 EA.)

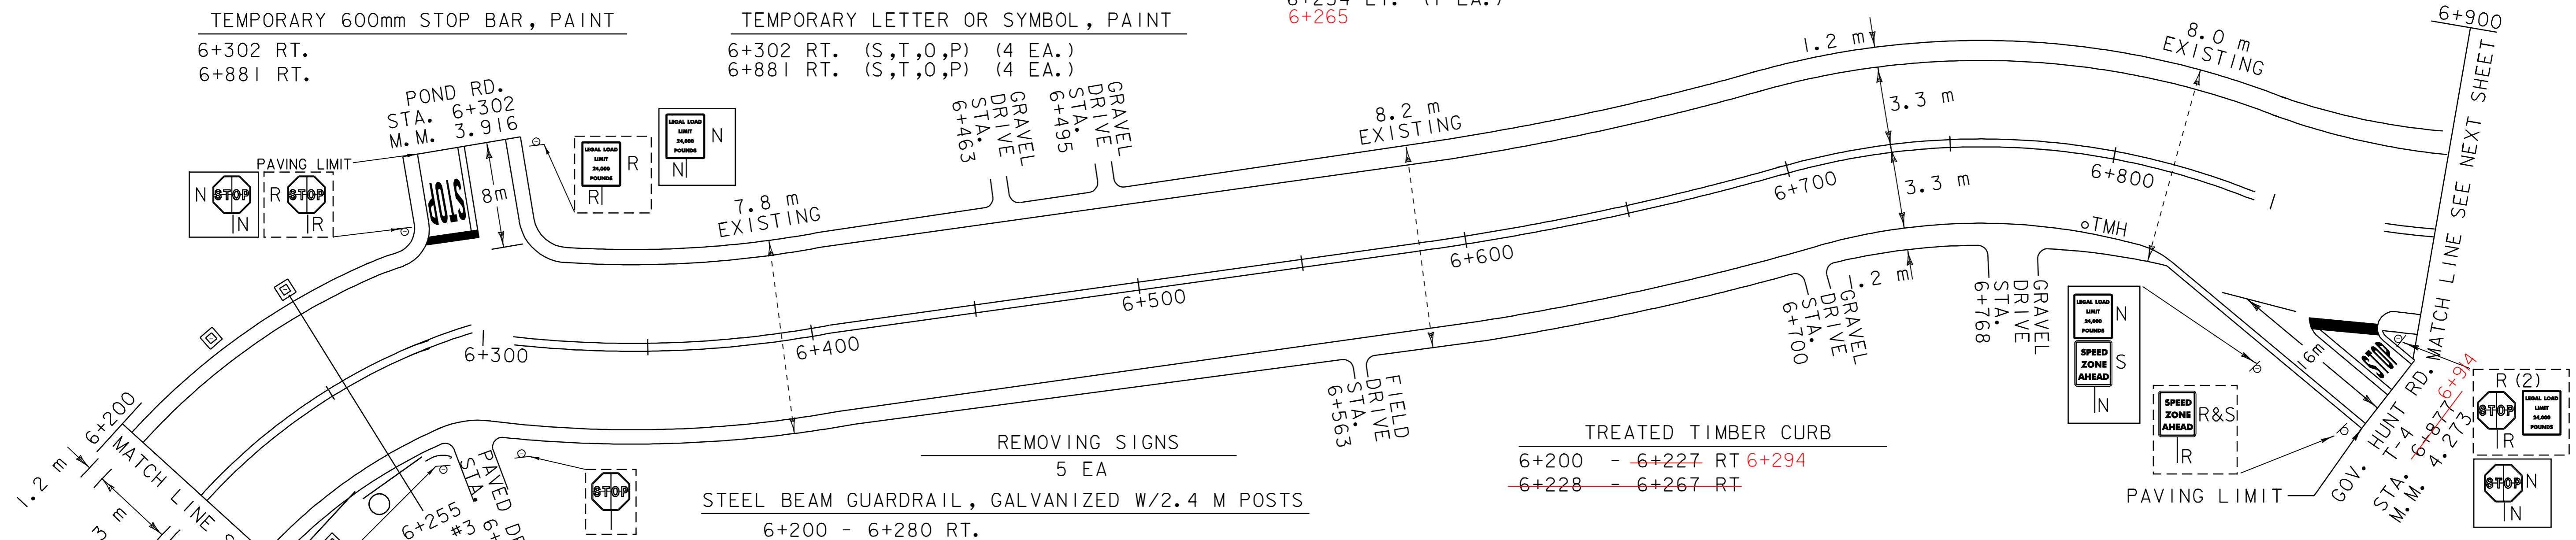

TREATED TIMBER CURB  
~~6+200 - 6+227 RT~~  
~~6+228 - 6+267 RT~~

REMOVING SIGNS  
5 EA

STEEL BEAM GUARDRAIL, GALVANIZED W/2.4 M POSTS  
6+200 - 6+280 RT.

ANCHOR FOR STEEL BEAM GUARD RAIL  
6+280 RT.

REMOVAL AND DISPOSAL OF GUARD RAIL  
6+200 - 6+280 RT.

**SIGN LEGEND**  
N = NEW  
R = REMOVE  
S = SALVAGE  
R & S = REMOVE & SALVAGE

**PROJECT LAYOUT SHEET**  
# 5

PROJECT NAME: **VERNON - BRATTLEBORO**  
PROJECT NUMBER: **AC STP 2126(1)S**  
FILE NAME: zpqve\98cl84\pcl84.dgn PLOT DATE: 08-SEP-2009 13:3  
PROJECT LEADER: \_\_\_\_\_ DRAWN BY: WILDER  
IPARM NAME: pci8405.1 CHECKED BY: PAVI.MGM  
SHEET 16 OF 33