

DURABLE 100mm WHITE LINE, THERMOPLASTIC
6+900 - 7+600 SOLID LT. & SOLID RT.

DURABLE 100mm YELLOW LINE, THERMOPLASTIC
6+900 - 7+600 SOLID LT. & SOLID RT.

TEMPORARY 100mm WHITE LINE, PAINT
6+900 - 7+600 SOLID LT. & SOLID RT.

TEMPORARY 100mm YELLOW LINE, PAINT
6+900 - 7+600 SOLID LT. & SOLID RT.

SIGN LEGEND

- N = NEW
- R = REMOVE
- S = SALVAGE
- RET = RETAIN
- R & S = REMOVE & SALVAGE


TREATED TIMBER CURB
7+084 - 7+173 RT.
7+108~7+190

STEEL BEAM GUARDRAIL, GALVANIZED
7+072.6 - 7+184.4 RT.

ANCHOR FOR STEEL BEAM RAIL
7+173 - 7+184.4 RT. (2 EA, BURIED IN BANK)
7+072.6 - 7+084 RT. (2 EA, HAD TO REMOVE THEN LATER PUT BACK)

REHABING DI, CB, OR MH CLASS I
7+115 RT. (1 EA.) 7+135 RT
7+123 LT. (1 EA.) 7+135 LT

REMOVAL AND DISPOSAL OF GUARD RAIL
7+084 - 7+173 RT.

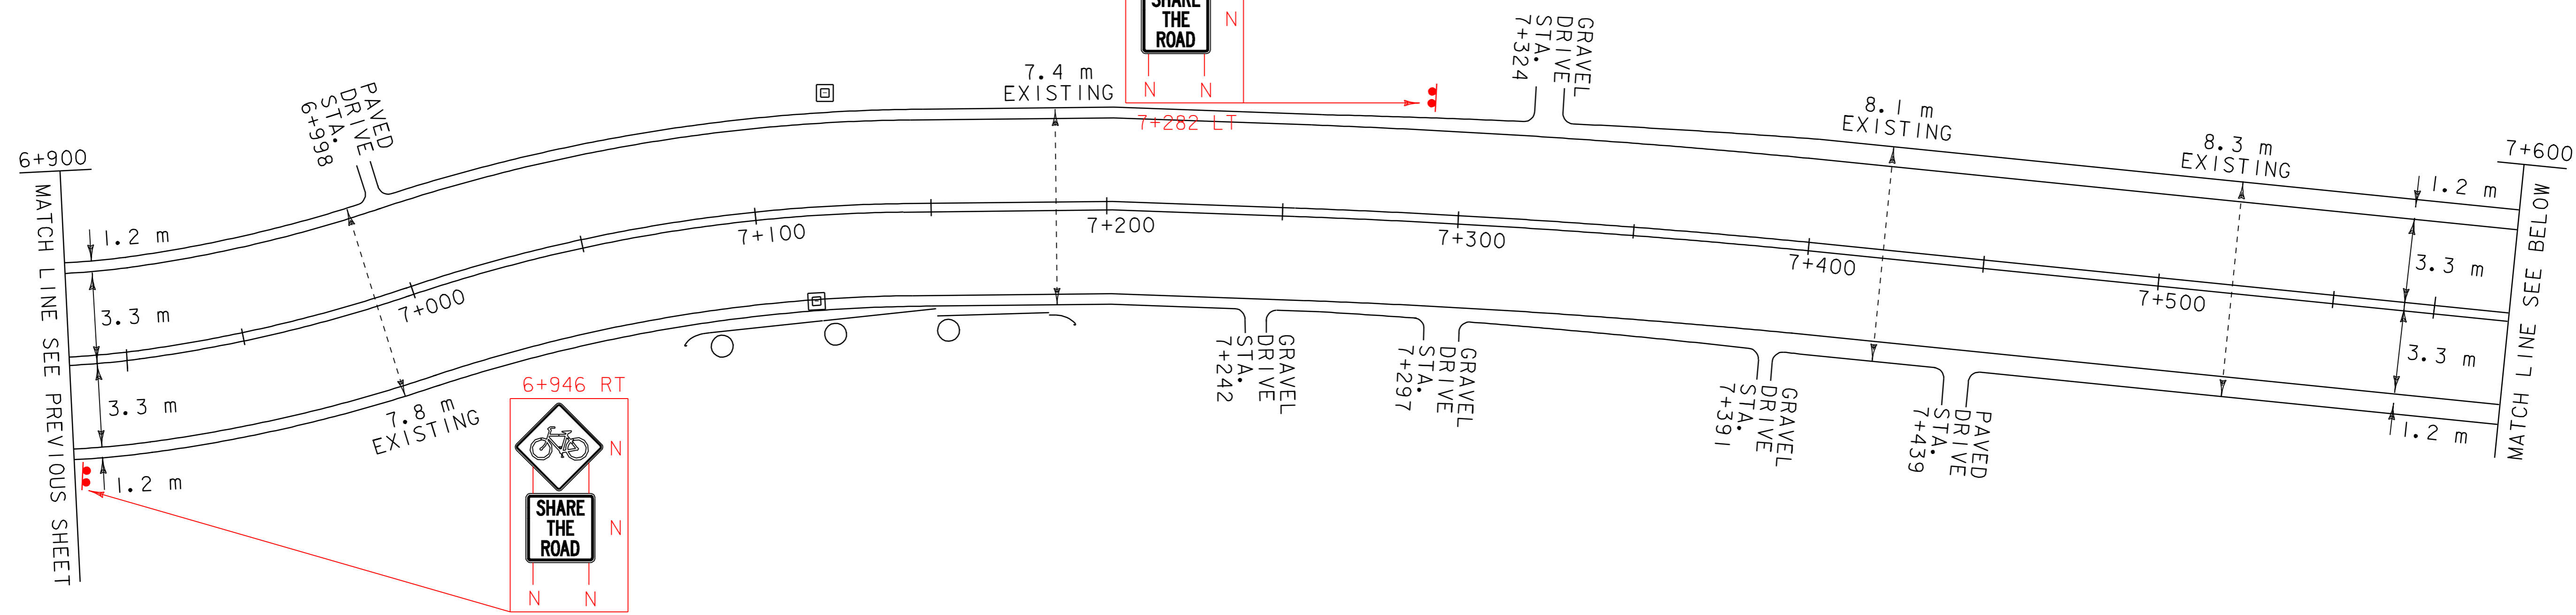


DURABLE 100mm WHITE LINE, THERMOPLASTIC
7+600 - 8+300 SOLID LT. & SOLID RT.

DURABLE 100mm YELLOW LINE, THERMOPLASTIC
7+600 - 8+200 SOLID LT. & SOLID RT.

TEMPORARY 100mm WHITE LINE, PAINT
7+600 - 8+300 SOLID LT. & SOLID RT.

TEMPORARY 100mm YELLOW LINE, PAINT
7+600 - 8+200 SOLID LT. & SOLID RT.

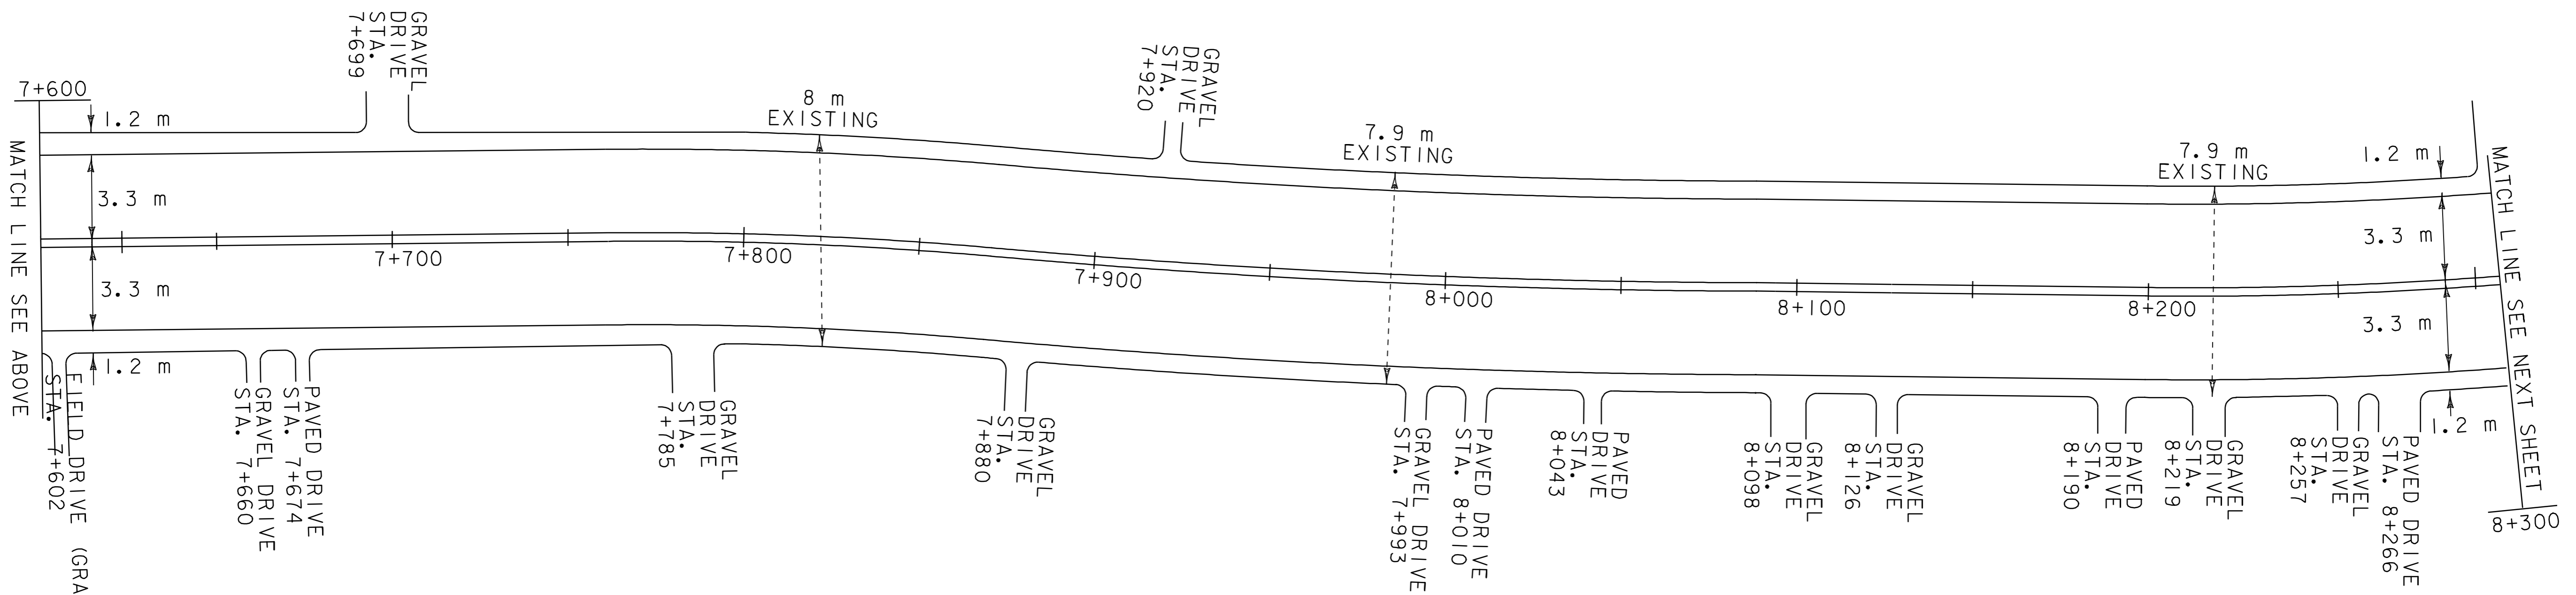

PROJECT LAYOUT SHEET
6

PROJECT NAME:	VERNON - BRATTLEBORO		
PROJECT NUMBER:	AC STP 2126(1)S		
FILE NAME:	Z:\pave\298\cl84\pcl84.dgn	PLOT DATE:	08-SEP-2009 13:3
PROJECT LEADER:		DRAWN BY:	WILDER
IPARM NAME:	pci84106.1	CHECKED BY:	PAVI_MGMI
		SHEET	17 OF 33