


DURABLE 100mm WHITE LINE, THERMOPLASTIC  
9+700 - 10+400 SOLID LT. & SOLID RT.

DURABLE 100mm YELLOW LINE, THERMOPLASTIC  
9+700 - 10+400 SOLID LT. & SOLID RT.

TEMPORARY 100mm WHITE LINE, PAINT  
9+700 - 10+400 SOLID LT. & SOLID RT.

TEMPORARY 100mm YELLOW LINE, PAINT  
9+700 - 10+400 SOLID LT. & SOLID RT.

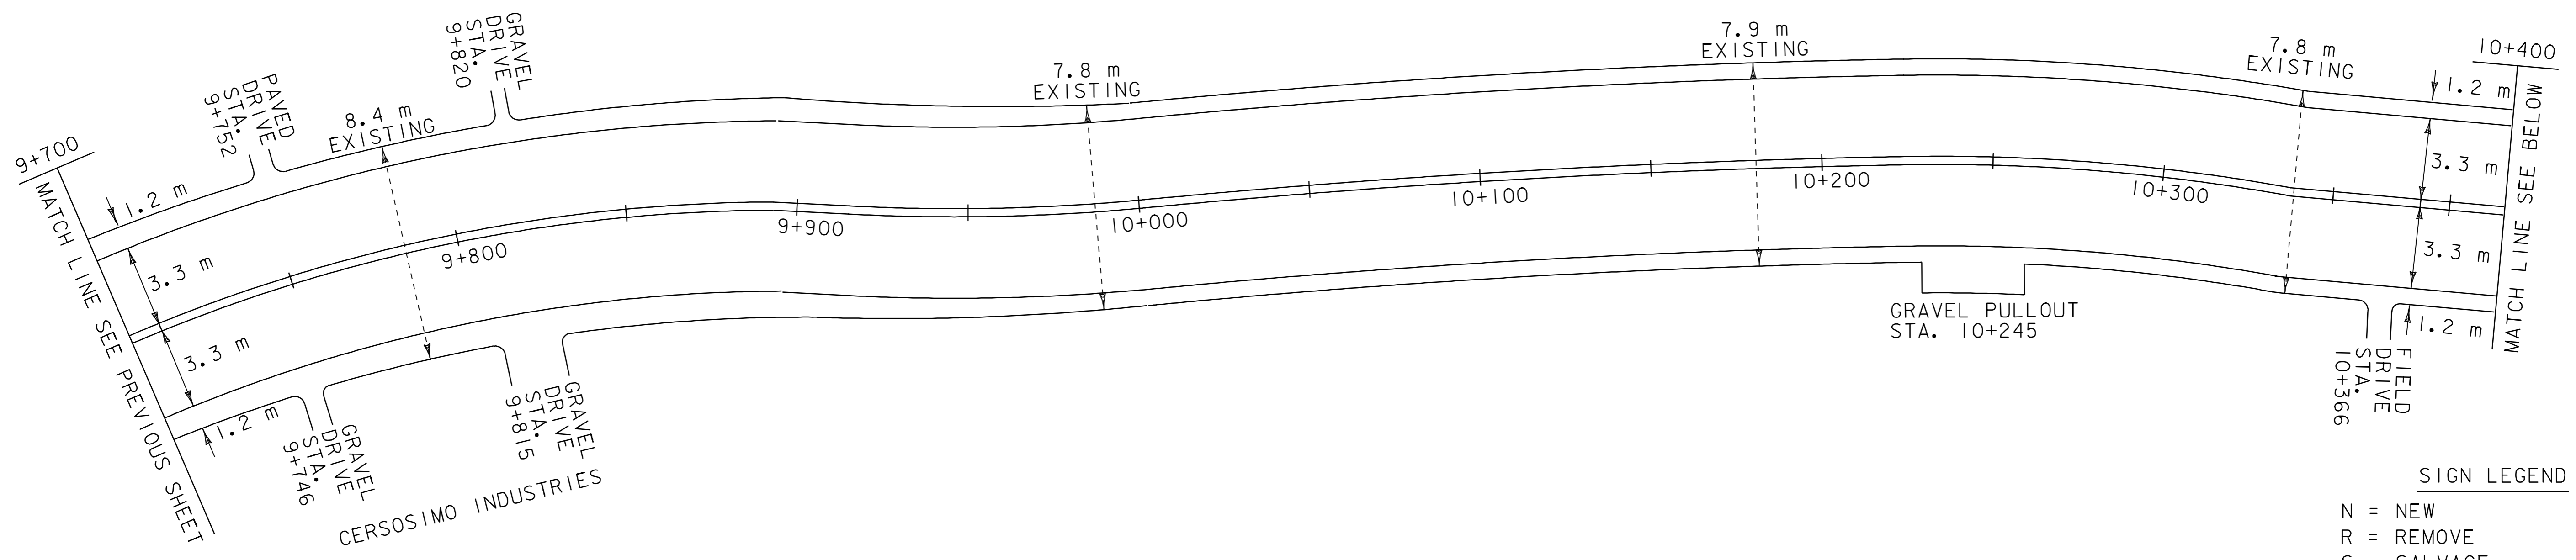

**SIGN LEGEND**  
 N = NEW  
 R = REMOVE  
 S = SALVAGE  
 RET = RETAIN  
 R & S = REMOVE & SALVAGE

DURABLE 100mm WHITE LINE, THERMOPLASTIC  
10+400 - 11+100 SOLID LT. & SOLID RT.

DURABLE 100mm YELLOW LINE, THERMOPLASTIC  
10+400 - 11+023 SOLID LT. & SOLID RT.  
11+023 - 11+100 SOLID LT. & DASH RT.

TEMPORARY 100mm WHITE LINE, PAINT  
10+400 - 11+100 SOLID LT. & SOLID RT.

TEMPORARY 100mm YELLOW LINE, PAINT  
10+400 - 11+023 SOLID LT. & SOLID RT.  
11+023 - 11+100 SOLID LT. & DASH RT.


STEEL BEAM GUARDRAIL, GALVANIZED  
10+996 - 11+100 RT.

MANUFACTURED TERMINAL SECTION, FLARED  
10+984.6 - 10+996 RT. (1 EACH)

REMOVAL AND DISPOSAL OF GUARD RAIL  
10+996 - 11+100 RT.

~~REHABING DI, CB, OR MH CLASS I~~

~~10+789 RT. (1 EA.)~~  
~~10+858 RT. (1 EA.)~~

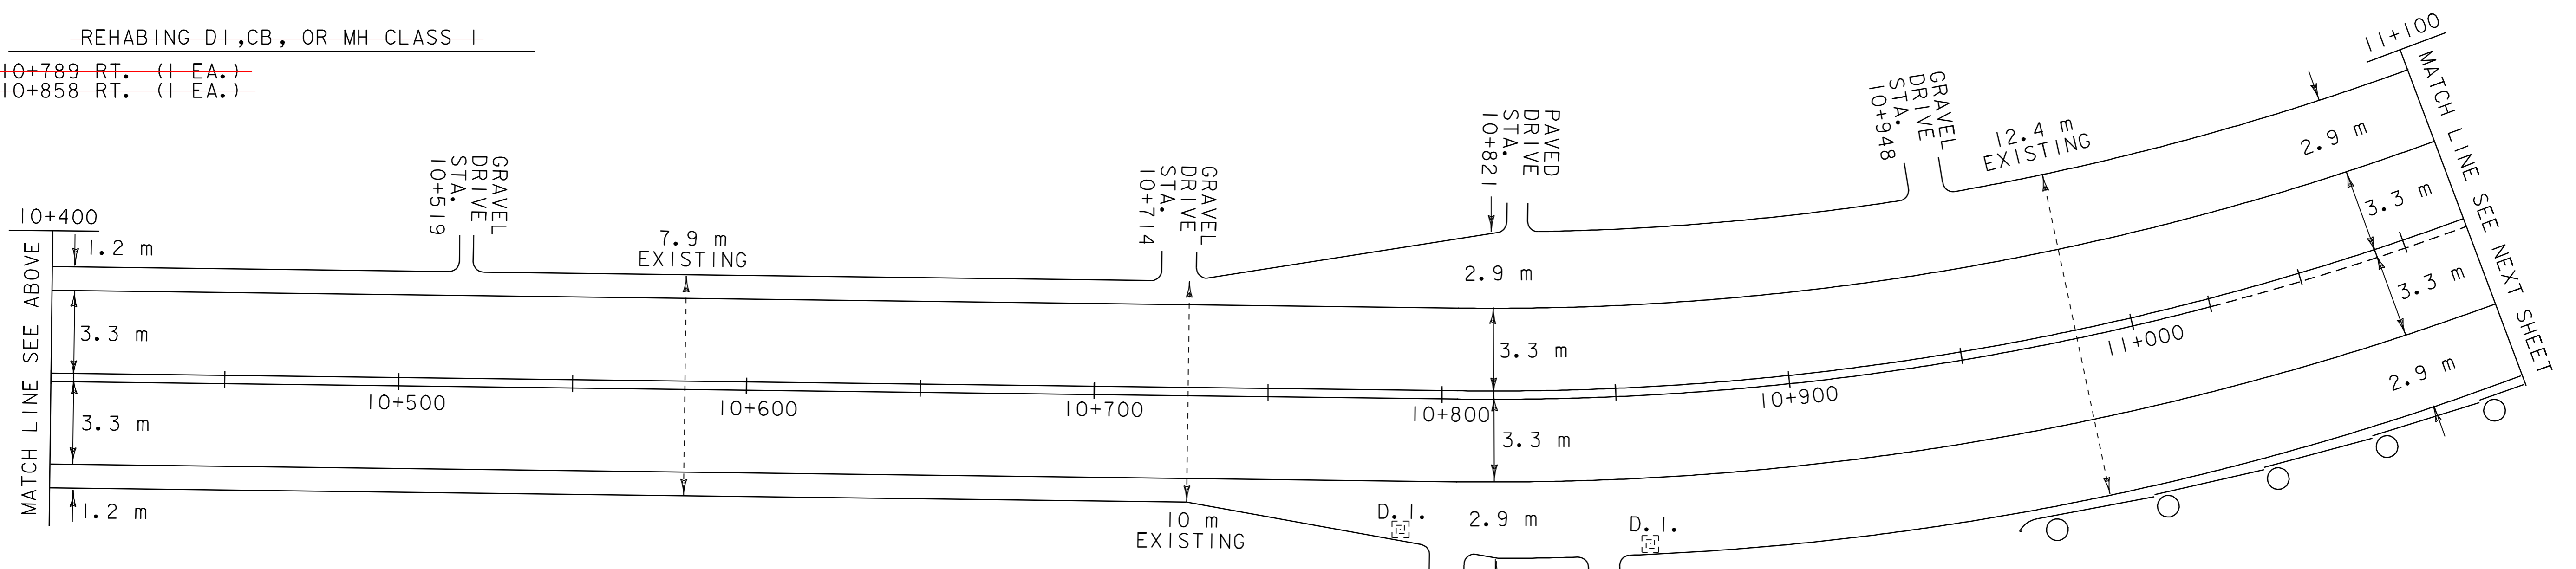

**PROJECT LAYOUT SHEET**  
# 8

PROJECT NAME: **VERNON - BRATTLEBORO**  
 PROJECT NUMBER: **AC STP 2126(1)S**  
 FILE NAME: zpqve\98cl84\pcl84.dgn PLOT DATE: 08-SEP-2009 13:3  
 PROJECT LEADER: \_\_\_\_\_ DRAWN BY: WILDER  
 IPARM NAME: pcl84108.1 CHECKED BY: PAVI\_MGM  
 SHEET 19 OF 33