

DURABLE 100mm WHITE LINE, THERMOPLASTIC
12+500 - 13+200 SOLID LT. & SOLID RT.

DURABLE 100mm YELLOW LINE, THERMOPLASTIC
12+500 - 13+200 SOLID LT. & SOLID RT.

TEMPORARY 100mm WHITE LINE, PAINT
12+500 - 13+200 SOLID LT. & SOLID RT.

TEMPORARY 100mm YELLOW LINE, PAINT
12+500 - 13+200 SOLID LT. & SOLID RT.


REHABING DI, CB, OR MH CLASS I
12+573 LT. (1 EA.)

MANUFACTURED TERMINAL SECTION, FLARED
12+890 - 12+901.4 RT. (1 EACH)

REMOVAL AND DISPOSAL OF GUARD RAIL
12+500 - 12+890 RT.

SIGN LEGEND
N = NEW
R = REMOVE
S = SALVAGE
RET = RETAIN
R & S = REMOVE & SALVAGE

STEEL BEAM GUARDRAIL, GALVANIZED W/2.4M POSTS
12+500 - 12+890 RT.

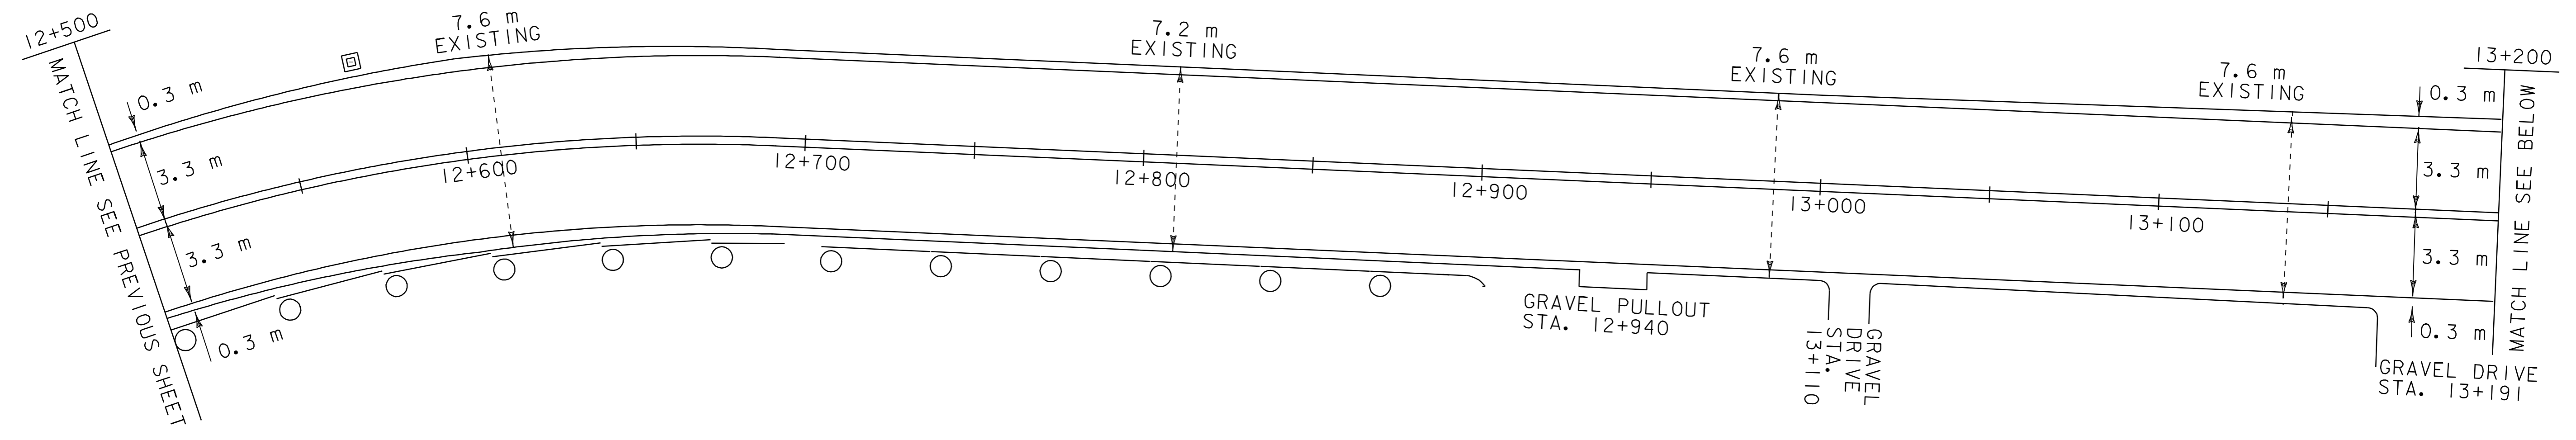

DURABLE 100mm WHITE LINE, THERMOPLASTIC
13+200 - 13+900 SOLID LT. & SOLID RT.

DURABLE 100mm YELLOW LINE, THERMOPLASTIC
13+200 - 13+900 SOLID LT. & SOLID RT.

TEMPORARY 100mm WHITE LINE, PAINT
13+200 - 13+900 SOLID LT. & SOLID RT.


TEMPORARY 100mm YELLOW LINE, PAINT
13+200 - 13+900 SOLID LT. & SOLID RT.

STEEL BEAM GUARDRAIL, GALVANIZED
13+318 - 13+345 RT.
13+390 - 13+412 LT.
13+390 - 13+551 RT.
13+412 LT. 2 - 4.88m RADIUS PANELS

MANUFACTURED TERMINAL SECTION, FLARED
13+306.6 - 13+318 RT. (1 EACH)
13+551 - 13+562.4 RT. (1 EACH)

ANCHOR FOR STEEL BEAM GUARD RAIL
13+412 LT. (2 EA.)

REMOVAL AND DISPOSAL OF GUARD RAIL
13+318 - 13+345 RT.
13+390 - 13+551 RT.
13+390 - 13+412 LT.

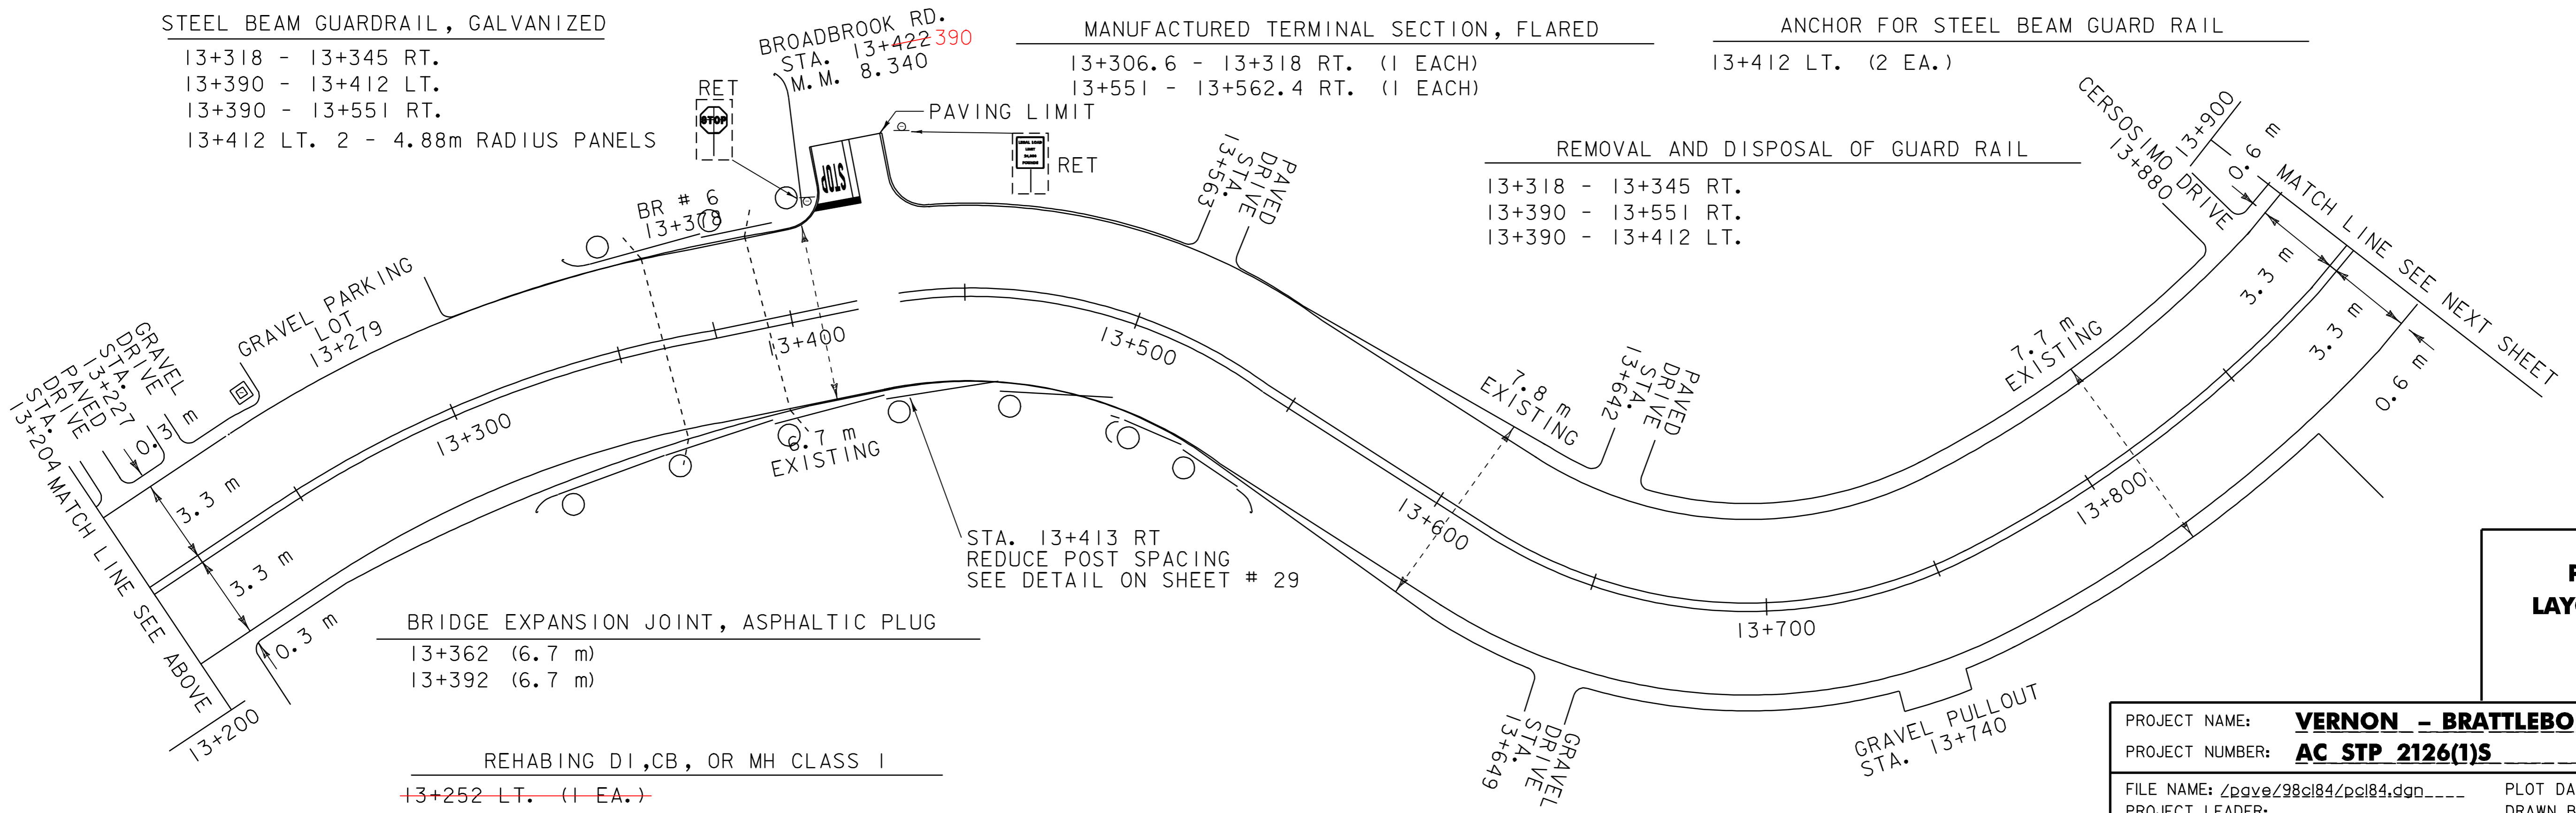

PROJECT LAYOUT SHEET # 10

PROJECT NAME:	VERNON - BRATTLEBORO		
PROJECT NUMBER:	AC STP 2126(1)S		
FILE NAME:	z:\pave\298\cl84\pci84.dgn	PLOT DATE:	08-SEP-2009 13:33
PROJECT LEADER:		DRAWN BY:	WILDER
IPARM NAME:	pci84110.1	CHECKED BY:	PAVI_MGMT
		SHEET	21 OF 33