

DURABLE 100mm WHITE LINE, THERMOPLASTIC  
 13+900 - 14+005 SOLID LT. & SOLID RT.  
 0+000 - 0+600 SOLID LT. & SOLID RT.

DURABLE 100mm YELLOW LINE, THERMOPLASTIC  
 13+900 - 14+005 SOLID LT. & SOLID RT.  
 0+000 - 0+600 SOLID LT. & SOLID RT.


TEMPORARY 100mm WHITE LINE, PAINT  
 13+900 - 14+005 SOLID LT. & SOLID RT.  
 0+000 - 0+600 SOLID LT. & SOLID RT.

TEMPORARY 100mm YELLOW LINE, PAINT  
 13+900 - 14+005 SOLID LT. & SOLID RT.  
 0+000 - 0+600 SOLID LT. & SOLID RT.

STEEL BEAM GUARDRAIL, GALVANIZED W/2.4 M POSTS  
 0+392 - 0+600 RT.

MANUFACTURED TERMINAL SECTION, FLARED  
 0+380.6 - 0+392 RT. (1 EACH)

REMOVAL AND DISPOSAL OF GUARD RAIL  
 0+403 - 0+600 RT.

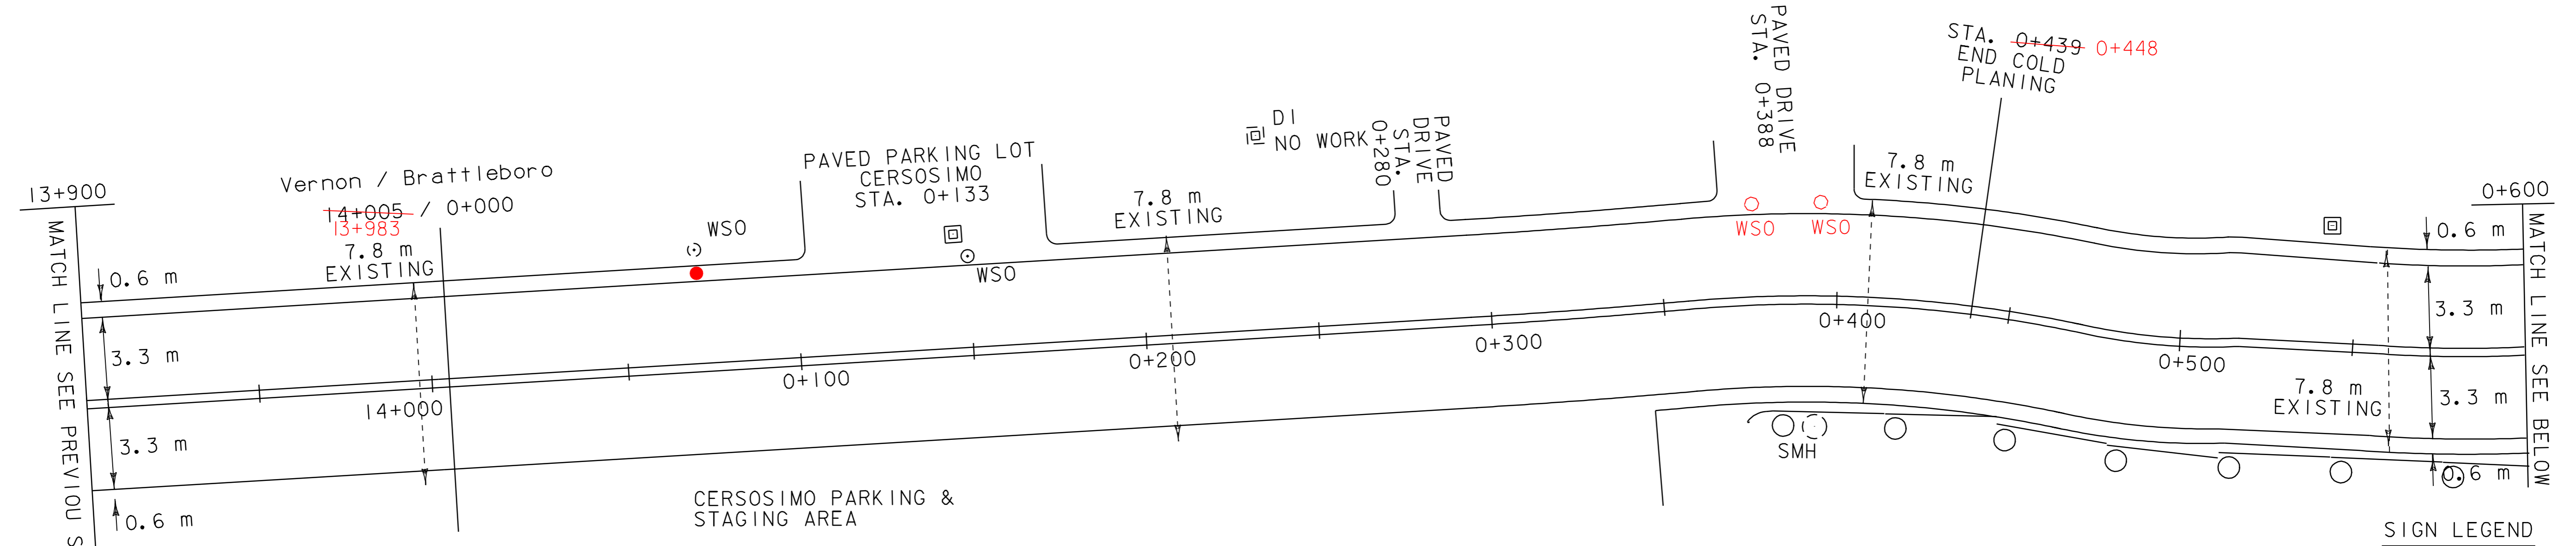

ADJUST ELEVATION OF VALVE BOX  
 0+071 LT (WSO)  
 0+383 LT (WSO)  
 0+408 LT (WSO)

REHABING DI, CB, OR MH CLASS I  
 0+146 LT. (1 EA.)  
 0+542 LT. (1 EA.)

**NOTE:**  
**STA. 0+392 RT - STA. 1+300 RT. TOWN TO LOCATE SEWER LINE & WATER LINE BEFORE DOING GUARD RAIL WORK.**

**SIGN LEGEND**  
 N = NEW  
 R = REMOVE  
 S = SALVAGE  
 RET = RETAIN  
 R & S = REMOVE & SALVAGE

DURABLE 100mm WHITE LINE, THERMOPLASTIC  
 0+600 - 1+300 SOLID LT. & SOLID RT.

DURABLE 100mm YELLOW LINE, THERMOPLASTIC  
 0+600 - 1+300 SOLID LT. & SOLID RT.

TEMPORARY 100mm WHITE LINE, PAINT  
 0+600 - 1+300 SOLID LT. & SOLID RT.

REMOVING SIGNS  
 1 EA

STEEL BEAM GUARDRAIL, GALVANIZED W/2.4 M POSTS  
 0+600 - 0+726 RT.  
 0+837 - 1+300 RT.


STEEL BEAM GUARDRAIL, GALVANIZED  
 1+252 - 1+300 LT.

TEMPORARY 100mm YELLOW LINE, PAINT  
 0+600 - 1+300 SOLID LT. & SOLID RT.

ANCHOR FOR STEEL BEAM GUARD RAIL  
 0+726 RT. ~~(BURY IN BACKSLOPE)~~ 1+267 LT  
 0+837 RT. ~~(BURY IN BACKSLOPE)~~ LEFT EXISTING  
 BCT - OK'D BY PROJ. MGR AND DISTR.

REMOVAL AND DISPOSAL OF GUARD RAIL  
 0+600 - 0+726 RT. 1+248 - 1+300 RT.  
 0+837 - 1+210 RT. 1+252 - 1+300 LT.

MANUFACTURED TERMINAL SECTION, FLARED  
 1+240.6 - 1+252 LT. (1 EACH)

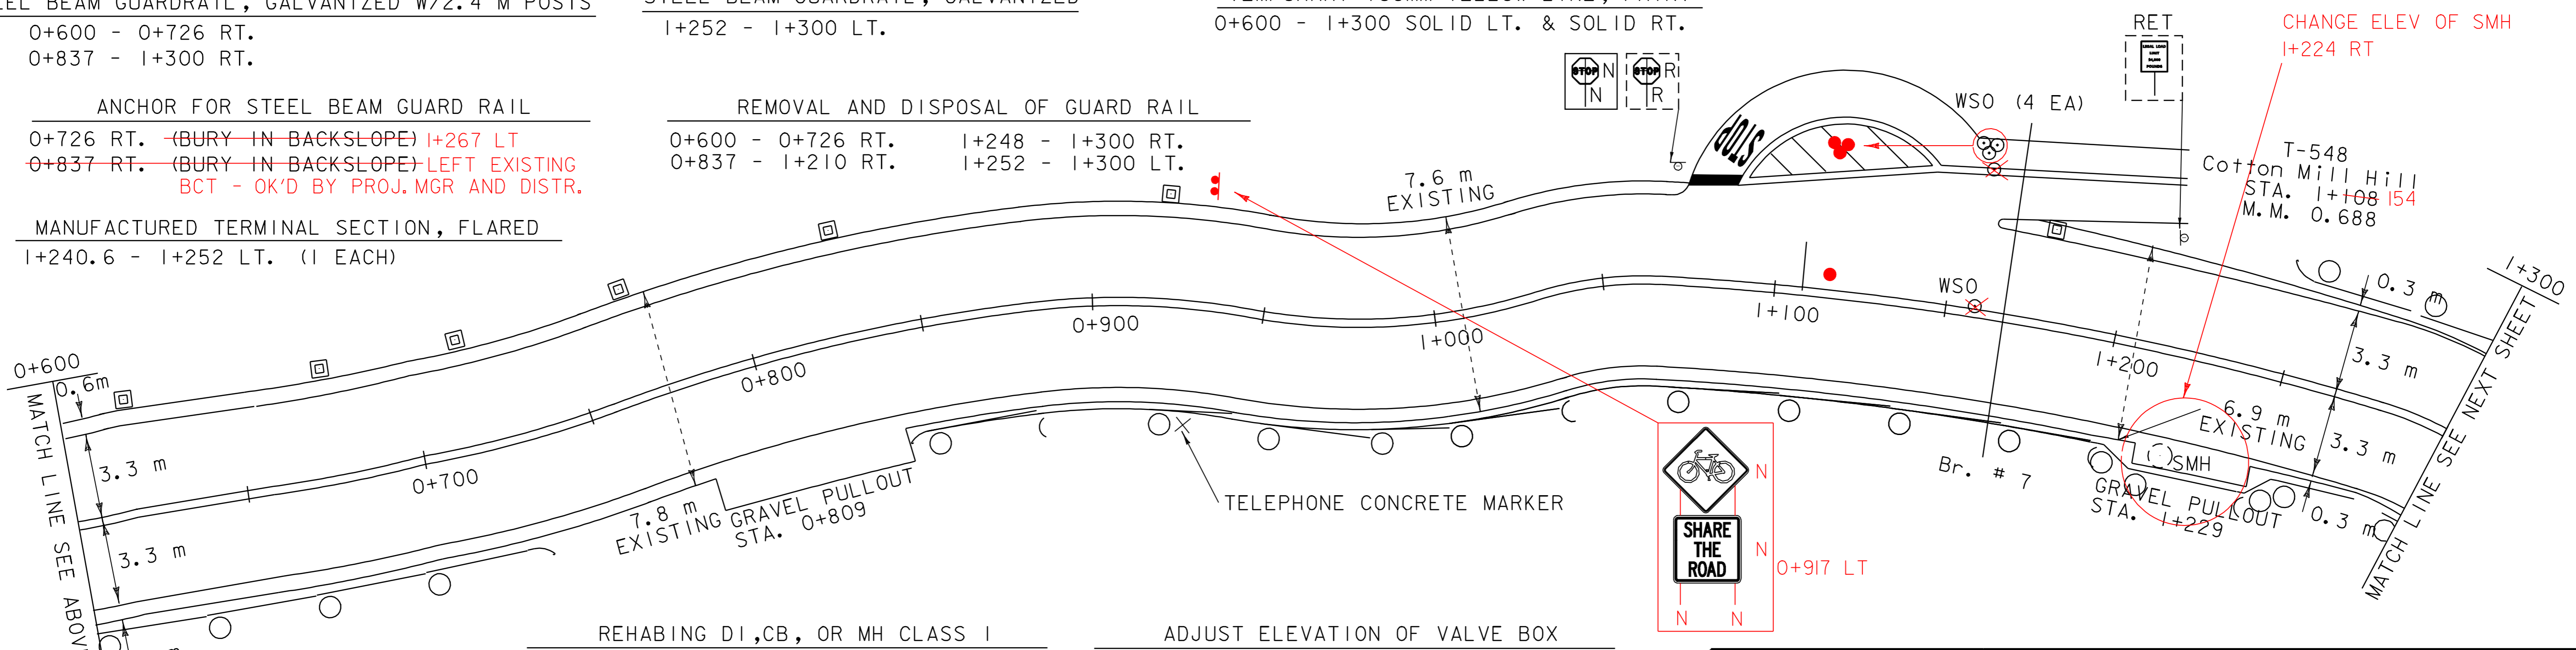

REHABING DI, CB, OR MH CLASS I  
 0+619 LT. (1 EA.)  
 0+676 LT. (1 EA.)  
 0+714 LT. (1 EA.)  
 1+179 LT. (1 EA.)  
 183

ADJUST ELEVATION OF VALVE BOX  
 0+154 LT. (WSO)  
 0+156 LT. (WSO)  
 0+157 LT. (WSO)  
 0+158 LT. (2 EA-WSO)  
 1+62 LT COTTON MILL HILL (3 EA WSO)  
 1+62 LT (WSO)

**PROJECT LAYOUT SHEET**  
**# 11**

PROJECT NAME: **VERNON - BRATTLEBORO**  
 PROJECT NUMBER: **AC STP 2126(1)S**  
 FILE NAME: zpqve\98\cl84\pci84.dgn PLOT DATE: 08-SEP-2009 13:3  
 PROJECT LEADER: \_\_\_\_\_ DRAWN BY: WILDER  
 IPARM NAME: pci84\llj CHECKED BY: PAVI.MGM  
 SHEET 22 OF 33