

DURABLE 100mm WHITE LINE, THERMOPLASTIC  
I+300 - I+767 SOLID LT. & SOLID RT.

DURABLE 100mm YELLOW LINE, THERMOPLASTIC  
I+300 - I+767 SOLID LT. & SOLID RT.

TEMPORARY 100mm WHITE LINE, PAINT  
I+300 - I+767 SOLID LT. & SOLID RT.

TEMPORARY 100mm YELLOW LINE, PAINT  
I+300 - I+766 SOLID LT. & SOLID RT.

DURABLE RAILROAD CROSSING SYMBOL, THERMOPLASTIC  
I+708 RT.

STEEL BEAM GUARDRAIL, GALVANIZED W/2.4 M POSTS  
I+300 - I+368 LT.  
I+300 - I+390 RT.

STEEL BEAM GUARDRAIL, GALVANIZED  
I+572 - I+611 RT.  
I+611 RT. 3 # - 4.88 M RADIUS PANELS

REMOVAL AND DISPOSAL OF GUARD RAIL  
I+300 - I+368 LT.  
I+300 - I+390 RT.  
I+572 - I+611 RT.

TEMPORARY RAILROAD CROSSING SYMBOL, PAINT  
I+740 RT.

MANUFACTURED TERMINAL SECTION, FLARED  
I+368 - I+379.4 LT. (1 EACH)  
~~I+390 - I+401.4 RT. (1 EACH)~~

ANCHOR FOR STEEL BEAM GUARD RAIL  
I+572 RT. (1 EA)  
I+611 RT. (2 EA.)  
I+375 RT (IEA)

**NOTE:**


- 1.) STA. I+300 LT - STA. I+368 LT. TOWN TO LOCATE WATER LINE BEFORE DOING GUARD RAIL WORK.
- 2.) STA. I+300 RT - STA. I+390 RT. TOWN TO LOCATE SEWER LINE BEFORE DOING GUARD RAIL WORK.

CHANGING ELEVATION OF SEWER MAN HOLE

I+515 RT.  
~~I+554 RT.~~  
I+564 RT.  
~~I+623 RT.~~

~~ADJUST ELEVATION OF VALVE BOX~~  
~~I+449 LT. (WSO)~~

REMOVING SIGNS  
1 EA

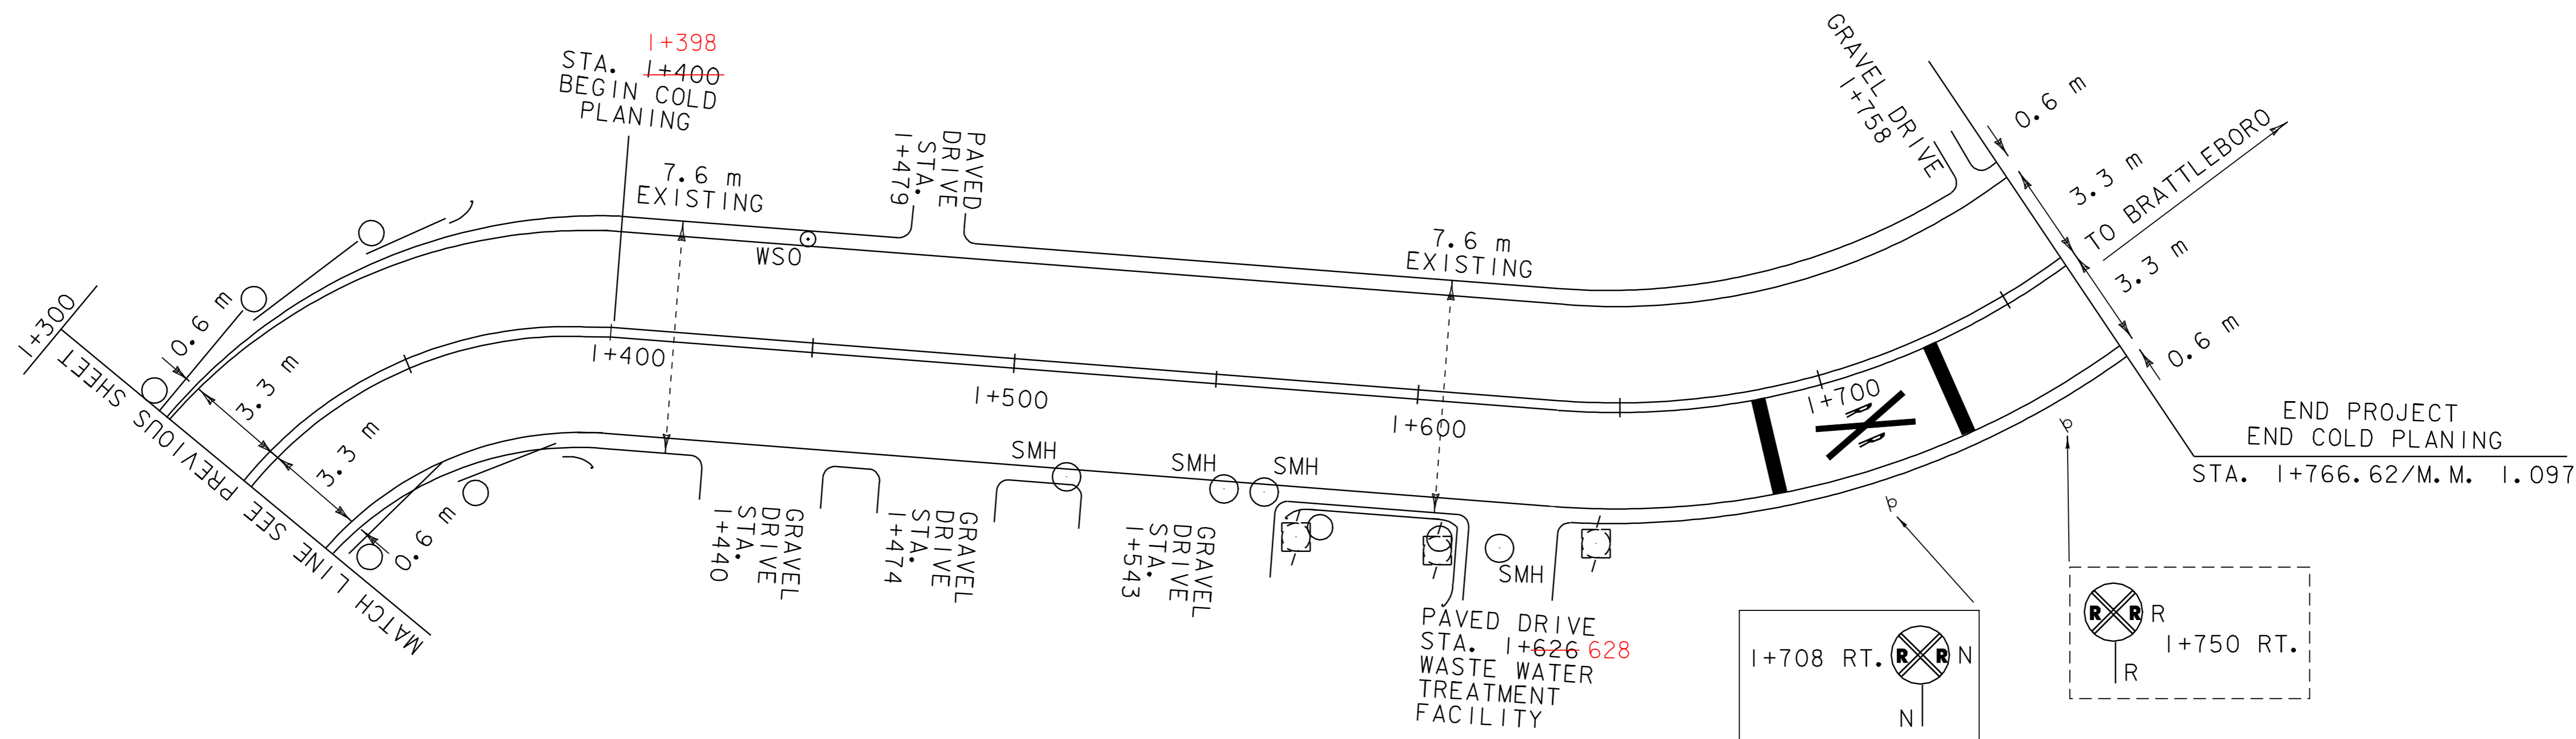

SIGN LEGEND

- N = NEW
- R = REMOVE
- S = SALVAGE
- RET = RETAIN
- R & S = REMOVE & SALVAGE

**PROJECT LAYOUT SHEET**  
**# 12**

|                 |                             |             |                  |
|-----------------|-----------------------------|-------------|------------------|
| PROJECT NAME:   | <b>VERNON - BRATTLEBORO</b> |             |                  |
| PROJECT NUMBER: | <b>AC STP 2126(1)S</b>      |             |                  |
| FILE NAME:      | zpqve\98cl84\pci84.dgn      | PLOT DATE:  | 08-SEP-2009 13:3 |
| PROJECT LEADER: |                             | DRAWN BY:   | WILDER           |
| IPARM NAME :    | pci84112.1                  | CHECKED BY: | PAVI_MGMT        |
|                 |                             | SHEET       | 23 OF 33         |