


5+00.00

STA 5+00.00  
END PROJECT BHF 0283(9)S  
BEGIN APPROACH

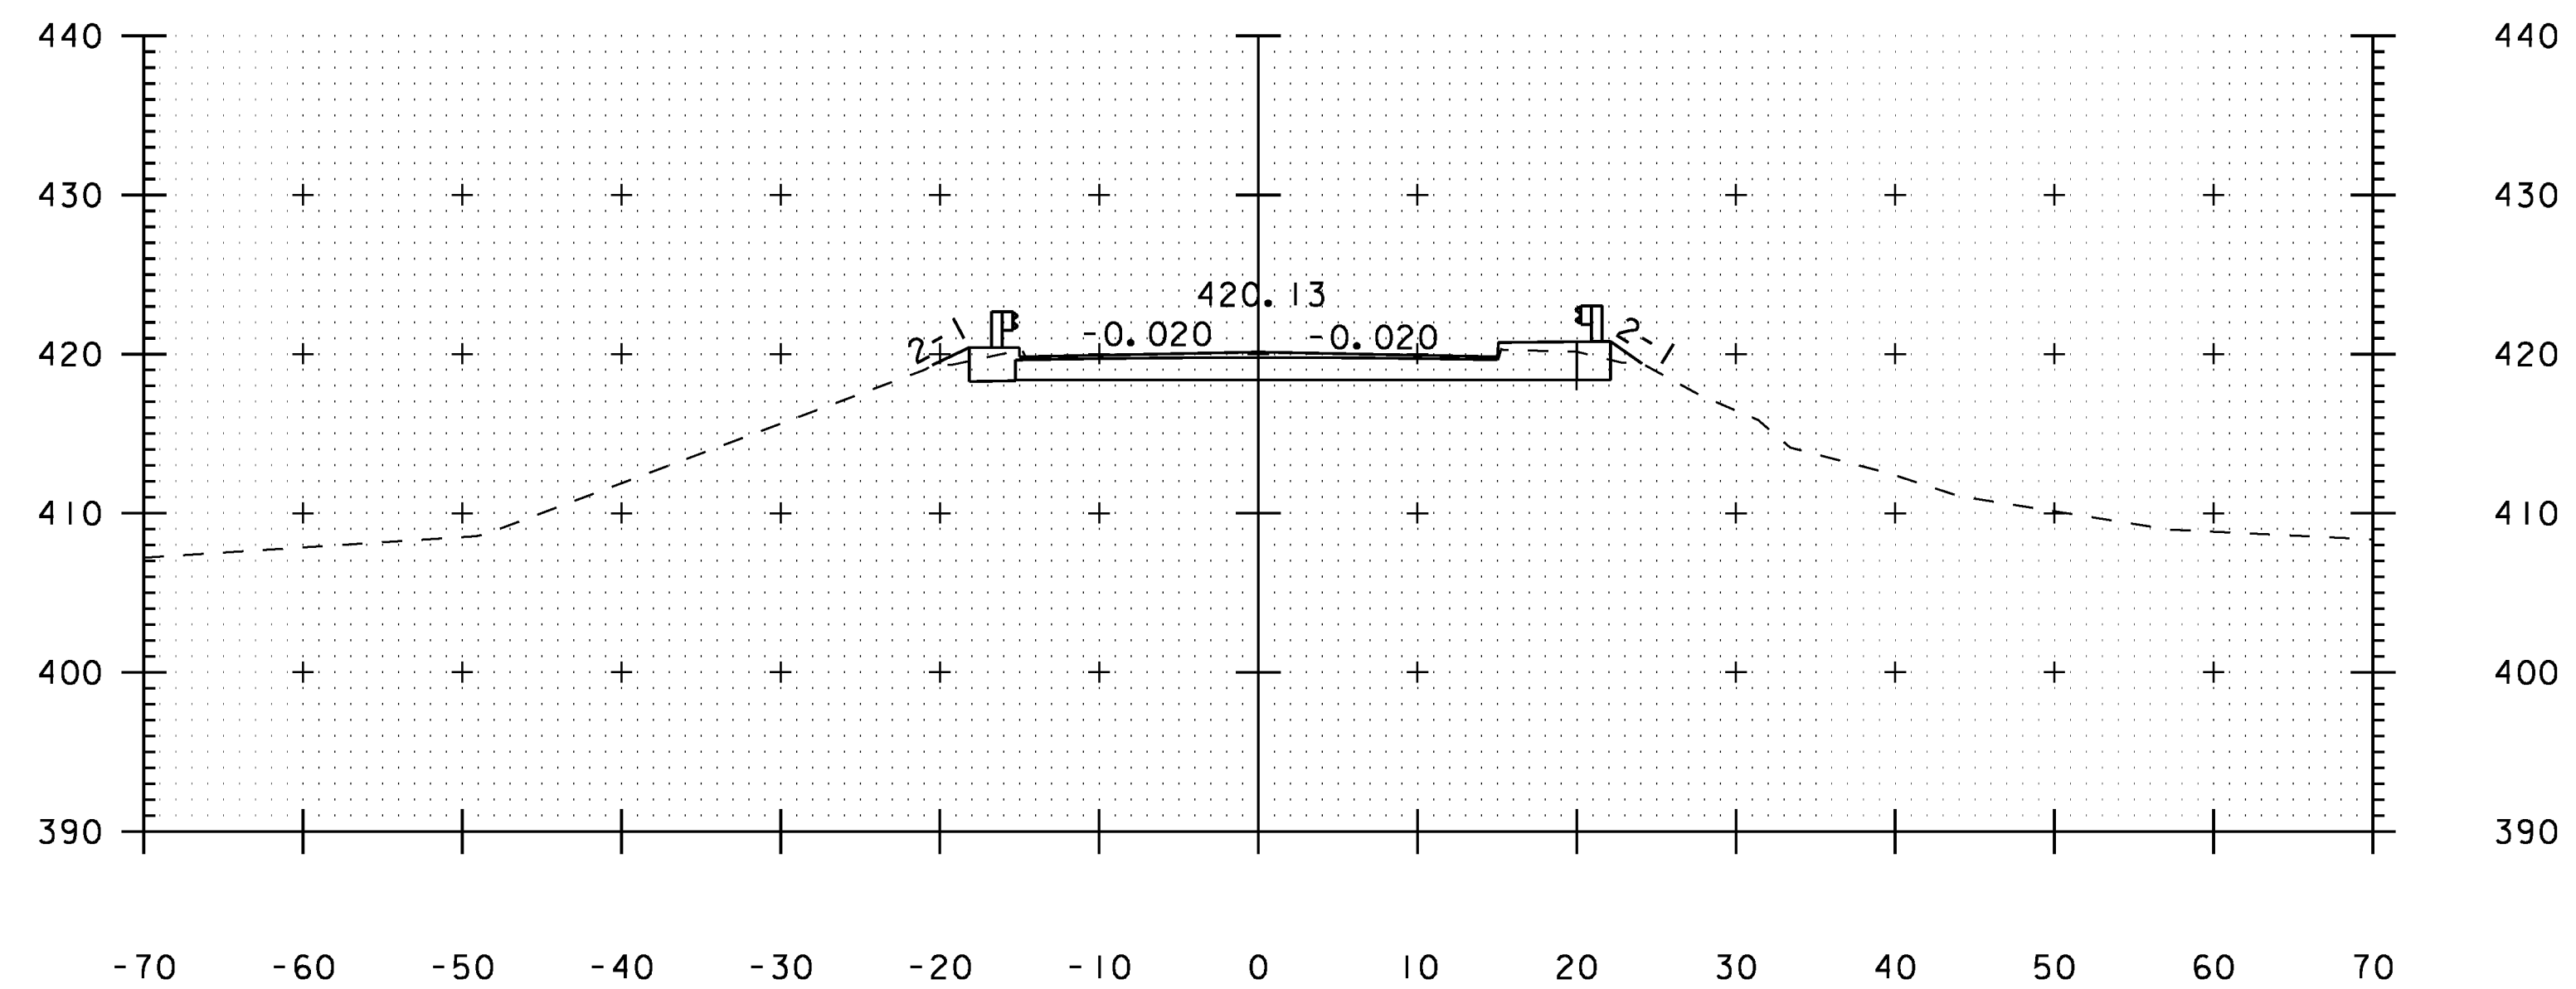

4+50.00

**STATE OF VERMONT  
AGENCY OF TRANSPORTATION**

|                               |                |                          |              |
|-------------------------------|----------------|--------------------------|--------------|
| Town Of                       | BERKSHIRE      | Bridge No.               | 30           |
| Highway No.                   | VT 118         | Log Sta.                 |              |
|                               |                | Surv. Sta.               |              |
| VT 118 OVER MISSISSQUOI RIVER |                |                          |              |
| CROSS SECTION 5               |                |                          |              |
| Designed By                   | D Bryant       | Drawn By                 | J Davis      |
| Checked By                    | J Andrews      | Bridge Design Supervisor |              |
|                               |                | Date                     | 4/2/09       |
|                               |                | Date                     |              |
| PROJECT                       | BERKSHIRE      | PROJECT NO.              | BHF 0283(9)S |
| I.G.C. Info.                  | ZC304XSLDGN    |                          |              |
| Bridge Sheet No.              | Sheet 36 of 41 |                          |              |