



STA 6+85.00  
END APPROACH

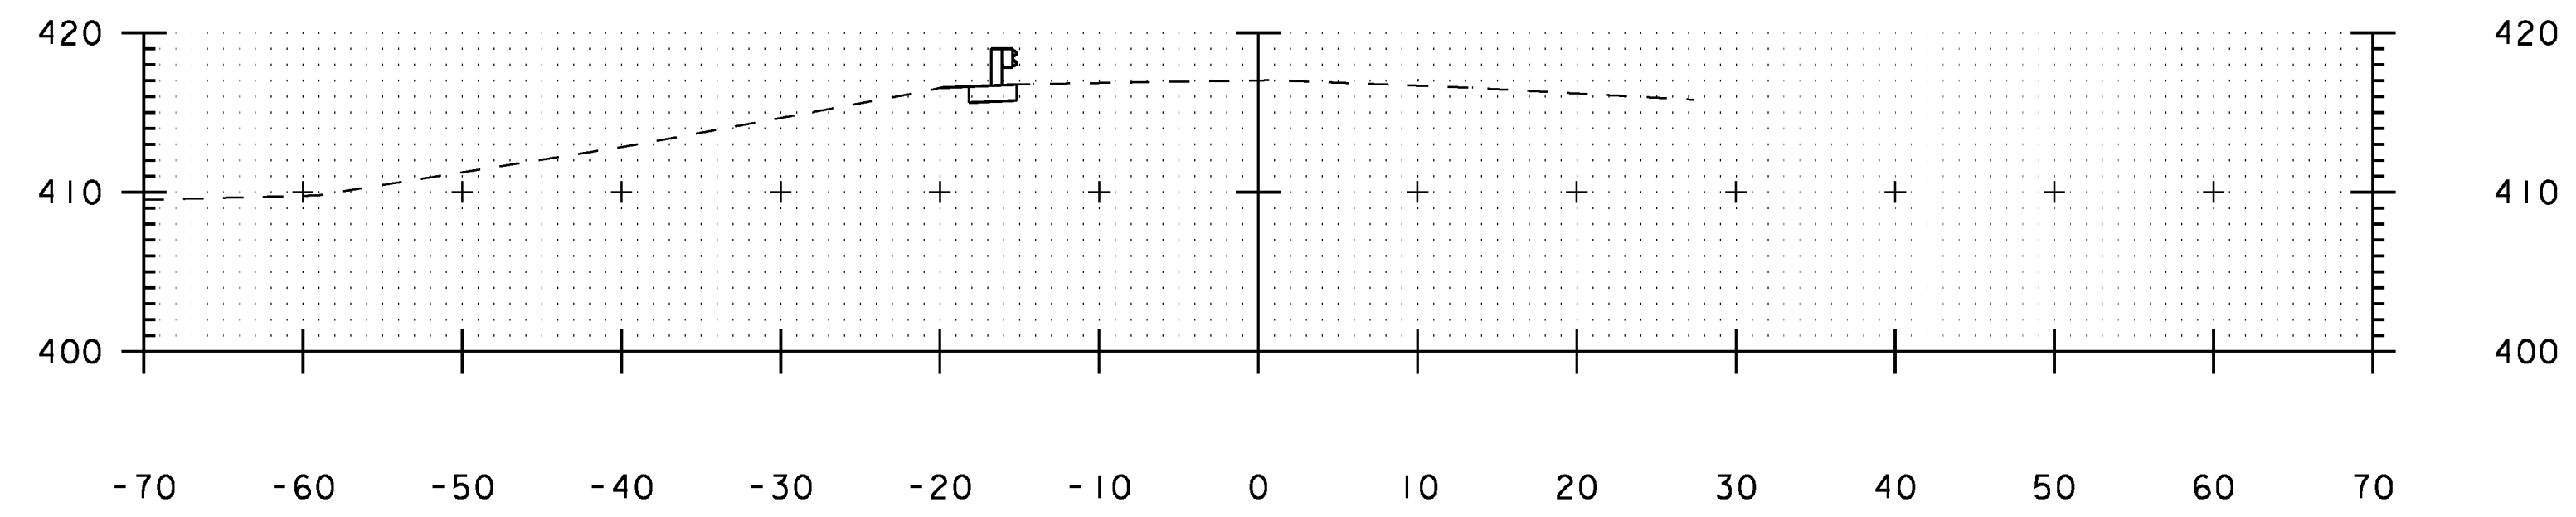

6+00.00

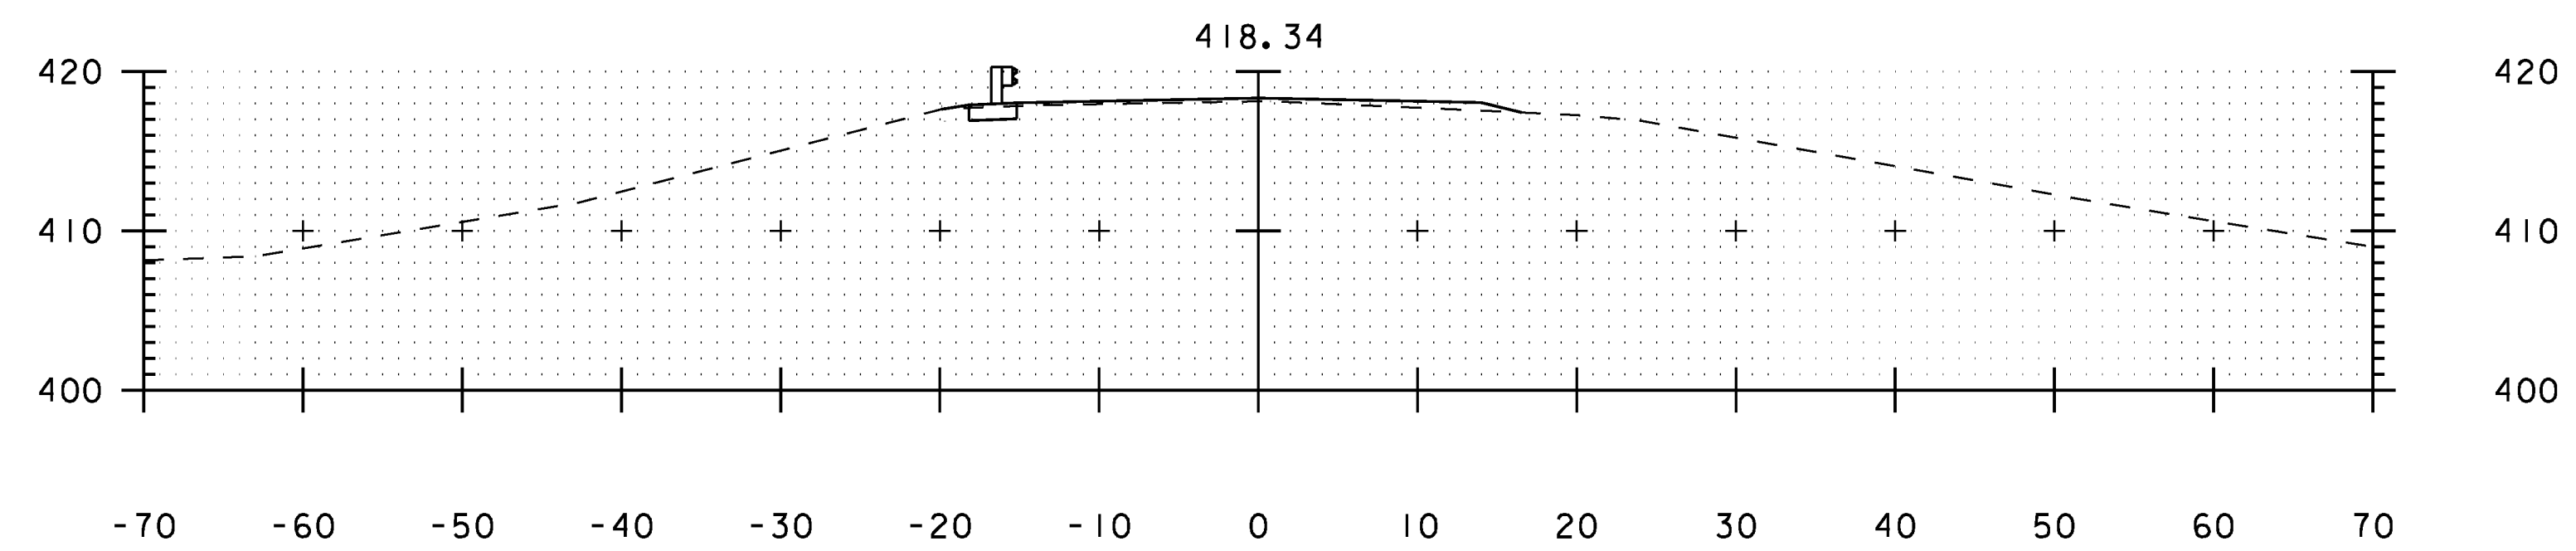

5+50.00

STATE OF VERMONT AGENCY OF TRANSPORTATION			
Town Of	BERKSHIRE	Bridge No.	30
Highway No.	VT 118	Log Sta.	
		Surv. Sta.	
VT 118 OVER MISSISSQUOI RIVER			
CROSS SECTION 6			
Designed By	D Bryant	Drawn By	J Davis
Checked By	J Andrews	Bridge Design Supervisor	
Date	4/2/09	Date	
PROJECT	BERKSHIRE	PROJECT NO.	BHF 0283(9)S
I.G.C. Info.	ZC304XSLDGN		
Bridge Sheet No.	Sheet 37 of 41		