
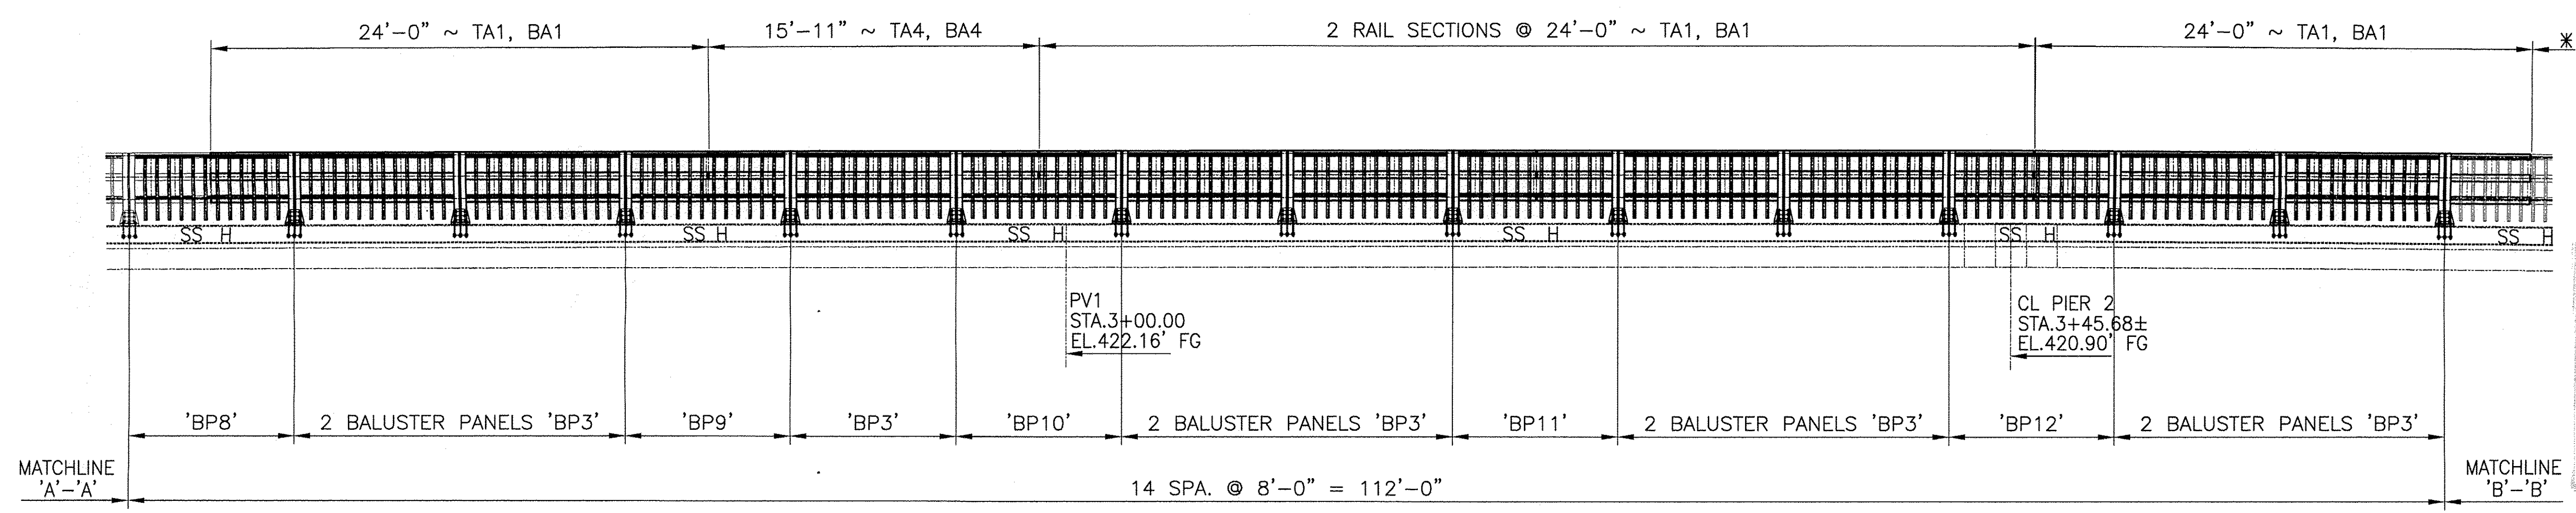


H = HOLE SIDE  
 SS = SHORT SLOTTED SIDE  
 LS = LONG SLOTTED SIDE

FOR SIDEWALK APPROACH  
 RAILING SEE LB8

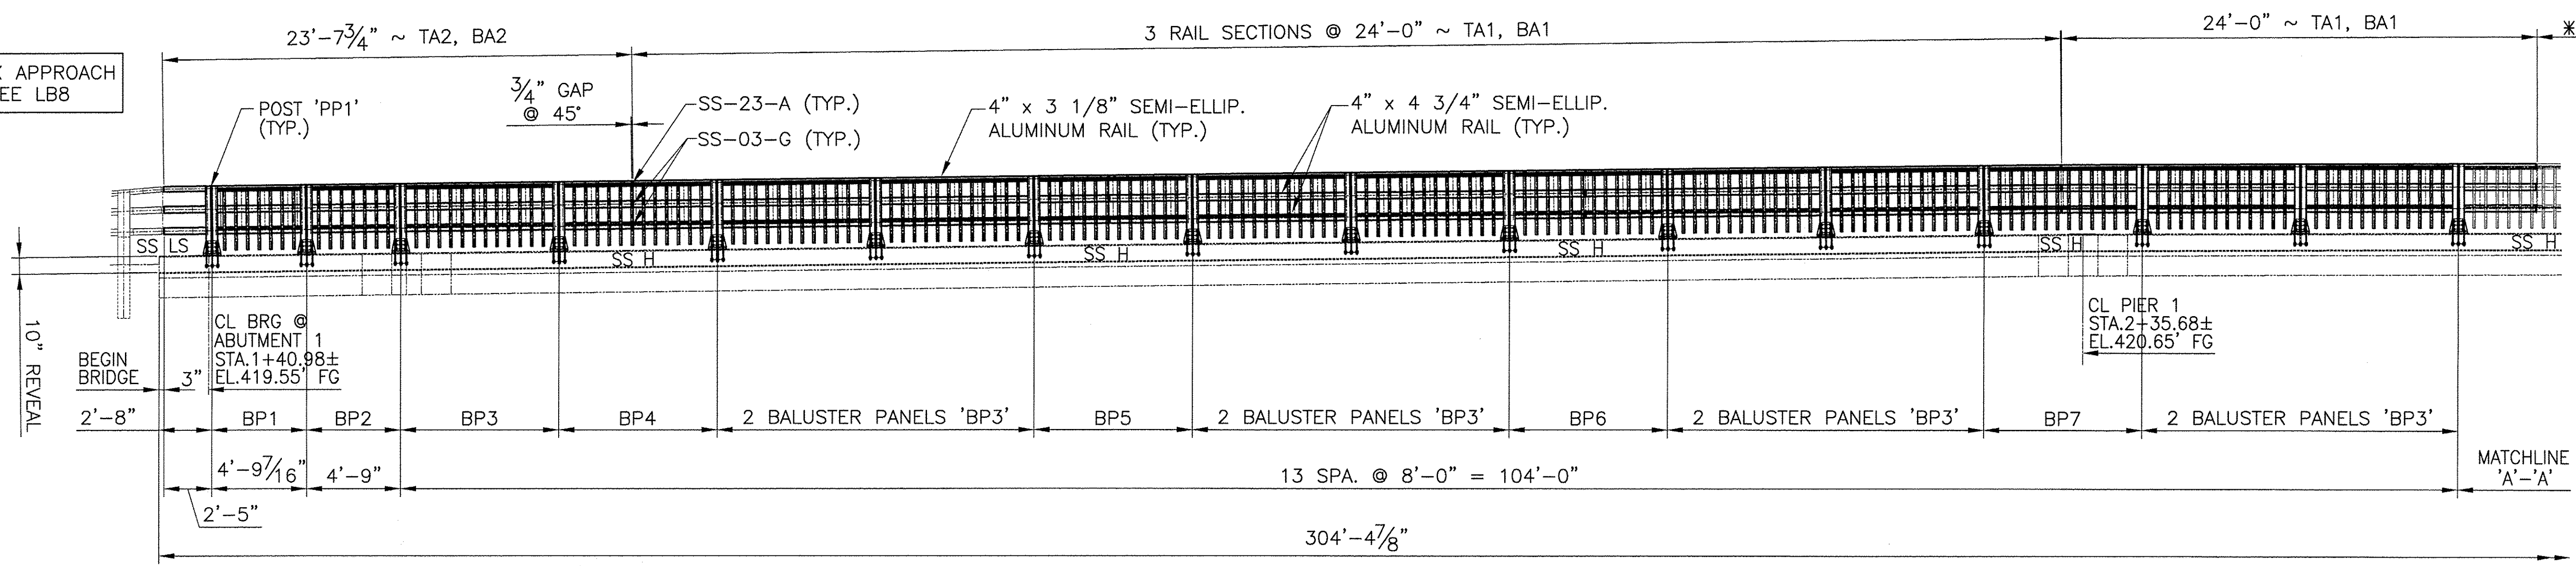


No Exception Taken  
 Make Correction as Noted  
 Submit Specified Item  
 Revise and Resubmit as Noted  
 Rejected  
 Checking is for general compliance with the design concept of the project and general conformance with the information given in the contract documents only. Any action shown is not an approval and is subject to the requirements of the plans and specifications. Any action shown on a specific item shall not indicate the checking of an assembly of which the item is a component. Contractor is solely responsible for dimensions which shall be confirmed and correlated at the job site, fabrication processes, technique of construction, safety precautions, and coordination of its work with that of all other trades and the satisfactory performance of its work.  
 Reviewed by: Shanta Keller Date: 3/31/10

NOTE:

- THIS CONTRACT IS BASED UPON THE CONTRACTOR SETTING AND SPACING THE ANCHOR BOLTS TO THE MEASUREMENTS SHOWN ON THE APPROVED SHOP DRAWINGS. THE L.B. FOSTER CO. WILL NOT BE RESPONSIBLE FOR WORK NECESSITATED BY ANY OTHER SETTING AND SPACING.
- THIS DRAWING IS NOT TO SCALE.
- FOR GENERAL NOTES AND TYPICAL DETAILS SEE DRAWING LB1.
- LENGTH OF RAILING ON THIS SHEET IS 305 LF PAY LENGTH.
- POST SPACING IS MEASURED HORIZONTALLY ALONG O/S EDGE OF PARAPET.
- SPLICE GAP AT SLEEVE = 3/4" TYP.
- RAIL LENGTHS DO NOT INCLUDE GAPS.
- COMPENSATION FOR VERTICAL CURVE IS INCLUDED IN THE RAIL LGTHS.
- FOR BALUSTER DETAILS SEE DRAWING LB6.

FOR SIDEWALK APPROACH  
 RAILING SEE LB8

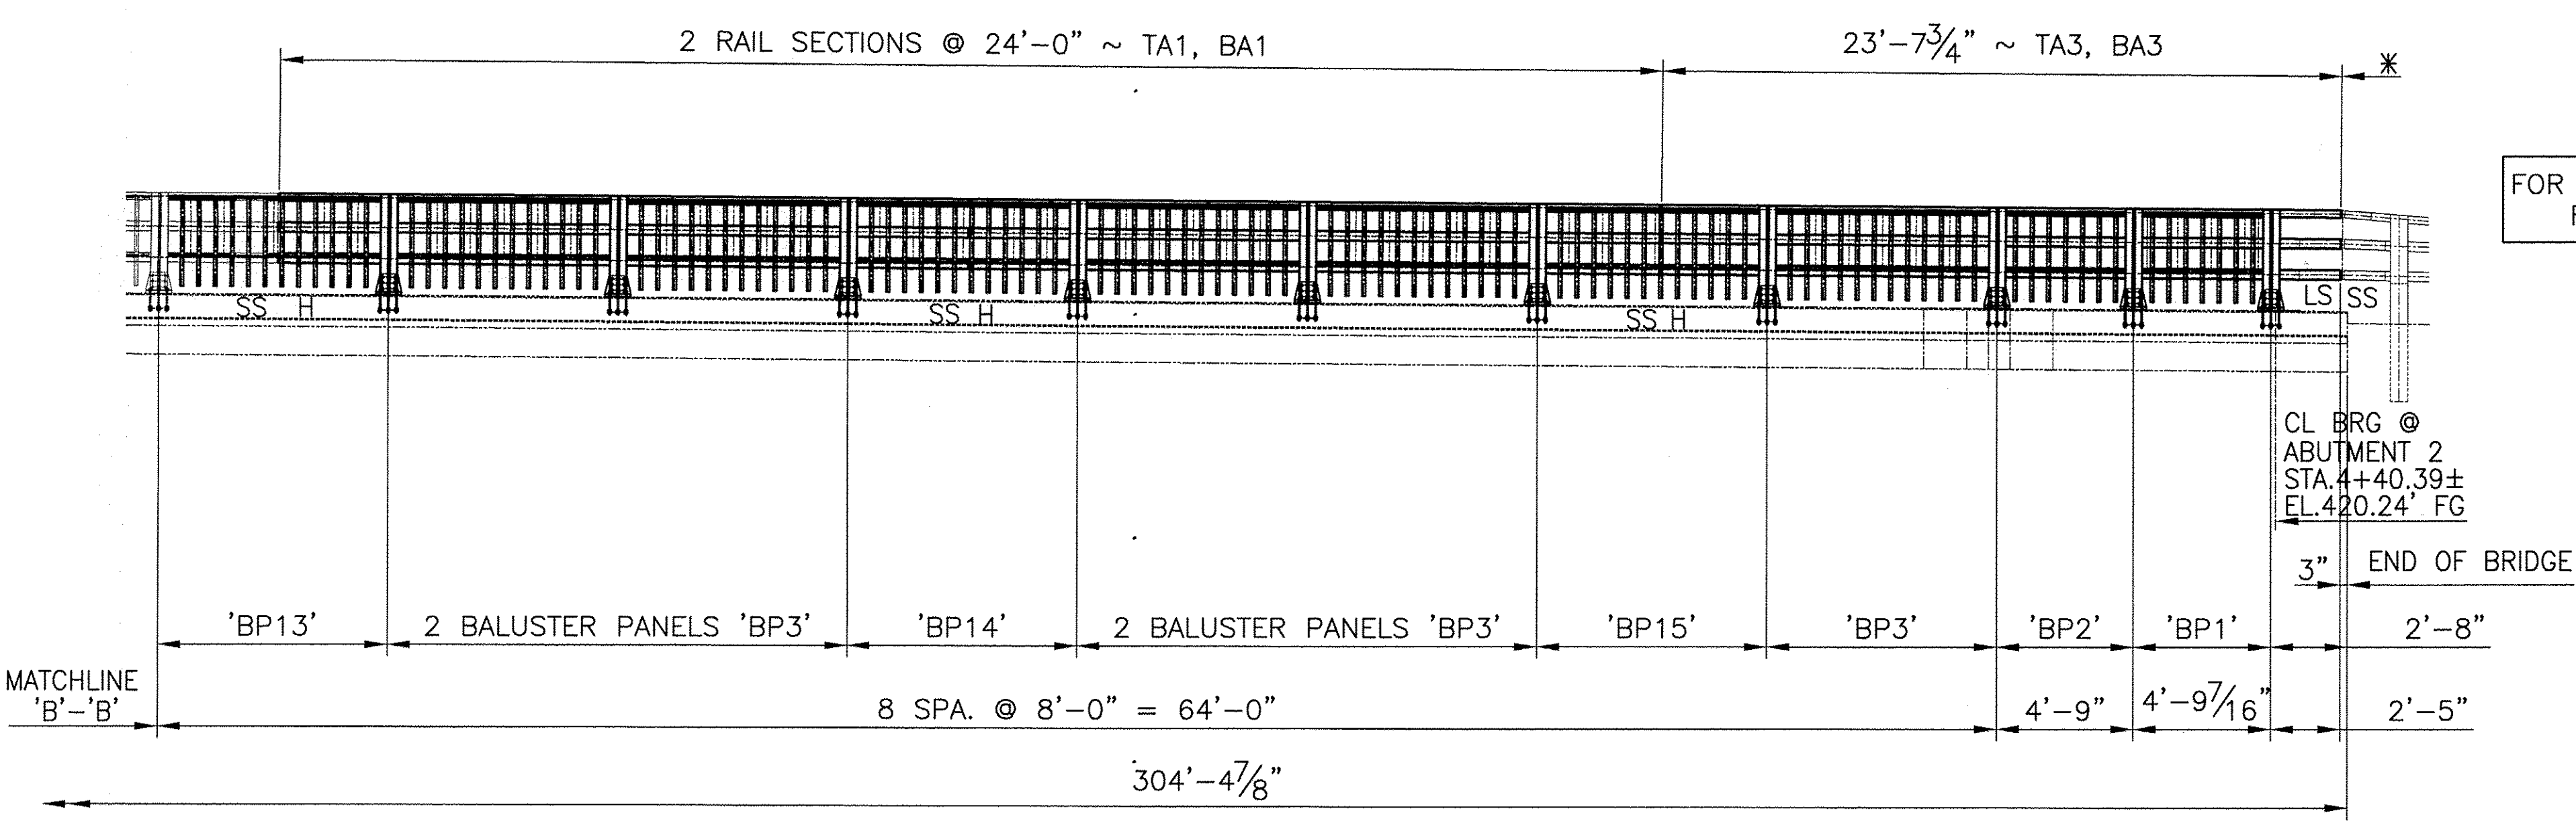

**ANODIZED**  
 (SEE LB1 FOR SPECIFICATIONS)

OUTSIDE ELEVATION ~ SIDEWALK SIDE

BRIDGE No. 30  
 PROJECT No. BHF 0283 (9) S ITEM No: 525.235

|  |  |
|--|--|
| APPROVED: _____  | REC'D APPROVAL _____                               |
| <b>L.B. FOSTER COMPANY</b><br>1016 GREENTREE ROAD<br>PITTSBURGH, PENNSYLVANIA 15220  |  |
| FOR: A.D. ROSSI CORPORATION<br>VERMONT AGENCY OF TRANSPORTATION<br>TOWN OF BERKSHIRE, COUNTY OF FRANKLIN<br>3-LINE SEMI-ELLIP. ALUM. BRIDGE RAIL FOR VT RTE 118<br>ELEVATION ~ SIDEWALK SIDE |  |
| MADE CMS DATE 02/14/10 JOB No. AR0624 CUST. No. _____  | CHECK BLJ DATE 02/25/10 DRAWING LB3 REV. No. _____ |

| REV. | DESCRIPTION | BY | DATE |
|------|-------------|----|------|
|      |             |    |      |
|      |             |    |      |