
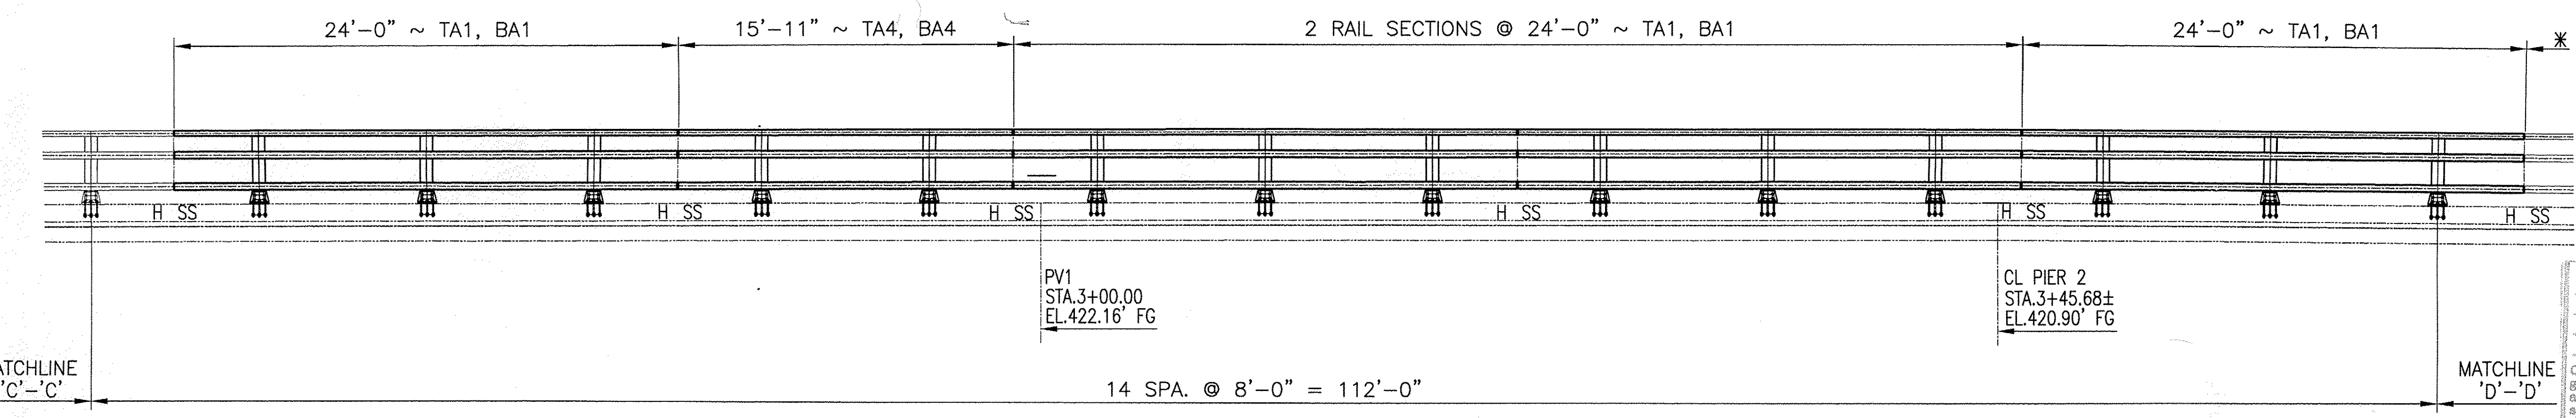



Curbside?
FOR SIDEWALK APPROACH RAILING SEE LB9

H = HOLE SIDE
SS = SHORT SLOTTED SIDE
LS = LONG SLOTTED SIDE

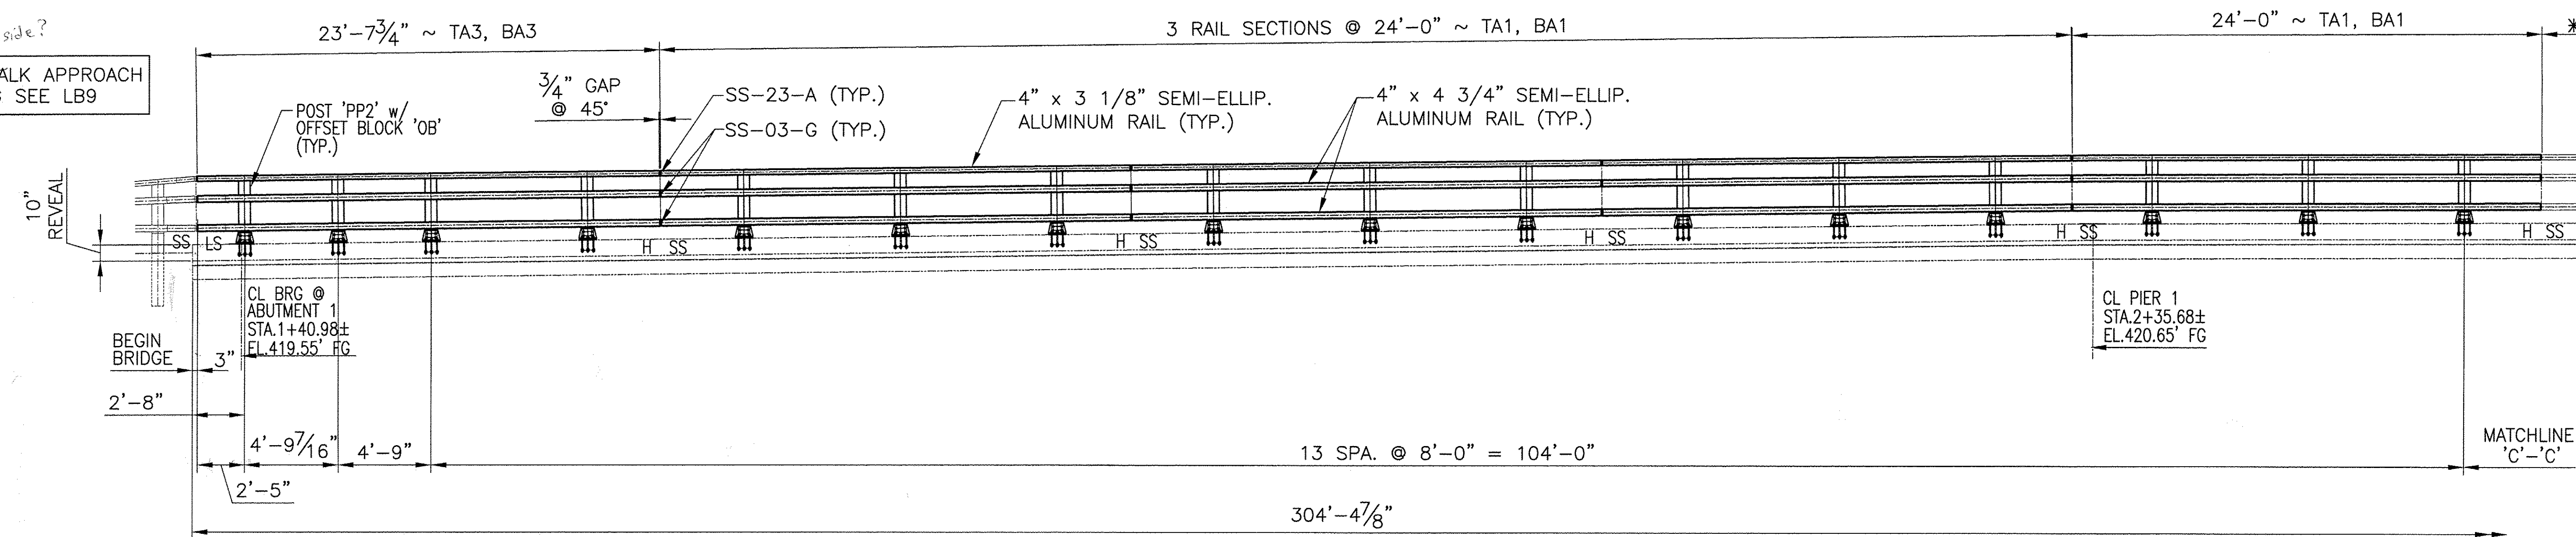

NO Discrepancies Found
X Make Correction as Noted
Substit Specified Item
Revise and Resubmit as Noted
Rejected
Checking is for general compliance with the design concept of the project and general compliance with the information given in the contract documents only. Any action shown is not an approval and is subject to the requirements of the plans and specifications. Any action shown on a specific item shall not indicate the checking of an assembly of which the item is a component. Contractor is solely responsible for dimensions which shall be confirmed and correlated at the job site, fabrication processes, techniques of construction, safety precautions, and coordination of its work with that of all other trades and the satisfactory performance of its work.
Reviewed By: Shanta Keller Date: 5/21/10

- NOTE:
- THIS CONTRACT IS BASED UPON THE CONTRACTOR SETTING AND SPACING THE ANCHOR BOLTS TO THE MEASUREMENTS SHOWN ON THE APPROVED SHOP DRAWINGS. THE L.B. FOSTER CO. WILL NOT BE RESPONSIBLE FOR WORK NECESSITATED BY ANY OTHER SETTING AND SPACING.
 - THIS DRAWING IS NOT TO SCALE.
 - FOR GENERAL NOTES AND TYPICAL DETAILS SEE DRAWING LB1.
 - LENGTH OF RAILING ON THIS SHEET IS 305 LF. PAY LENGTH.
 - POST SPACING IS MEASURED HORIZONTALLY ALONG O/S EDGE OF PARAPET.
 - SPLICE GAP AT SLEEVE = 3/4" TYP.
 - * RAIL LENGTHS DO NOT INCLUDE GAPS.
 - * COMPENSATION FOR VERTICAL CURVE IS INCLUDED IN THE RAIL LGTHS.

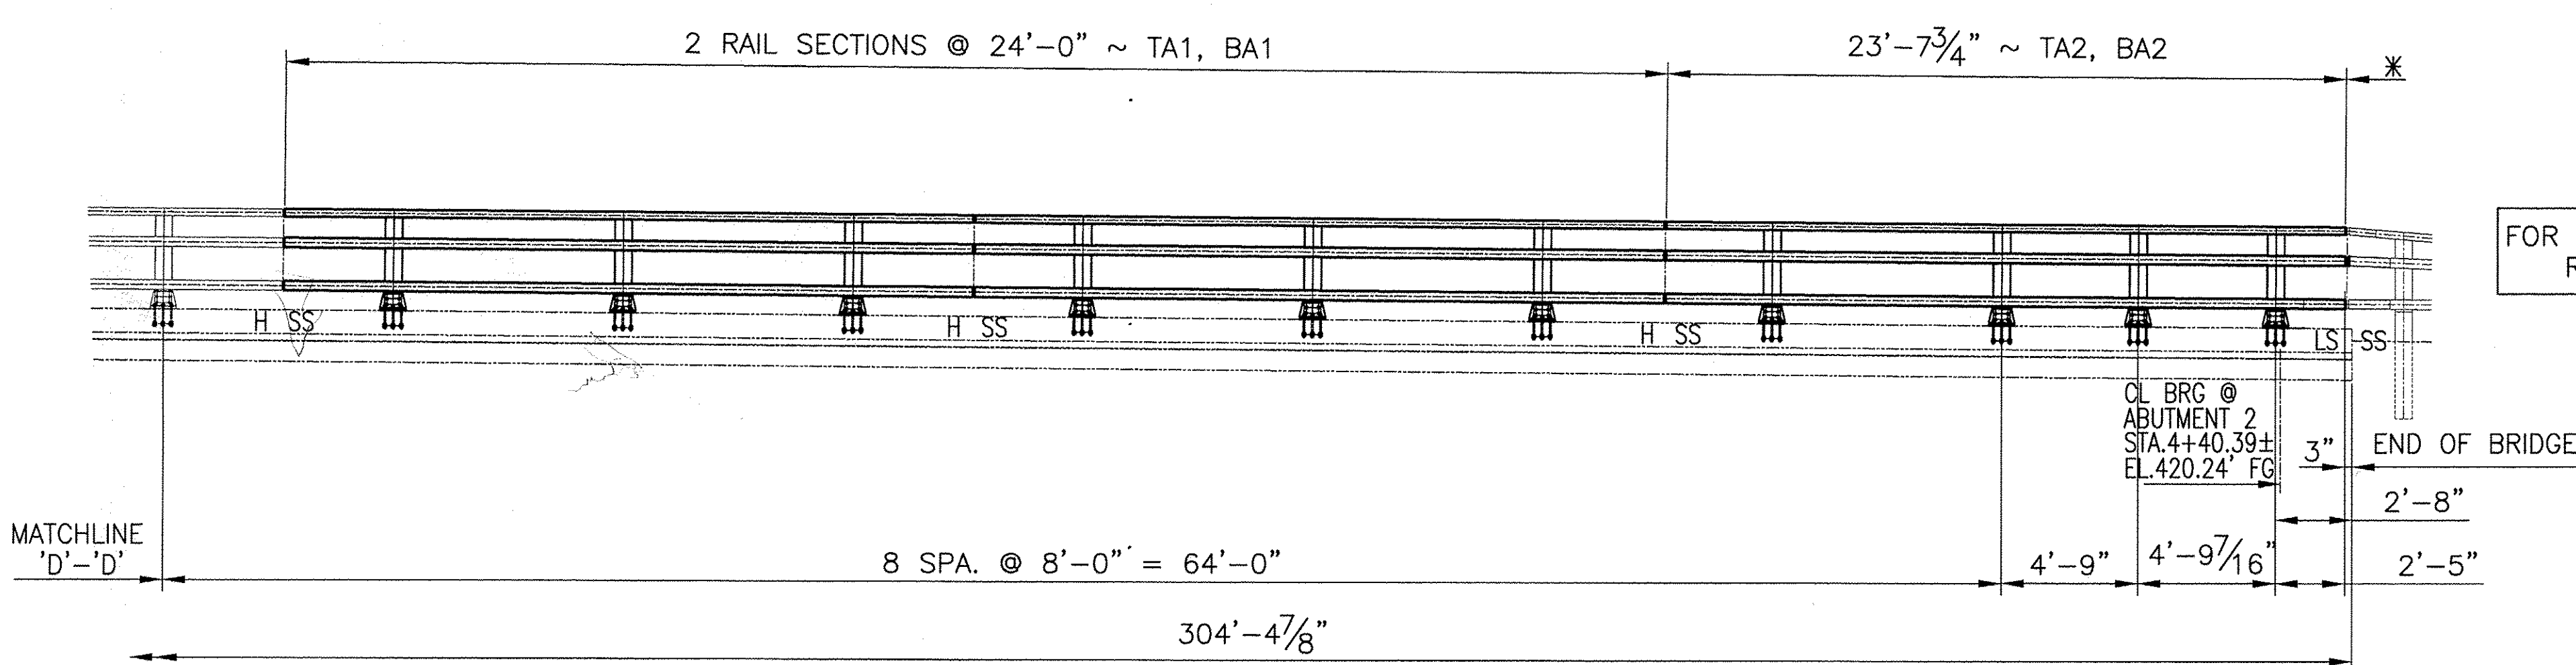

Curbside?
FOR SIDEWALK APPROACH RAILING SEE LB9

ANODIZED
(SEE LB1 FOR SPECIFICATIONS)

INSIDE ELEVATION ~ CURBSIDE

BRIDGE No. 30
PROJECT No. BHF 0283 (9) S
ITEM No: 525.225

APPROVED: _____ REC'D APPROVAL _____
DRAWING _____

L.B. FOSTER COMPANY
1016 GREENTREE ROAD
PITTSBURGH, PENNSYLVANIA 15220

FOR: A.D. ROSSI CORPORATION
VERMONT AGENCY OF TRANSPORTATION
TOWN OF BERKSHIRE, COUNTY OF FRANKLIN
3-LINE SEMI-ELLIP. ALUM. BRIDGE RAIL FOR VT RTE 118
ELEVATION ~ CURBSIDE

MADE CMS DATE 02/16/10 JOB No. AR0624 CUST. No. _____
CHECK BLJ DATE 02/25/10 DRAWING LB4 REV. No. _____

| REV. | DESCRIPTION | BY | DATE |
|------|-------------|----|------|
| | | | |