



STATE OF VERMONT AGENCY OF TRANSPORTATION

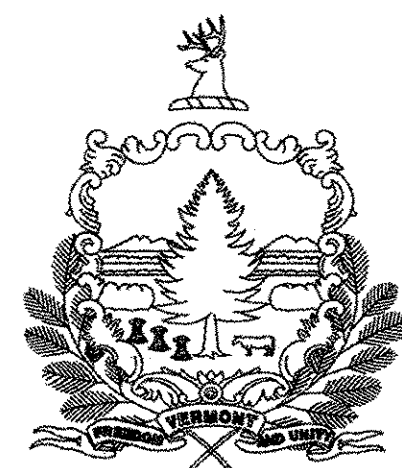

PROPOSED IMPROVEMENT BRIDGE PROJECT TOWN OF MONTGOMERY COUNTY OF FRANKLIN VT. ROUTE 118 - MAJOR COLLECTOR BRIDGE NO. 21

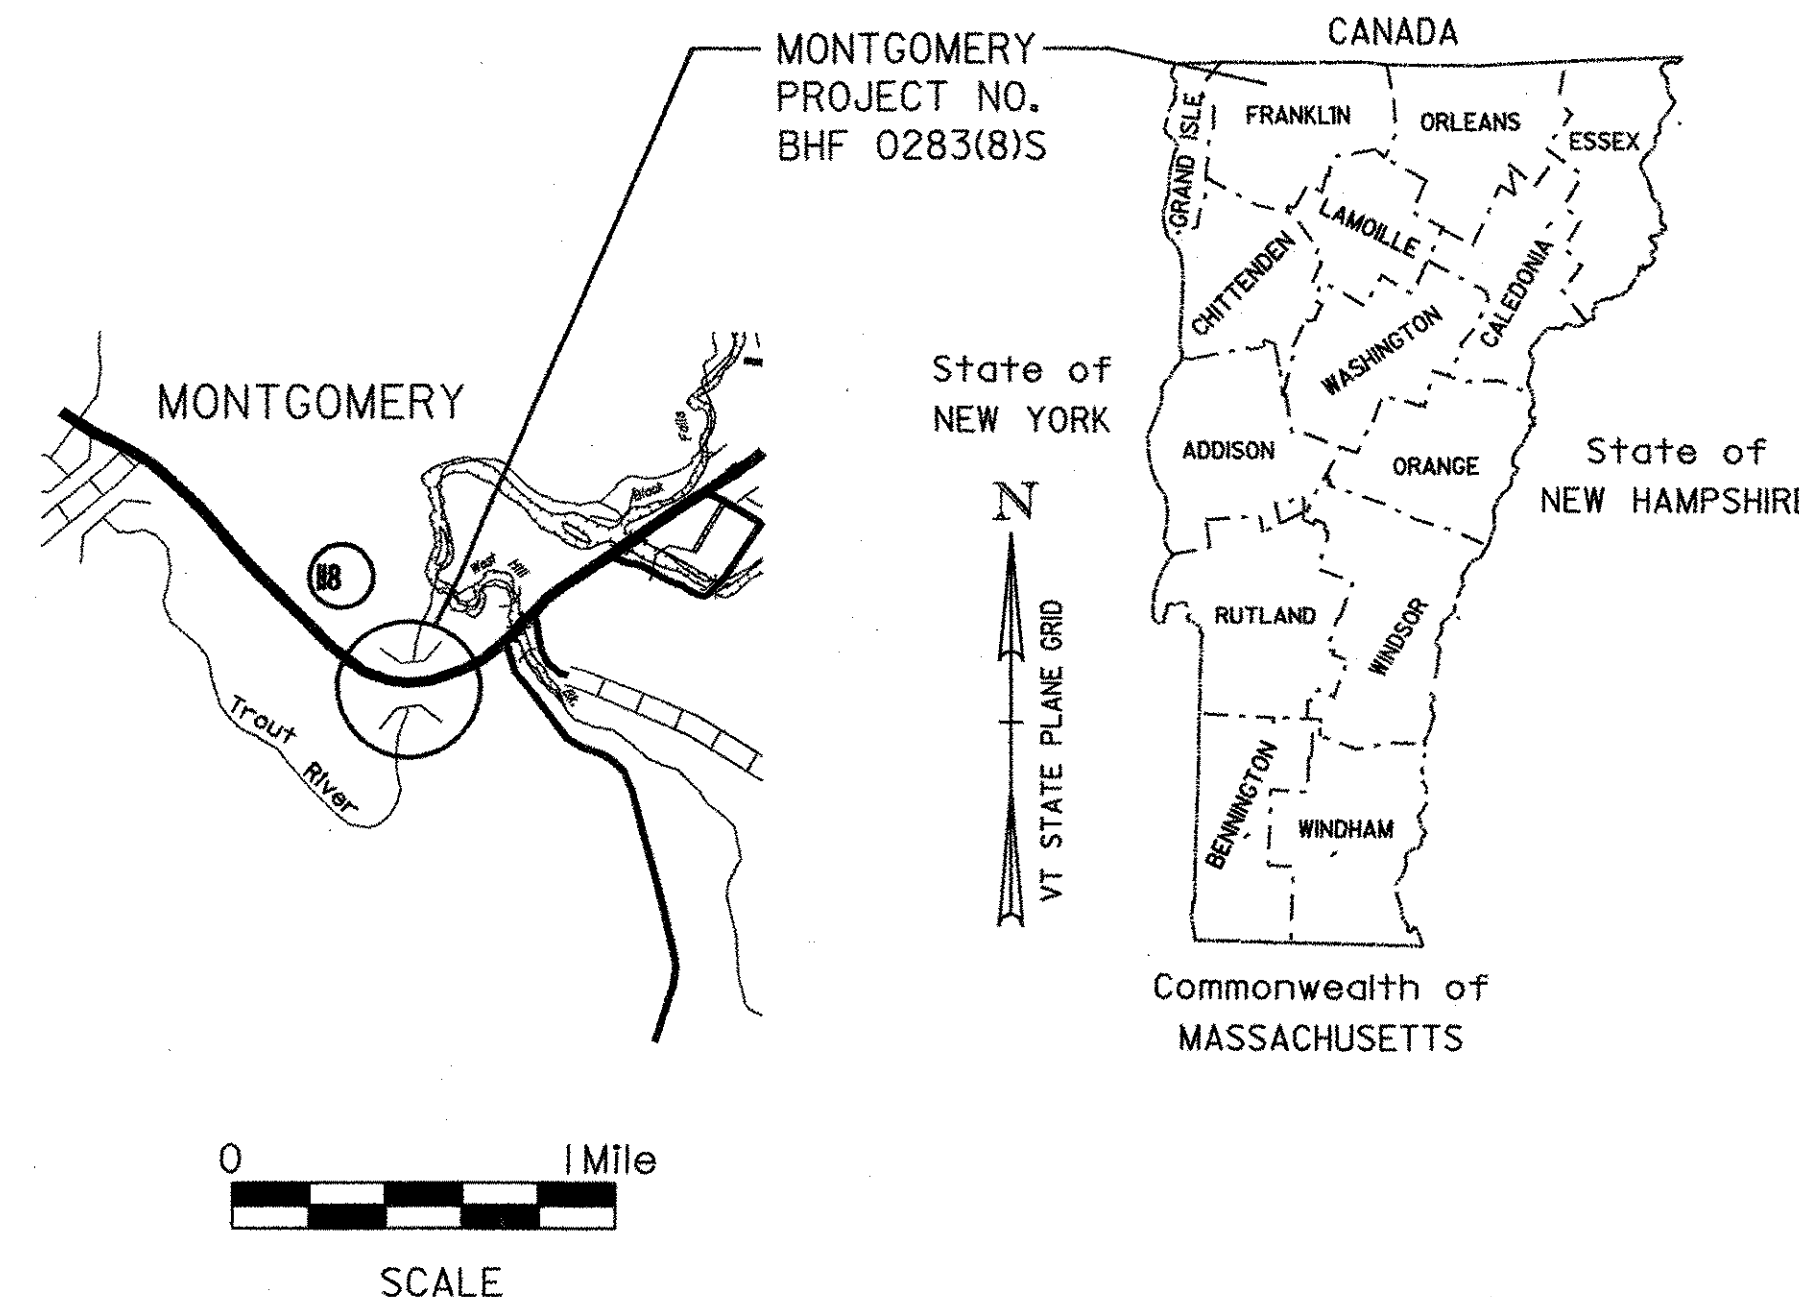

PROJECT LOCATION

BEGINNING AT A POINT APPROXIMATELY 2.94 MILES NORTHERLY
OF THE JUNCTION VT 242 AND EXTENDING NORTHERLY ALONG
VT ROUTE 118 FOR A DISTANCE OF 0.066 MILES.

STRUCTURE LENGTH: 187 FEET
ROADWAY LENGTH: 163 FEET
PROJECT LENGTH: 350 FEET

PROJECT DESCRIPTION


INSTALL TRAFFIC CONTROL, RECONSTRUCT APPROACHES,
REHABILITATE BRIDGE, PAINT BRIDGE AND REMOVE TRAFFIC CONTROL.

RECORD PLANS	
CONTRACTOR:	AL ST. ONGE CONSTRUCTION, INC - MONTGOMERY, VT.
RESIDENT ENGINEER:	CARL GLEASON
CONSTRUCTION BEGAN:	APRIL 12, 2006
CONSTRUCTION COMPLETE:	SEPTEMBER 21, 2007
RECORD PLANS BY:	CARL GLEASON & CHIP PIERCE
I HEREBY CERTIFY THAT ALL THE CONSTRUCTION REQUIRED BY THIS SET OF DRAWINGS HAS BEEN ACCOMPLISHED AS INDICATED HEREIN.	
BY:	<i>Carl Gleason</i> RESIDENT ENGINEER
DATE:	5/22/08
NOTE: Any further information concerning final quantities, amounts or other details relative to this project may be found at Central Files in the electronic archives.	

CONVENTIONAL SYMBOLS	
COUNTY LINE	
TOWN LINE	
LIMITS OF ACCESS	
POINT OF ACCESS	
FENCE LINE	
STONE WALL	
TRAVELED WAY	
GUARD RAIL	
RAILROAD	
SURVEY LINE	
CULVERT	
POWER POLE	
TELEPHONE POLE	
TREES	
CONTROL OF ACCESS	
PROPERTY LINE	
R.O.W. TAKING LINE	
SLOPE RIGHTS	
TOP OF CUT	
TOE OF SLOPE	


SURVEYED BY : R. GILMAN
SURVEYED DATE : JUNE 24, 2000

DATUM
VERTICAL NAVD 88
HORIZONTAL NAD 83

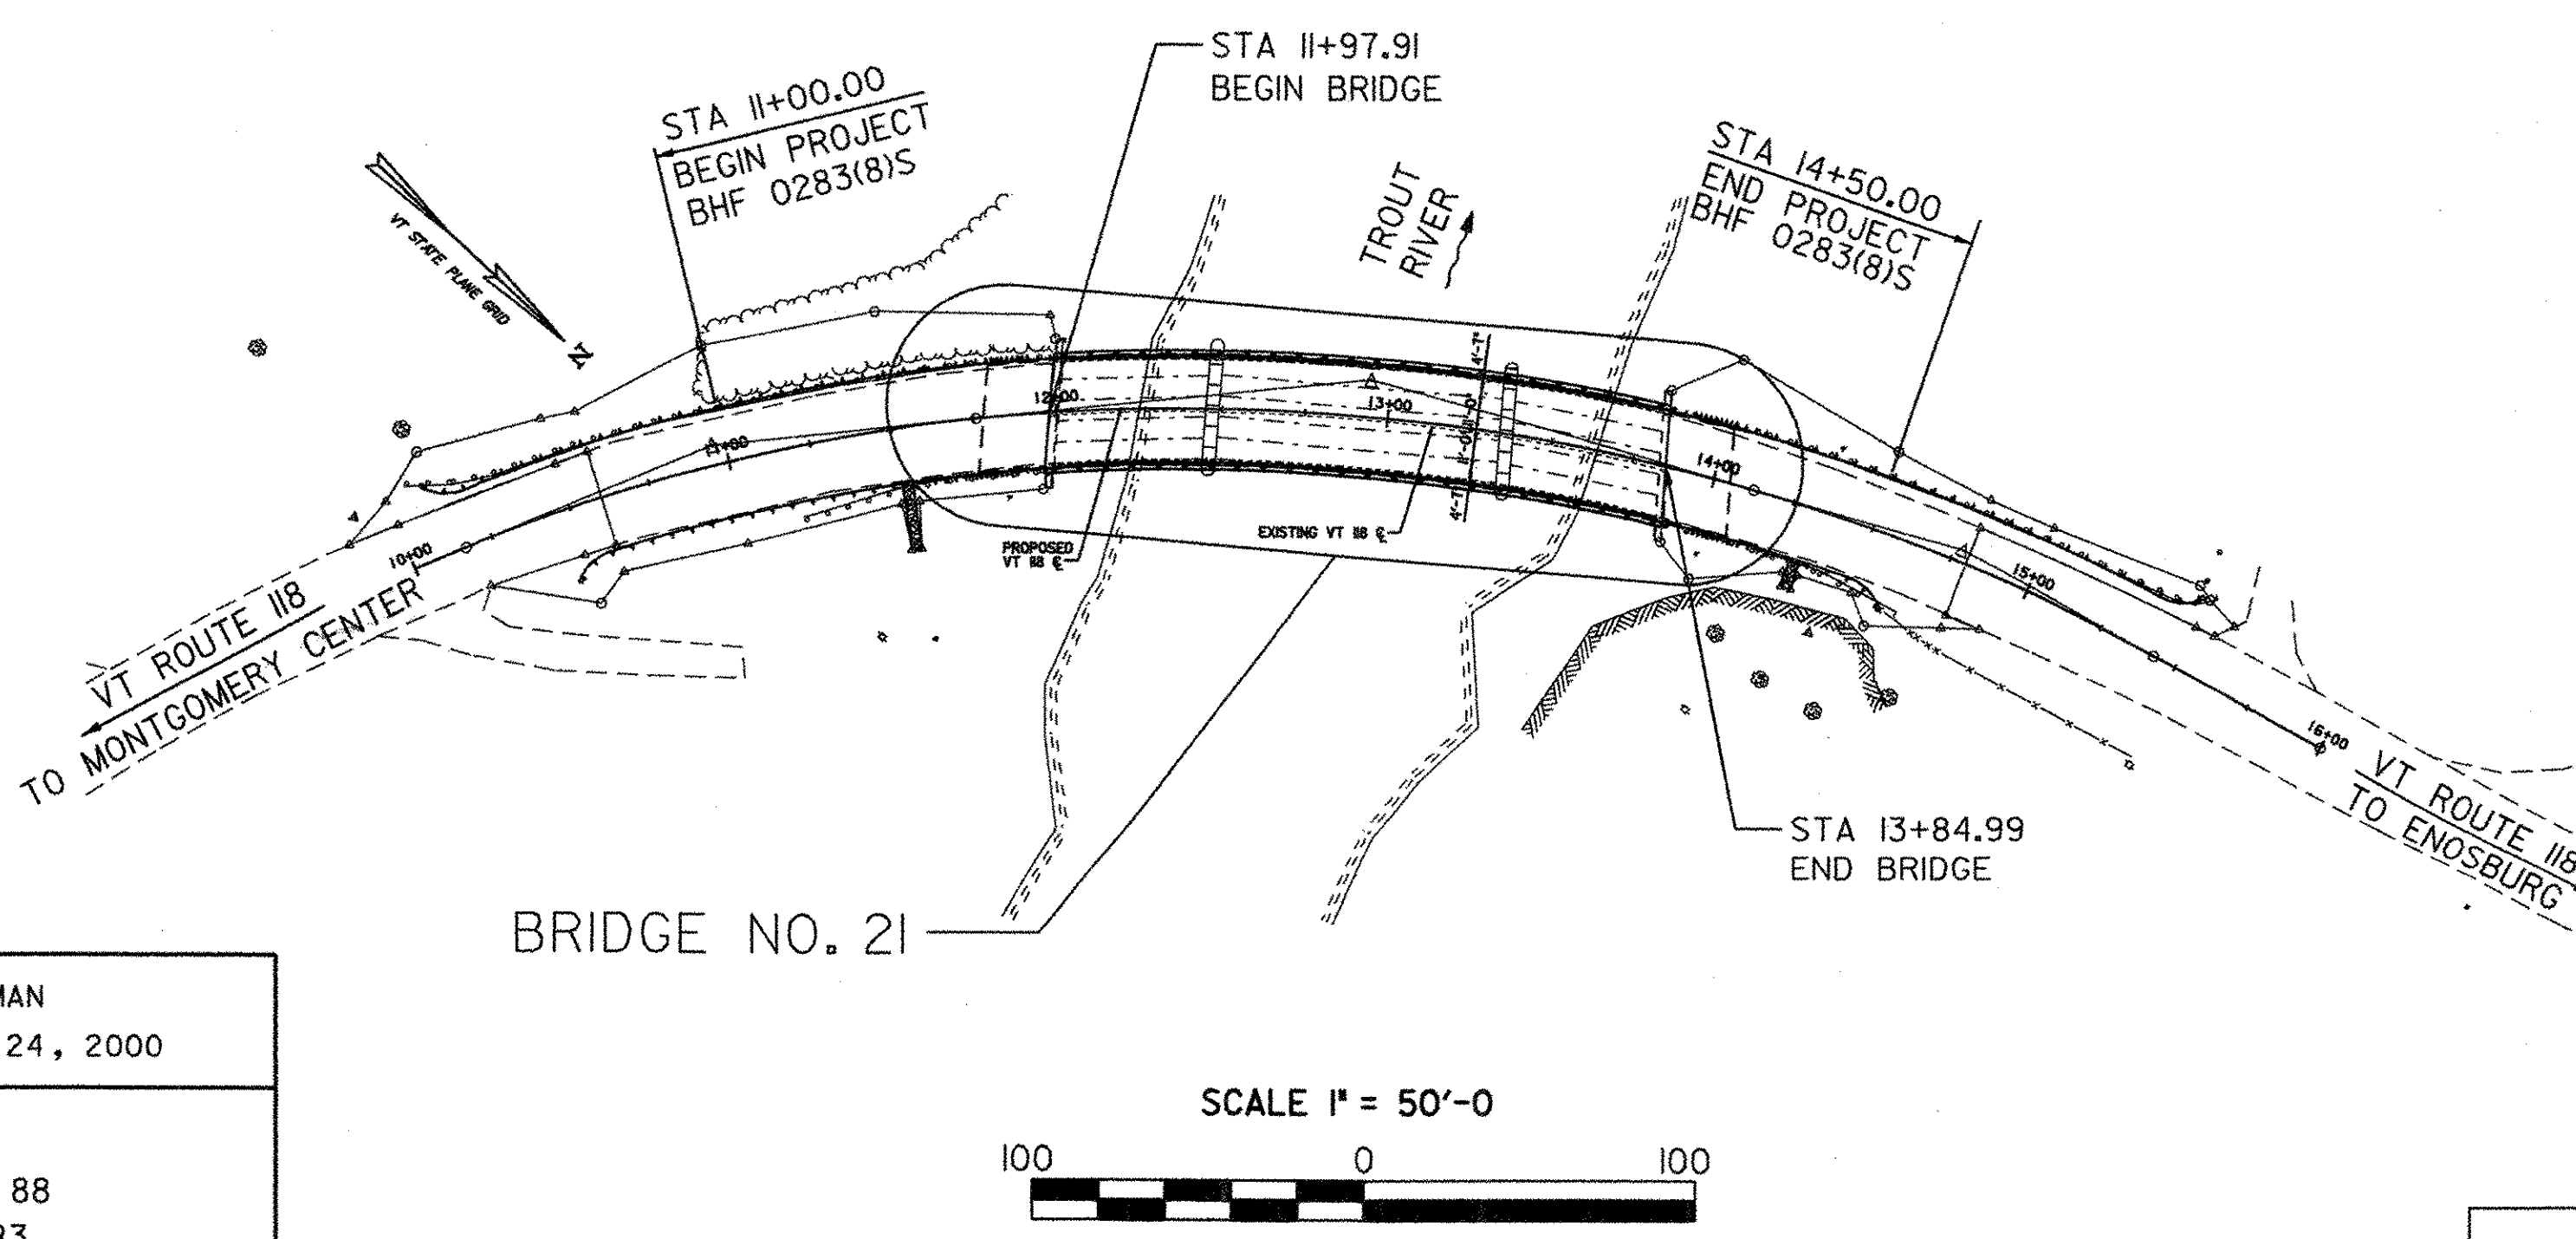

THESE PLANS ARE SUBJECT TO SUCH ENGINEERING CHANGES AS MAY BE REQUIRED BY THE FEDERAL HIGHWAY ADMINISTRATION OR THE DIRECTOR OF PROJECT DEVELOPMENT.

CONSTRUCTION IS TO BE CARRIED ON IN ACCORDANCE WITH THESE PLANS AND THE STANDARD SPECIFICATIONS FOR CONSTRUCTION DATED 2001, AS APPROVED BY THE FEDERAL HIGHWAY ADMINISTRATION ON JANUARY 4, 2001 FOR USE ON THIS PROJECT, INCLUDING ALL SUBSEQUENT REVISIONS AND SUCH REVISED SPECIFICATIONS AND SPECIAL PROVISIONS AS ARE INCORPORATED IN THESE PLANS.

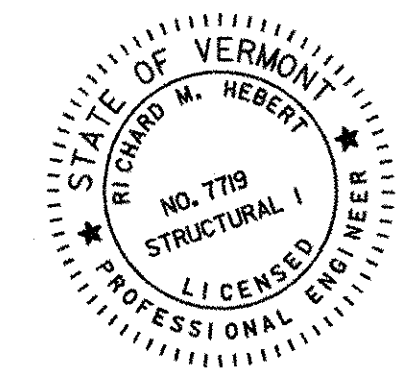

DIRECTOR OF PROGRAM DEVELOPMENT	
APPROVED <i>Richard M. Hebert</i>	DATE 9/21/05
PROJECT MANAGER : ROGER WHITCOMB	
PROJECT NAME : MONTGOMERY	
PROJECT NUMBER : BHF 0283 (8) S	
SHEET 1 OF 45 SHEETS	

zc316t11.dgn zc316t11.i PLOTTED 19-SEP-2005
TYLINTERNATIONAL