
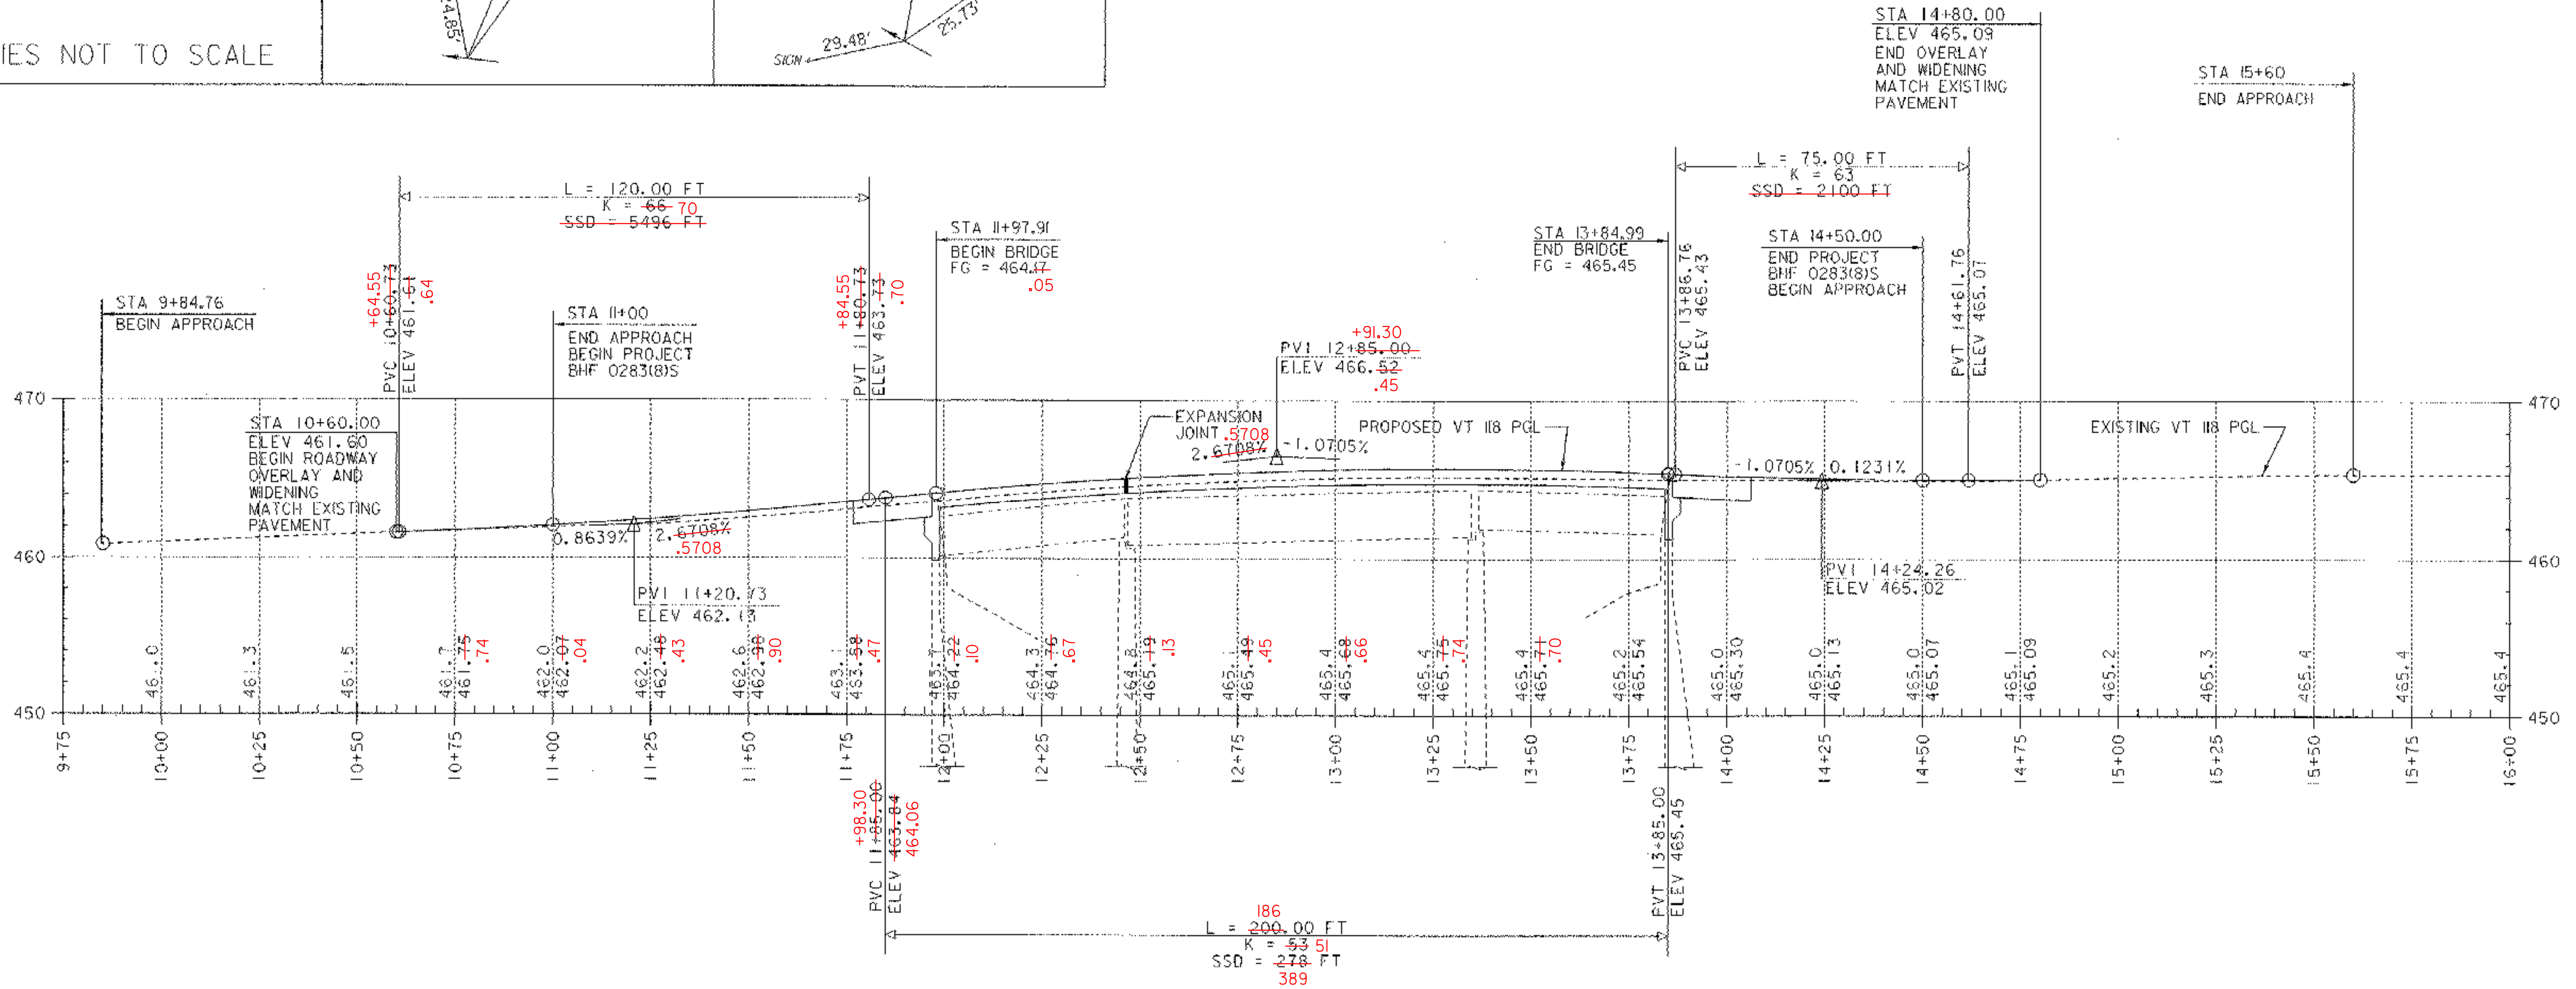
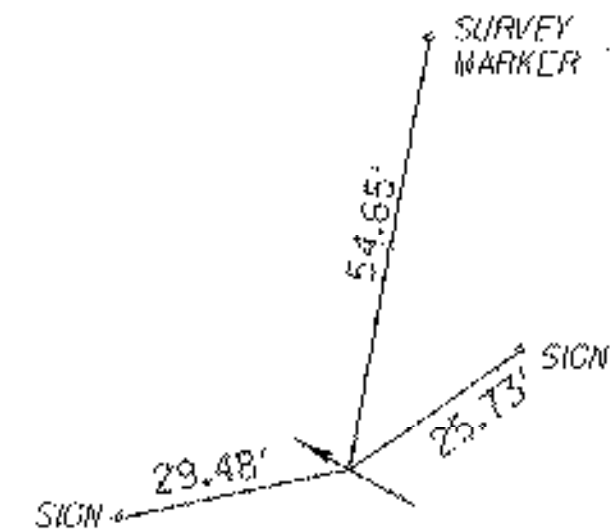



TIES NOT TO SCALE

PCC STA 11+75.72

PCC STA 14+12.55

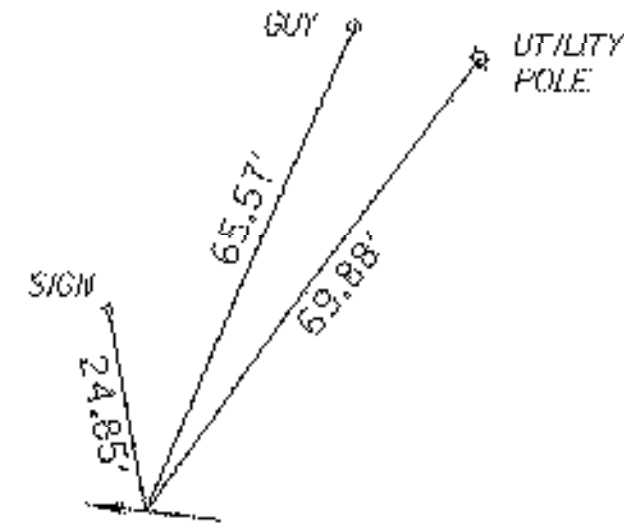


VT 118 PROFILE

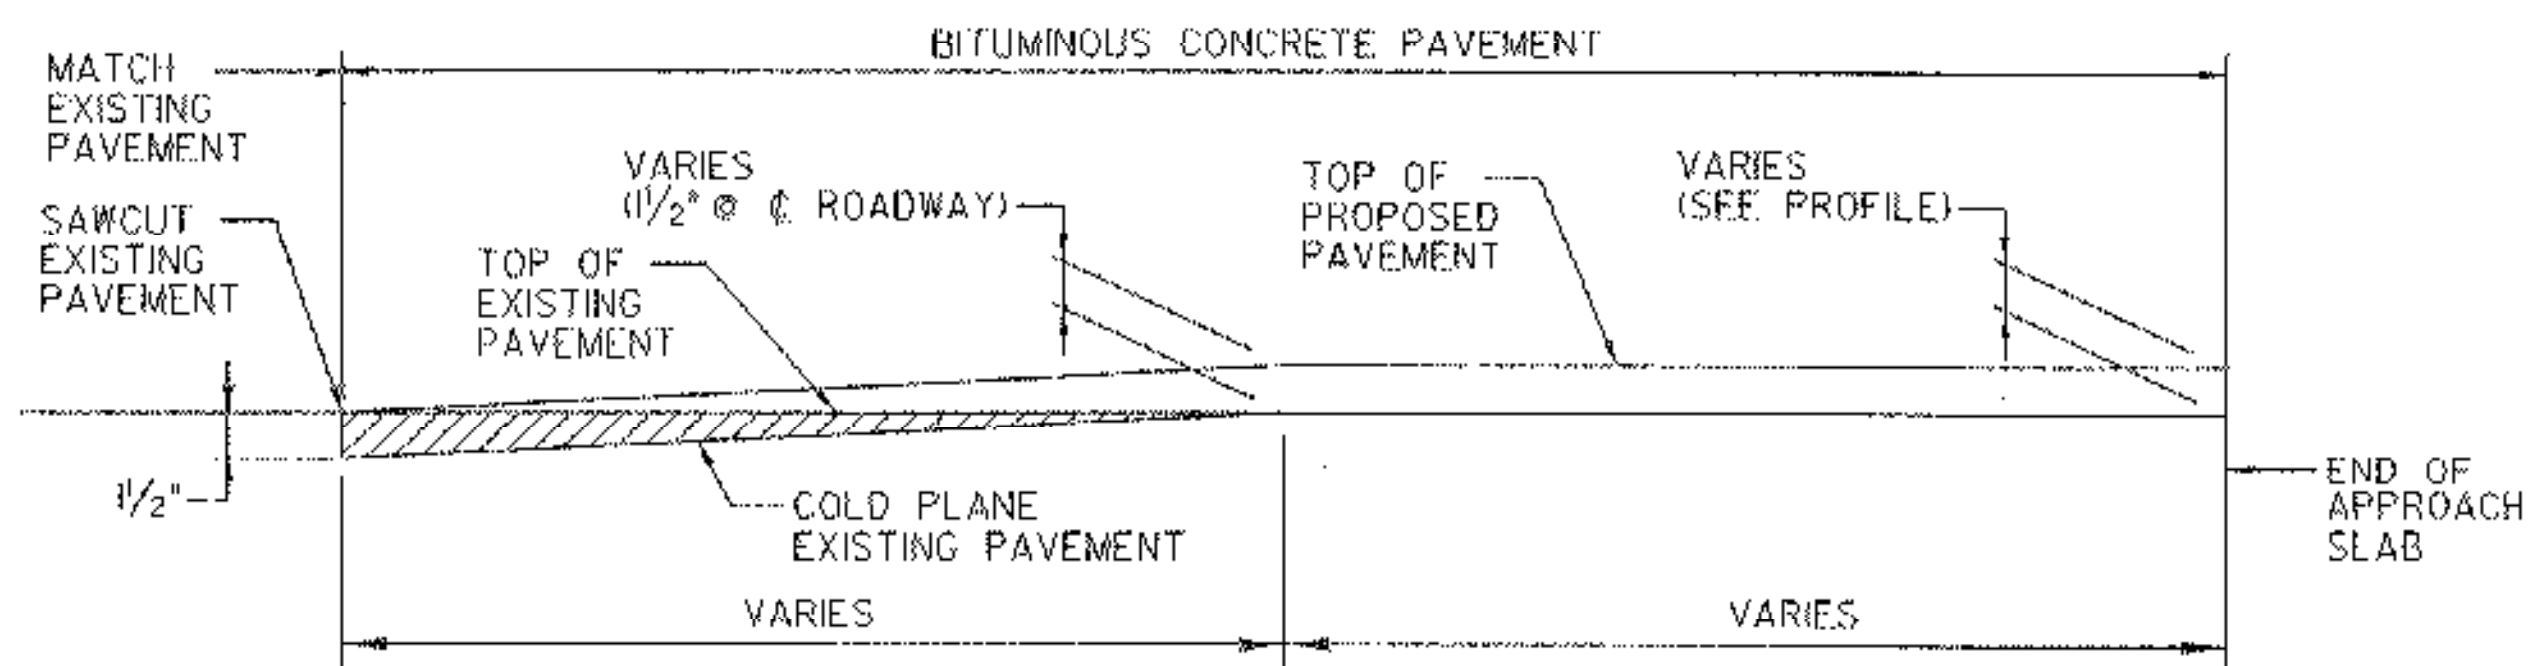

APPROACH PAVEMENT TRANSITION DETAIL

NOT TO SCALE

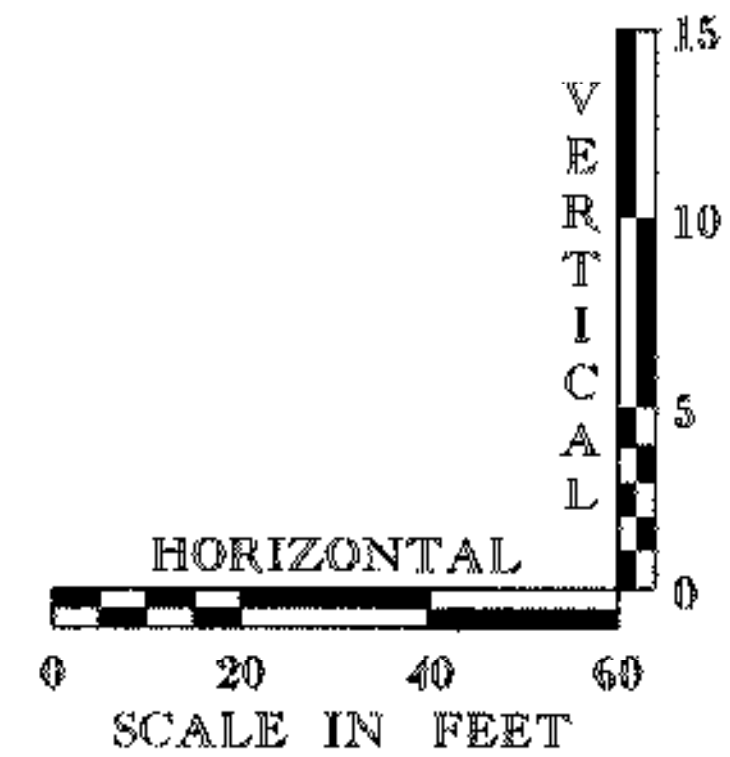

REVISED VERTICAL ALIGNMENT 3/13/06

TYLINTERNATIONAL

STATE OF VERMONT  
AGENCY OF TRANSPORTATION

Town Of	MONTGOMERY	Bridge No.	21
Highway No.	VT 118	Log Sta.	
VT 118 OVER TROUT RIVER			
PROFILE, TIES AND DETAILS			
Designed By	D. Bryant	Drawn By	J. Davis
Checked By	J. Andrews	Date	08/31/01
		Bridge Design Supervisor	R. WHITCOMB
PROJECT	MONTGOMERY	PROJECT NO.	BHF 0283(8)S
I.C.G. Info.			ZC316PRI.DGN
Bridge Sheet No.		Sheet	7 of 45