


**PLAN**  
SCALE 1" = 10'-0"

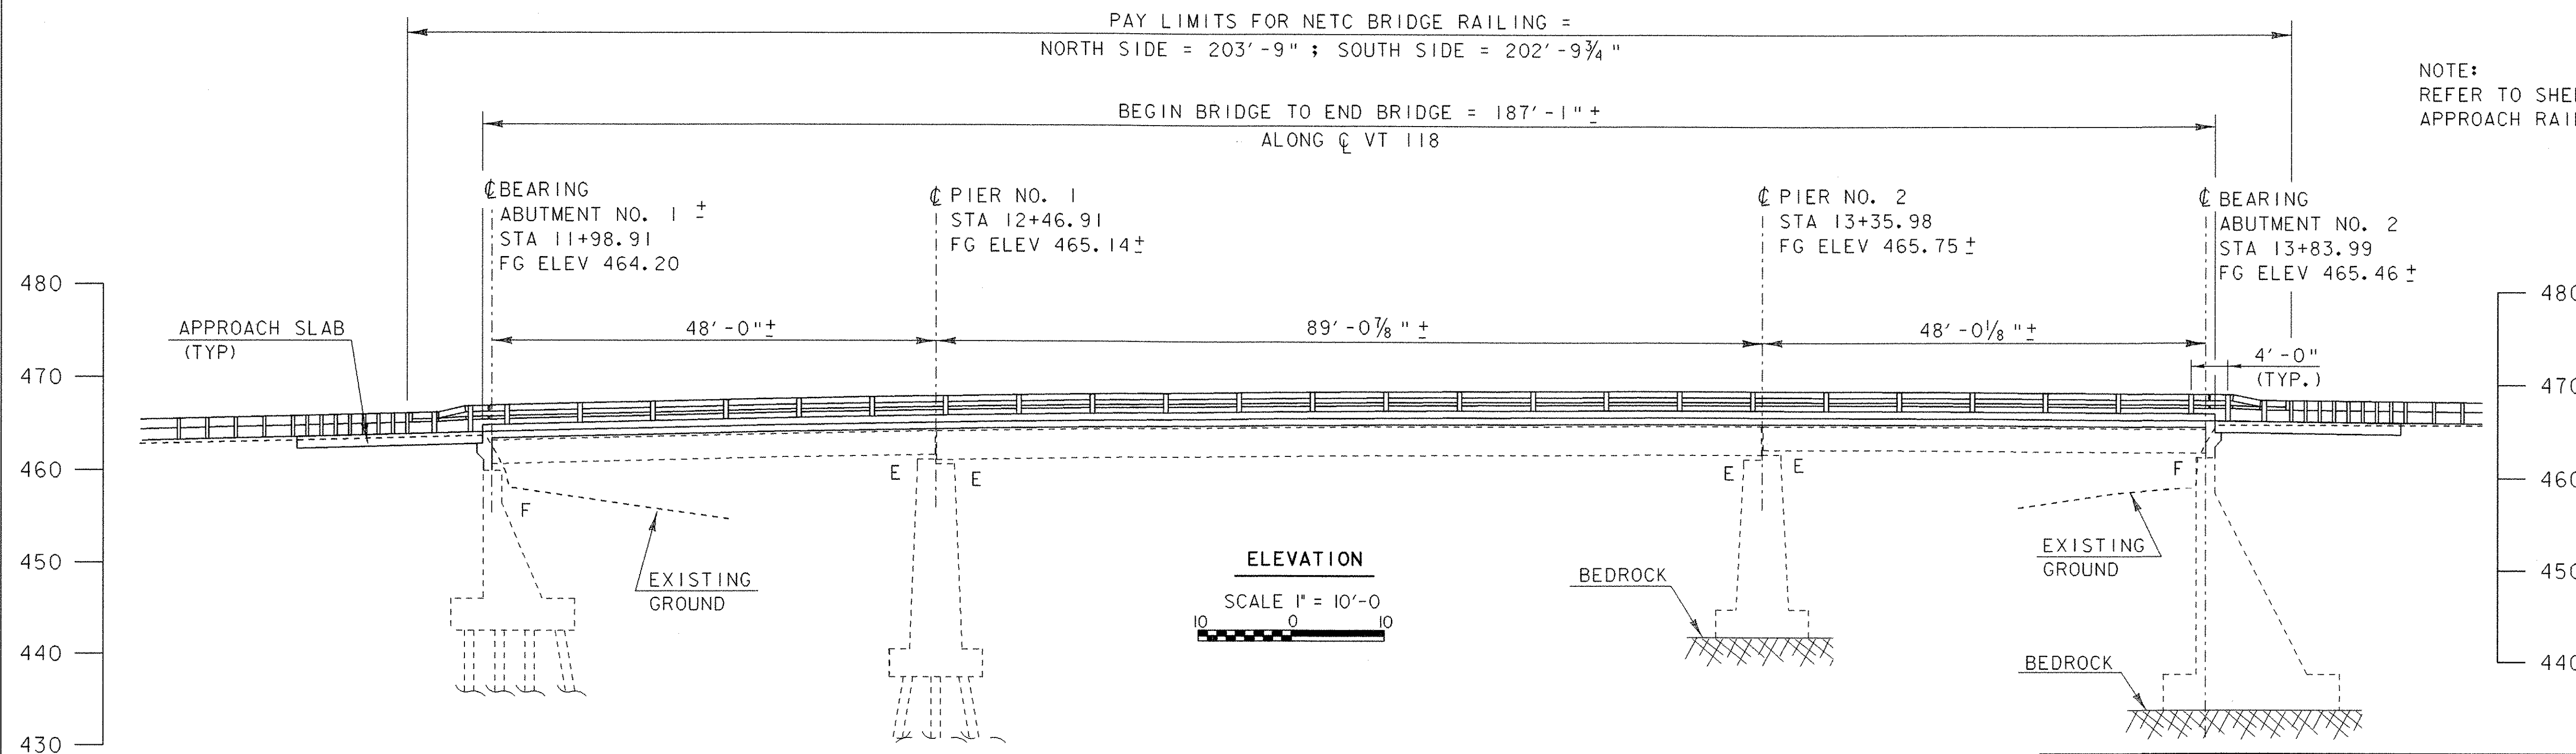

**ELEVATION**  
SCALE 1" = 10'-0"

NOTE:  
REFER TO SHEETS 32 AND 33 FOR BRIDGE RAIL AND  
APPROACH RAIL LAYOUT AND DETAILS.

<b>STATE OF VERMONT AGENCY OF TRANSPORTATION</b>	
Town Of <b>MONTGOMERY</b>	Bridge No. <b>21</b>
Highway No. <b>VT 118</b>	Log Sta. Surv. Sta.
<b>VT 118 OVER TROUT RIVER</b>	
<b>GENERAL PLAN AND ELEVATION</b>	
Designed By <b>J. Howe</b>	Drawn By <b>J. Davis</b>
Checked By <b>R. Hebert</b>	Bridge Design Supervisor <b>R. WHITCOMB</b>
Date <b>08/31/01</b>	Date
PROJECT <b>MONTGOMERY</b>	PROJECT NO. <b>BHF 0283(8)S</b>
I.G.C. Info.	<b>ZC316PE1DGN</b>
Bridge Sheet No.	Sheet <b>12</b> of <b>45</b>

**TYLIN INTERNATIONAL**