


DATUM	
VERTICAL	NAVD 88
HORIZONTAL	NAD 83

LEGEND	
	EXPOSED LEDGE

SEE CROSS SECTION SHEETS FOR FINAL GRADING

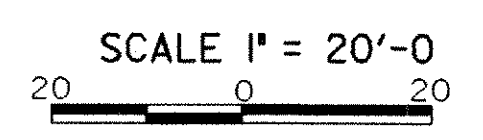

SHEET NAME: FINAL CONDITIONS SITE PLAN	
PROJECT NAME: MONTGOMERY	HIGHWAY NO.: VT 118
PROJECT NUMBER: BHF 0283(8)	BRIDGE NO.: 21
	OVER: TROUT RIVER
FILE NAME: /PW/98c316/sc316ec.dgn	PLOT DATE: 20-DEC-2005
PROJECT MANAGER: R. WHITCOMB	DRAWN BY: J. GILMORE
DESIGNED BY: STRI	IPARM NAME: se045ec4.1
	SHEET 16 OF 45